

APPLICATION

SEWAGE DISPOSAL TESTING

STATE OF MARYLAND - DEPARTMENT OF HEALTH AND MENTAL HYGIENE

HOWARD COUNTY HEALTH DEPARTMENT
ENVIRONMENTAL HEALTH SERVICES
P. O. BOX 476 ELLICOTT CITY, MARYLAND 21043
TELEPHONE: 992-2330

A 33498

P _____

DISTRICT 5

DATE 1-30-84

TO: THE COUNTY HEALTH OFFICER
ELLICOTT CITY, MARYLAND

I, HEREBY, APPLY FOR THE NECESSARY TEST IN ORDER TO CONSTRUCT (OR RECONSTRUCT) A SEWAGE DISPOSAL SYSTEM

PROPERTY OWNER ANNA M.A. CROTTY ^{MARSHA GADDER} Highland Development Corp.

ADDRESS 4100 Cathedral Ave DC 20016 PHONE 702-363-2725

PROPERTY LOCATION: BRIGHTON PINES I

SUBDIVISION Propert prop LOT NO. 10

ROAD AND DESCRIPTION Nicholes Dr 13757 13736 Lakeside Drive

SIZE OF LOT 3A TYPE BLDG. SFD
(NUMBER OF BEDROOMS)

THE SYSTEM INSTALLED UNDER THIS APPLICATION IS ACCEPTABLE ONLY UNTIL PUBLIC FACILITIES BECOME AVAILABLE. I FULLY UNDERSTAND THE FEE CONNECTED WITH THE FILING OF THIS PERC TEST APPLICATION IS NON-REFUNDABLE UNDER ANY CIRCUMSTANCES. I ALSO AGREE TO COMPLY WITH ALL M.O.S.H.A. REQUIREMENTS IN TESTING THIS LOT.

Patrick Hemmitt 465-0842
(SIGNATURE OF APPLICANT)

APPROVED BY C. Wilton FOR 5 NALLOW TRENCHES DATE 2-12-85

REJECTED BY _____ FOR _____ DATE _____

HOLD PENDING FURTHER TESTS _____ DATE _____

REASONS FOR REJECTION OR HOLDING _____



BLDG. PERMIT SIGNED
AND RETURNED 9-9-85
Serial # B M 11397A
SFD - 4 Bed

BLDG. PERMIT SIGNED
AND RETURNED 7/5/89
Serial # 27010
SFD - 3 Bedrooms

THIS IS NOT A PERMIT


1-4-5-6-7

SOIL PROFILE

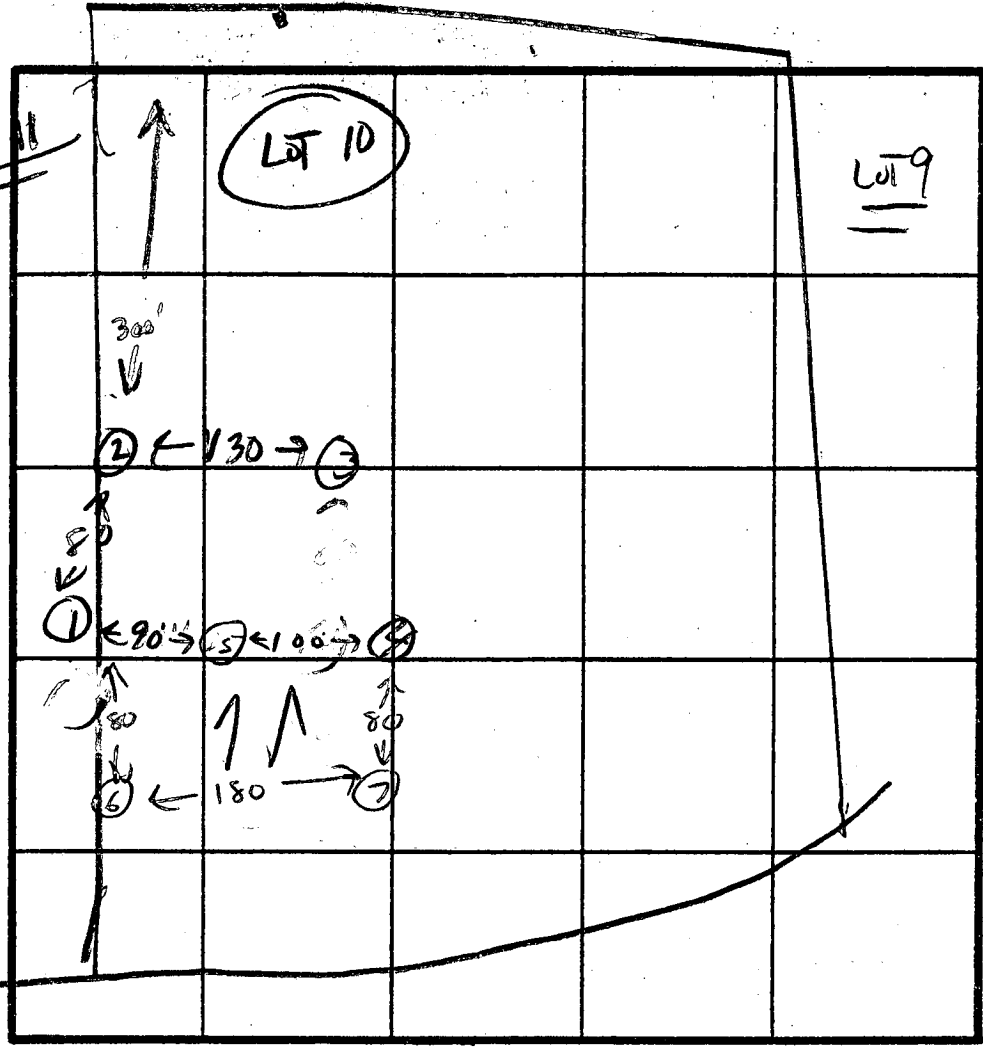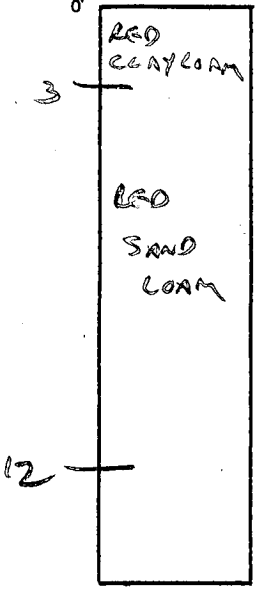

INDICATE NORTH - NAME ADJOINING ROADWAY AS BASE LINE.

#243

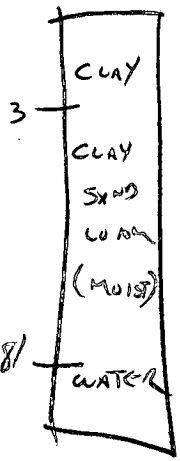

DATE	TEST NO.	DEPTH	PRE-WET		TEST - 1" DROP		TIME
			START	STOP	START	STOP	
3-2-84	1	4	2:01	2:09	2:09	2:21	12 MIN
		8	2:01	2:05	2:03	2:05	2 MIN
		12					
3-2-84	2	8'	CLAY SAND LOAM - WGT AT 8'				X
3-2-84	3	8	CLAY SAND LOAM - WATER AT 8'				X
3-2-84	4	4	2:21	2:26	2:26	2:34	8 MIN
		8	2:21	2:23	2:23	2:25	2 MIN
		12	RED SAND LOAM				
3-2-84	6	4 8,12	3:12	3:15	3:15	3:19	4 MIN
3-2-84	7	4 8,12	3:12	3:15	3:15	3:18	3 MIN
			RED MICA SAND LOAM				

REMARKS: 5 VISUAL SAND 2-12' (5' A ELEVATION HOLES 2-3 TO HOLES 1-5-4)

TYPE OF SOIL: SAND LOAM (HOUSE SITE LIMITED - POSSIBLY REQUIRES ADJUSTED LOT LINES)

TESTED BY: CW... ALSO PRESENT: DEAN ITT, CISELL

APPROVED PER AREA STARTS MIDWAY BETWEEN HOLES 6-7 AND HOLES 1-5-4 ∴ SHALLOW SYSTEM REQ'D.

EH-12-1079