

*4/9/70
delivered
positive
follow*

PERMIT

*4/9/70
Pastor R. Torre*

P. 15158
A. 15125

SEWAGE DISPOSAL SYSTEM

MARYLAND STATE DEPARTMENT OF HEALTH

HOWARD COUNTY

INDEXED

ELLICOTT CITY

DISTRICT 5

DATE 4/8/70

*5/22/70
Ready
Linkythorn*

Joseph Judge IS PERMITTED TO INSTALL X ALTER

ADDRESS 6349 Amherst Ave., Ellicott City, Md. PHONE 531-5512

A SEWAGE DISPOSAL SYSTEM LOCATED AT _____

SUBDIVISION Aintree Estates ROAD 6276 Linkythorn Lane LOT 7, Sec. 1

PROPERTY OWNER Capt. & Mrs. William P. Willis

ADDRESS _____

SPECIFICATIONS - 3 bedrooms

DRAIN FIELD _____ DEPTH _____ FEET, BOTTOM AREA _____ SQ. FT.

SEEPAGE PITS _____ ABSORBENT SIDE-WALL AREA _____ SQ. FT.

SEPTIC TANK CAPACITY 1,000 GALLONS

FOR GARBAGE GRINDER, INCREASE DISPOSAL AREA 22% & TANK CAPACITY 50%.

OTHER Dry well - 400 sq. ft. absorbent sidewall area to begin below the first

3 1/2 ft. non-porous soil. Maximum depth permitted for dry well is 12 ft.

Locate dry well 120 ft. off right side line and 96 ft. from rear property

line as seen from Linkythorn Lane.

NOTE: ALL PIPE FROM HOUSE TO SEPTIC TANK MUST BE CAST IRON.

PERMIT VOID AFTER THREE YEARS.


PLANS APPROVED BY Robert V. Torre DATE 3/19/70

FILL SEPTIC TANK AND DISTRIBUTION BOX WITH WATER BEFORE CALLING FOR AN INSPECTION. COVER NO WORK UNTIL INSPECTED AND APPROVED.

NEITHER THE HOWARD COUNTY COMMISSIONERS NOR THE HEALTH DEPARTMENT IS RESPONSIBLE FOR THE SUCCESSFUL OPERATION OF ANY SYSTEM.

COPIES: PERMIT SIGNED
AND RETURNED 7/27/82
Serial # 19951

A/5/235

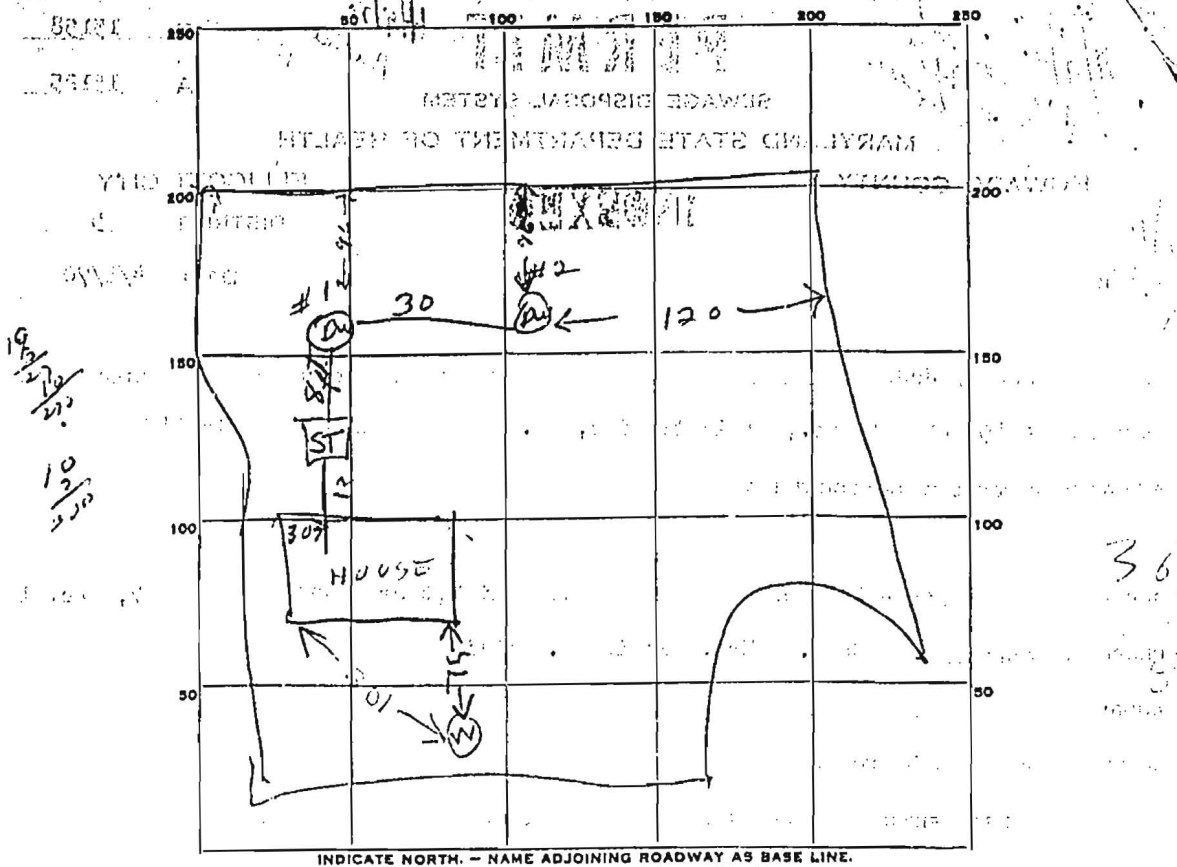

PERMIT CARD _____

SEPTIC TANK, LEVEL 1000 gal CLEANOUTS OK

DISTRIBUTION BOX, LEVEL _____

TILE FIELD, DEPTH _____ FT. TRENCH WIDTH _____ FT.

GRAVEL DEPTH _____ IN. TOTAL LENGTH _____ FT.

NUMBER OF TRENCHES _____ TOTAL BOTTOM AREA _____

2 SEEPAGE PITS, INSIDE DIAMETER #1 9ft FT. DEPTH BELOW INLET #2 10 FT.
#2 10ft
 outside diameter

ABSORBENT AREA 570 SQ. FT.

REMARKS for both dry wells

4/9/70 - Dave OK to back fill dry wells. Sewer line to Septic not installed

R. Tona

5/22/70 Carp Iron House sewer installed

DATE SYSTEM APPROVED 5/22/70 INSPECTOR William J. Hodges

Re-test
3/18/70 - 2nd

APPLICATION

A 15125

SEWAGE DISPOSAL TESTING

P _____

MARYLAND STATE DEPARTMENT OF HEALTH

HOWARD COUNTY

Septic Tank - 1,000 gal.

ELLICOTT CITY

DISTRICT 5

Dry Well - 400 sq. ft. absorbent sidewall area

DATE 3/13/70

to begin below the first 3/4 non porous soil. maximum depth permitted for dry well is 12 ft. locate dry well 120 ft off right side line and 96 ft. from rear property line as seen from Linky Thorn Lane.

TO: THE COUNTY HEALTH OFFICER
ELLICOTT CITY, MARYLAND

I, HEREBY, APPLY FOR THE NECESSARY TESTS IN ORDER TO CONSTRUCT (OR RECONSTRUCT) A SEWAGE DISPOSAL SYSTEM.

PROPERTY OWNER Captain & Mrs. William P. Willis

ADDRESS _____

Any questions call
PHONE Mr. Judge - 531-5512

PROPERTY LOCATION:

SUBDIVISION Aintree Estates, Inc.

LOT NO. 7, Sec. 1

ROAD AND DESCRIPTION Linkythorn Lane

OCCUPANT _____

PHONE _____

PERSON TO CONSTRUCT SYSTEM _____

ADDRESS _____

PHONE _____

SIZE OF LOT 3.1 + acres

TYPE BLDG. 3

NUMBER OF BEDROOMS

IF NOT SINGLE RESIDENCE DESCRIBE _____

(Single Family Dwllg.)

SIGNATURE OF APPLICANT Joseph Judge

APPROVED BY Robert V. Toner

FOR

Dry Well
(KIND OF SYSTEM)

DATE

3/19/70

REJECTED BY _____

FOR _____

(KIND OF SYSTEM)


DATE _____

HOLD PENDING FURTHER TESTS _____

DATE _____

REASONS FOR REJECTION OR HOLDING _____

THIS IS NOT A PERMIT

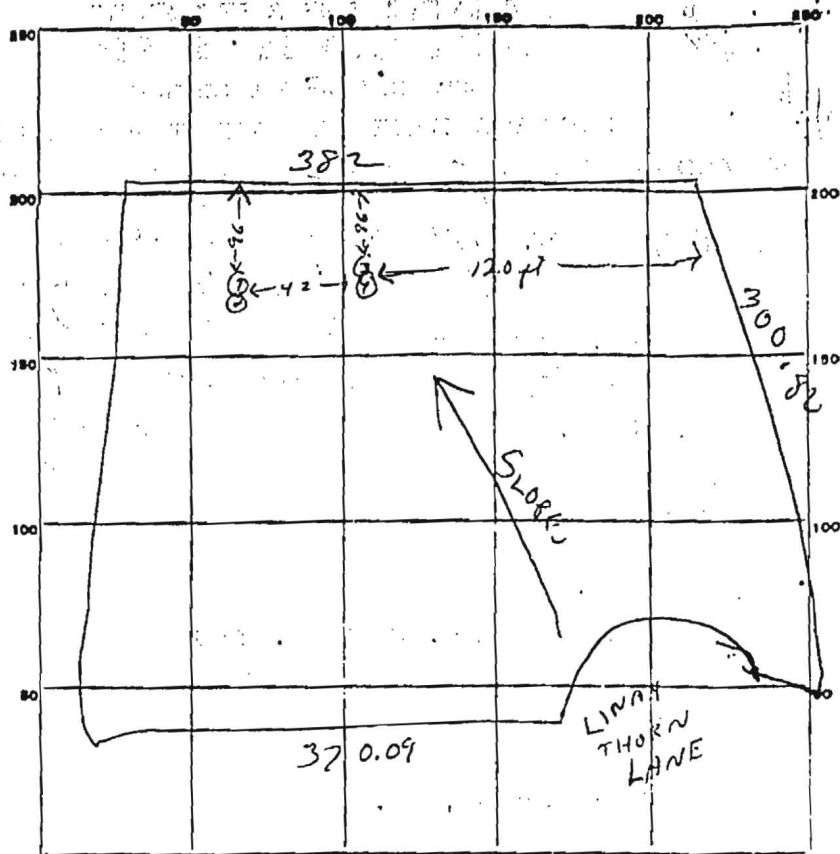


INDICATE NORTH. - NAME ADJOINING ROADWAY AS BASE LINE.

DATE	TEST NO.	DEPTH	PRE-WET		TEST - 1" DROP		TIME
			START	STOP	START	STOP	
3/19/70	1	12 ft.	1:51	1:53	1:53	1:57	4 min
	2	3 1/2 ft.	1:40	1:44	1:44	1:57	13 min
	3	11 1/2 ft.	1:57	2:00	2:00	2:06	6 min
	4	3 1/2 ft.	1:57	2:09	2:09	2:04	4 min

SOIL AUGER FINDING _____

TESTED BY R. Torne

REMARKS _____

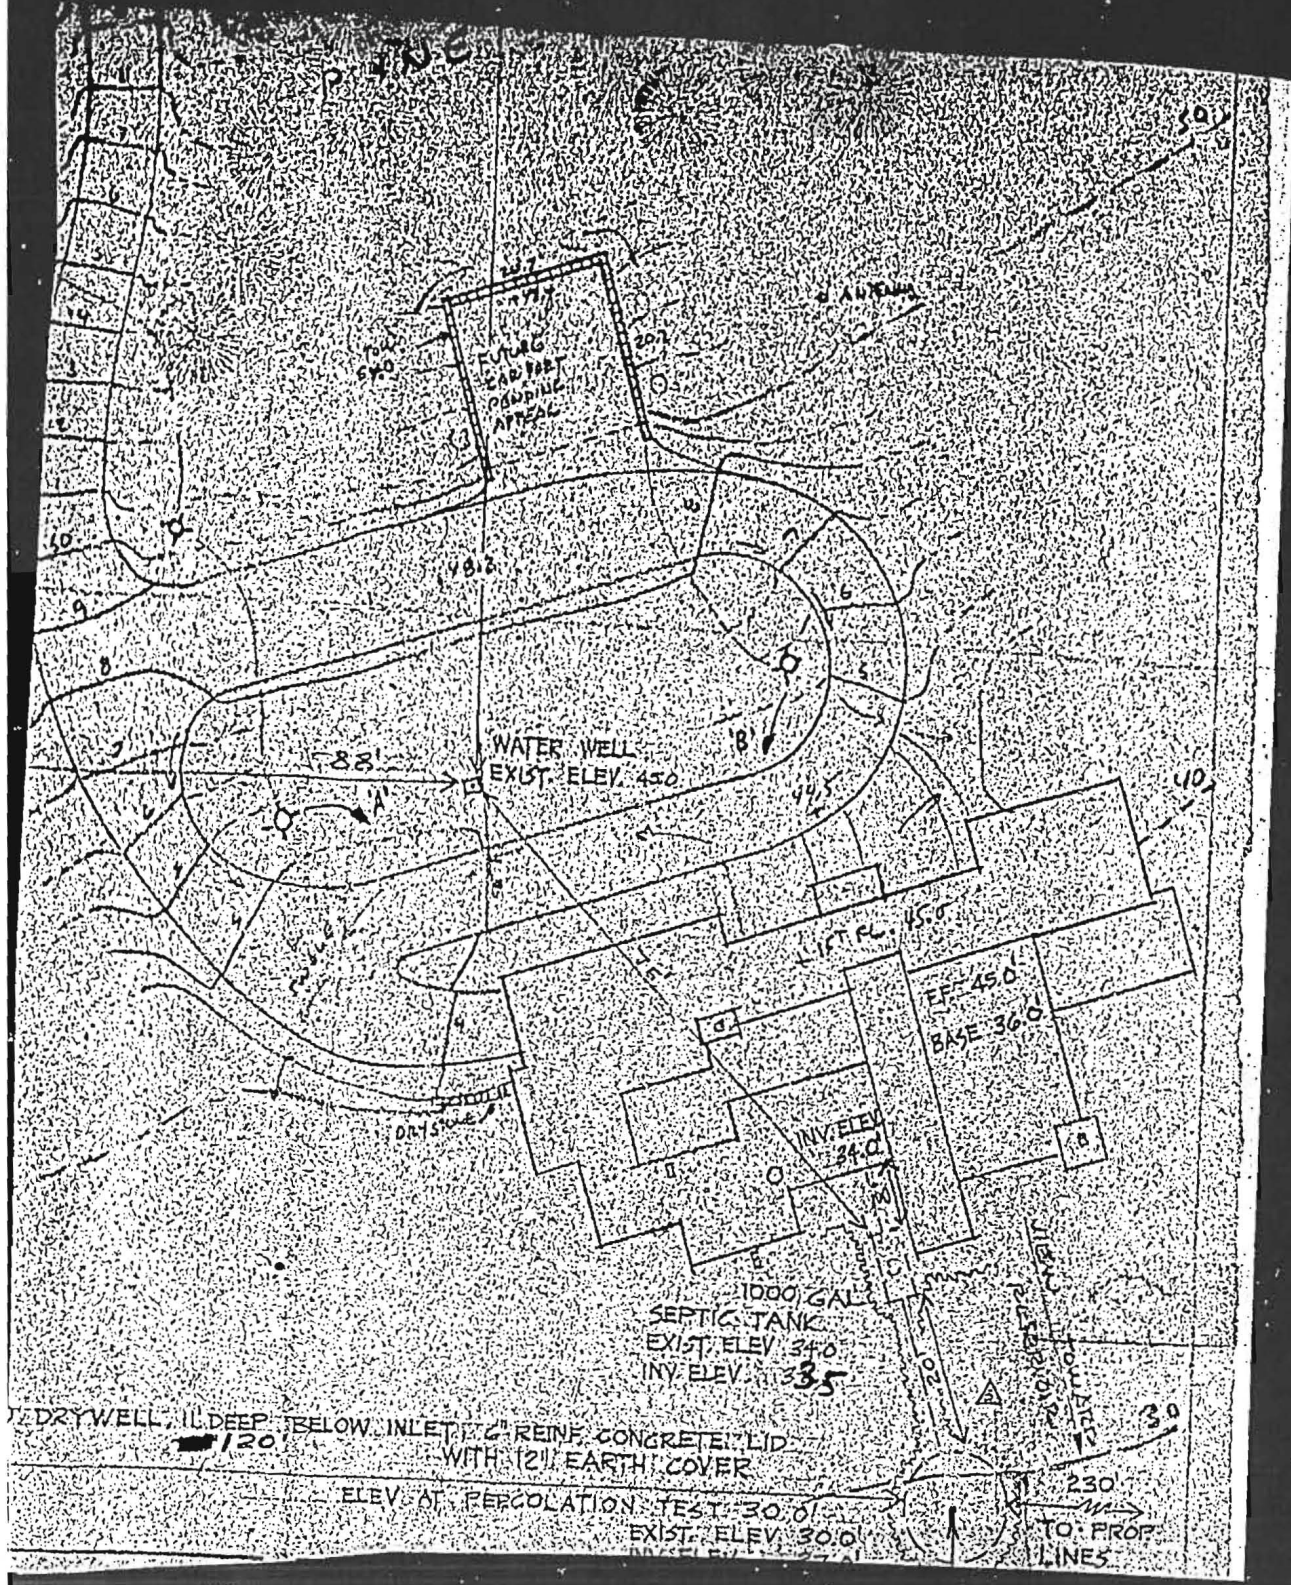

DRY WELL, 18" DEEP, BELOW INLET, 12" REINF. CONCRETE LID WITH 12" EARTH COVER
 ELEV. AT PERCOLATION TEST 30.0
 EXIST. ELEV. 30.0
 INV. ELEV. 27.0

Howard County Health Department

To: _____

Probable - but not
definite - that this
well permit ^{for comp rpt.} goes w/this
property file

From: MR

Date: 7/3/90

HD-170

SEQUENCE NO. (DOWN USE ONLY) **4127**

THIS NUMBER IS TO BE CHECKED IN COLS. 3-5 ON ALL SHEETS

RECEIVED (DOWN USE ONLY)

DATE WELL COMPLETED **5-5-70**

8-13

OWNER Judge Joseph L
LAST NAME

STREET OR RFD 74 Ashurst Ave

WELL LOG

STATE THE KIND OF FORMATIONS PENETRATED, THEIR COLOR, DEPTH, THICKNESS AND IF WATER BEARING

DESCRIPTION (USE ADDITIONAL SHEETS IF NECESSARY)	FEET		CHECK WATER BEARING
	FROM	TO	
Overburden	0	8	
Brown Shale	8	60	
Dark Gray Rock	60	150	

CIRCLE APPROPRIATE BOXES

- A WELL WAS ABANDONED AND SEALED WHEN WELL WAS COMPLETED
- E ELECTRIC LOG OBTAINED
- C COPY OF ELECTRIC LOG ATTACHED

I HEREBY CERTIFY THAT I HAVE COMPLIED WITH CONDITIONS STATED ON THE ABOVE-CAPTIONED "P TO DRILL WELL", AND THAT INFORMATION CONTAINED IN THIS REPORT IS TRUE, ACCURATE, AND COMES TO THE BEST OF MY KNOWLEDGE, INFORMATION AND BELIEF.

DRILLER'S NAME

(PLEASE PRINT) G. Edgar Mann Sons

SIGNATURE [Signature]

Howard County Health Department

To: _____

Probable - but not
definite - that this
well permit ^{of comp rpt.} goes w/this
property file

From: MR

Date: 7/3/90

HD-170

SEQUENCE NO. (DOWN USE ONLY) **4127**

THIS NUMBER IS TO BE CHECKED IN COLS. 3-6 ON ALL

RECEIVED (DOWN USE ONLY)

DATE WELL COMPL 5-5-70

8-13 13

OWNER Judge Joseph L

STREET OR RFD 74 Amburst Ave

WELL LOG

STATE THE KIND OF FORMATIONS PENETRATED, THEIR COLOR, DEPTH, THICKNESS AND IF WATER BEARING

DESCRIPTION (USE ADDITIONAL SHEETS IF NECESSARY)	FEET		CHECK WATER BEARING
	FROM	TO	
Overbunden	0	8	
Brown Shale	8	60	
Dark Gray Rock	60	150	

CIRCLE APPROPRIATE BOXES

A WELL WAS ABANDONED AND SEALED WHEN WELL WAS COMPLETED

E ELECTRIC LOG OBTAINED

C COPY OF ELECTRIC LOG ATTACHED

I HEREBY CERTIFY THAT I HAVE COMPLIED WITH CONDITIONS STATED ON THE ABOVE-CAPTIONED "WELL TO DRILL WELL", AND THAT INFORMATION CONTAINED IN THIS REPORT IS TRUE, ACCURATE, AND CORRECT TO THE BEST OF MY KNOWLEDGE, INFORMATION AND BELIEF.

DRILLERS NAME

(PLEASE PRINT) G. Edgar Hann Sons

SIGNATURE [Signature]

APPLICATION

A 11654

SEWAGE DISPOSAL TESTING

P _____

MARYLAND STATE DEPARTMENT OF HEALTH

HOWARD COUNTY

ELLCOTT CITY

3 bedrooms - 750 gal. septic tank.

DISTRICT 5

DATE 3/31/66

Dry well 13 ft. in dia by 9 ft. deep below the inlet located 105 ft. from the front property line and 70 ft. off the right side of property line as seen when facing the lot from Road "A". Inlet pipe 3 ft. below original grade.

TO: THE COUNTY HEALTH OFFICER
ELLCOTT CITY, MARYLAND

4 bedrooms - 1000 gal. septic tank. Dry well 14 ft. in dia. by 11 ft. deep below the inlet with location and other specifications the same as for 3 bedrooms.

I, HEREBY, APPLY FOR THE NECESSARY TESTS IN ORDER TO CONSTRUCT (OR RECONSTRUCT) A SEWAGE DISPOSAL SYSTEM.

PROPERTY OWNER Aintree Estates, Inc.

ADDRESS 301 Cedar St., N. W. Washington, D. C. PHONE HO 5-1635

PROPERTY LOCATION:

SUBDIVISION Aintree Estates, Inc. LOT NO. 7, Sec. 1

ROAD AND DESCRIPTION Road "A"

OCCUPANT _____ PHONE _____

PERSON TO CONSTRUCT SYSTEM _____

ADDRESS _____ PHONE _____

SIZE OF LOT 3.1 acres + TYPE BLDG. 3 or 4

NUMBER OF BEDROOMS

IF NOT SINGLE RESIDENCE DESCRIBE _____

SIGNATURE OF APPLICANT /s/ Mr. Brincefield per Mr. Sutherland

APPROVED BY J. H. ... FOR Dry well DATE 4-3-66

(KIND OF SYSTEM)


REJECTED BY _____ FOR _____ DATE _____

(KIND OF SYSTEM)

HOLD PENDING FURTHER TESTS _____ DATE _____

REASONS FOR REJECTION OR HOLDING _____

THIS IS NOT A PERMIT

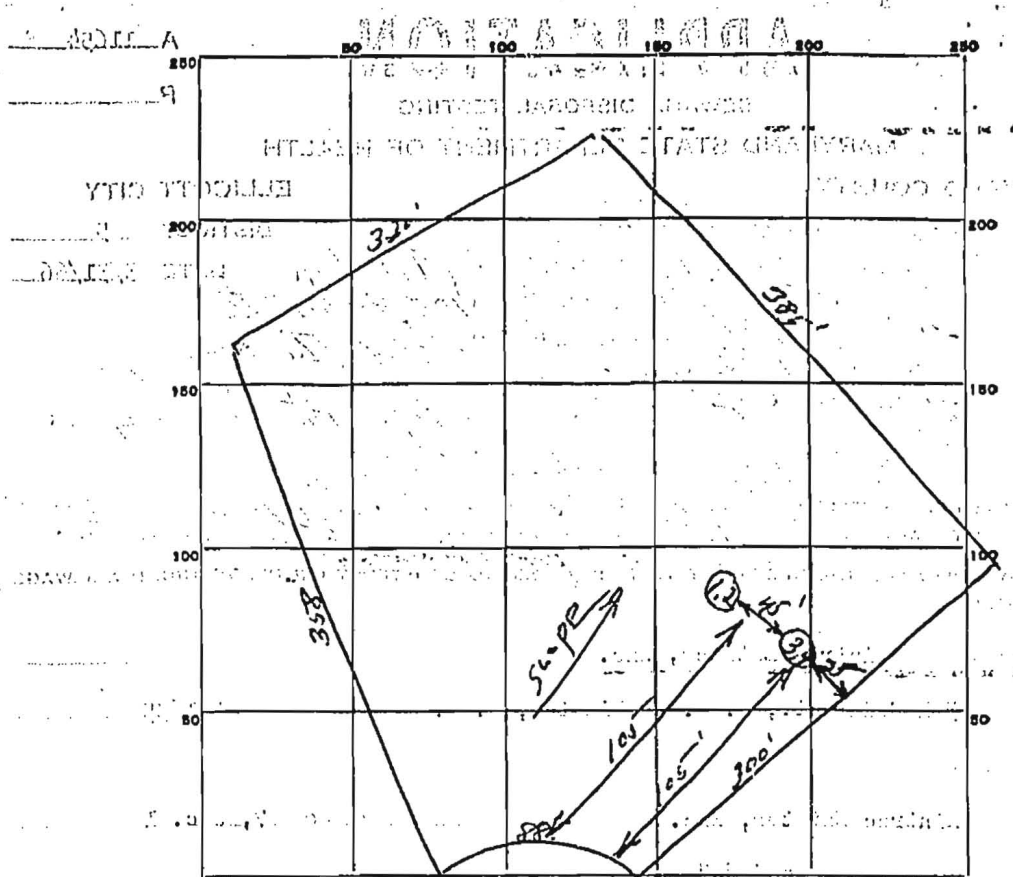

INDICATE NORTH. - NAME ADJOINING ROADWAY AS BASE LINE.
 Road "A"

DATE	TEST NO.	DEPTH	PRE-WET		TEST - 1" DROP		TIME
			START	STOP	START	STOP	
4-6-66	1 Same	9'	10:25	10:32	10:32	10:57	2.5 min
	2 Pst	4'	10:26	10:30	10:30	10:36	6 min
	3 Same	9 1/2'	10:40	10:47	10:47	10:57	10 min
	4 Pst.	4'	10:41	10:42	10:42	10:43	1 min

avg. perc
 Time
 11 min

SOIL AUGER FINDING _____
 TESTED BY JH.
 REMARKS _____