

# APPLICATION

SEWAGE DISPOSAL TESTING

STATE OF MARYLAND - DEPARTMENT OF HEALTH AND MENTAL HYGIENE

HOWARD COUNTY HEALTH DEPARTMENT  
ENVIRONMENTAL HEALTH SERVICES

P. O. BOX 476 ELLICOTT CITY, MARYLAND 21043  
TELEPHONE: 992-2330

A 33512

P \_\_\_\_\_

DISTRICT 5

DATE 1-30-84

TO: THE COUNTY HEALTH OFFICER  
ELLICOTT CITY, MARYLAND

I, HEREBY, APPLY FOR THE NECESSARY TEST IN ORDER TO CONSTRUCT (OR RECONSTRUCT) A SEWAGE DISPOSAL SYSTEM.

PROPERTY OWNER ANNA MacCarthy RICHARD DEMMITT

ADDRESS 4100 Cathedral Ave NE 20016 PHONE 202-363-2725

PROPERTY LOCATION: BRIGHTON PINES II LOT 13

SUBDIVISION Prappert Prop LOT NO. 23

ROAD AND DESCRIPTION Nicholas Dr 13840 LAKESIDE DR.

SIZE OF LOT 3A TYPE BLDG. S.F.D.  
(NUMBER OF BEDROOMS)

THE SYSTEM INSTALLED UNDER THIS APPLICATION IS ACCEPTABLE ONLY UNTIL PUBLIC FACILITIES BECOME AVAILABLE. I FULLY UNDERSTAND THE FEE CONNECTED WITH THE FILING OF THIS PERC TEST APPLICATION IS NON-REFUNDABLE UNDER ANY CIRCUMSTANCES. I ALSO AGREE TO COMPLY WITH ALL M.O.S.H.A. REQUIREMENTS IN TESTING THIS LOT.

Richard J. Demmitt 405-0842  
(SIGNATURE OF APPLICANT)

APPROVED BY Sid Abel FOR Deep Tranches DATE 10-5-88

REJECTED BY \_\_\_\_\_ FOR \_\_\_\_\_ DATE \_\_\_\_\_

HOLD PENDING FURTHER TESTS \_\_\_\_\_ DATE \_\_\_\_\_

REASONS FOR REJECTION OR HOLDING POSSIBLE ROCK HOLD



BLDG. PERMIT SIGNED  
AND RETURNED 10-5-88

21284  
S-10

# THIS IS NOT A PERMIT

ALL HOLES

SOIL PROFILE

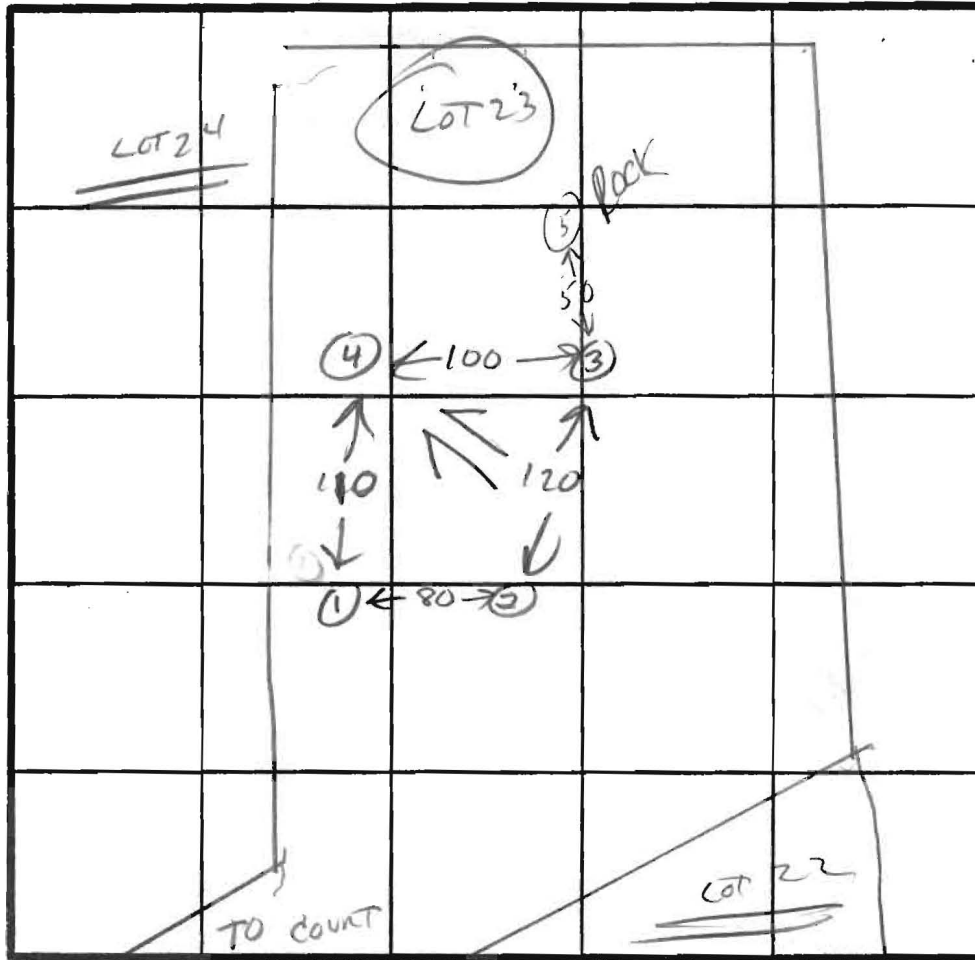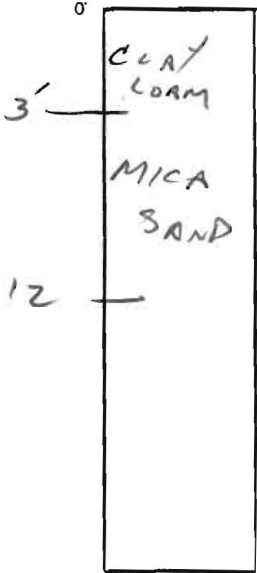

INDICATE NORTH - NAME ADJOINING ROADWAY AS BASE LINE.

DATE	TEST NO.	DEPTH	PRE-WET		TEST - 1" DROP		TIME
			START	STOP	START	STOP	
2-21-84	1 LOW	4	12:19	12:23	12:23	12:28	2 MIN
		8	SANDY				
		12	SANDY				
2-21-84	2 } HIGH	4	12:20	12:22	12:22	12:24	2 MIN
		8	SANDY				
		12	SANDY				
2-21-84	3 }	4	12:20	12:22	12:22	12:24	2 MIN
		8	SANDY				
		12	SANDY				
2-21-84	4	4	12:21	12:23	12:23	12:25	2 MIN
		8	SANDY				
		12	SANDY				
	5	ROCK HOLE - ABANDONED					

REMARKS \_\_\_\_\_

TYPE OF SOIL MICA SAND

TESTED BY CWILLIAMS

ALSO PRESENT DEMMEY, PAUL