

Pact

APPLICATION

SEWAGE DISPOSAL TESTING

A 33515

STATE OF MARYLAND - DEPARTMENT OF HEALTH AND MENTAL HYGIENE

P _____

HOWARD COUNTY HEALTH DEPARTMENT
ENVIRONMENTAL HEALTH SERVICES

DISTRICT 5

P. O. BOX 476 ELLICOTT CITY, MARYLAND 21043
TELEPHONE: 992-2330

DATE 1-30-84

TO: THE COUNTY HEALTH OFFICER
ELLICOTT CITY, MARYLAND

I, HEREBY, APPLY FOR THE NECESSARY TEST IN ORDER TO CONSTRUCT (OR RECONSTRUCT) A SEWAGE DISPOSAL SYSTEM.

PROPERTY OWNER ANNA MacCarthy

ADDRESS 4100 Cathedral Ave DC 20016 PHONE 202-363-2725

PROPERTY LOCATION: BRIGHTON PINES II LOT 16

SUBDIVISION Proppert Prop LOT NO. 26

ROAD AND DESCRIPTION Nicholas Dr.

SIZE OF LOT 3A TYPE BLDG. SFD
(NUMBER OF BEDROOMS)

THE SYSTEM INSTALLED UNDER THIS APPLICATION IS ACCEPTABLE ONLY UNTIL PUBLIC FACILITIES BECOME AVAILABLE. I FULLY UNDERSTAND THE FEE CONNECTED WITH THE FILING OF THIS PERC TEST APPLICATION IS NON-REFUNDABLE UNDER ANY CIRCUMSTANCES. I ALSO AGREE TO COMPLY WITH ALL M.O.S.H.A. REQUIREMENTS IN TESTING THIS LOT.

Richard J. Veronitt 465-0842
(SIGNATURE OF APPLICANT)

APPROVED BY C. Willman FOR SHALLOW TRENCHES DATE 2-12-85

REJECTED BY _____ FOR _____ DATE _____

HOLD PENDING FURTHER TESTS C. Willman DATE 2-18-84



REASONS FOR REJECTION OR HOLDING FIELD INSPECTION REQUIRED, ORIGINAL LAYOUT

INCLUDES DRAINAGE SWALS - MUST BE RELOCATED USING 160LBS 5TB 2-18-84 CW

THIS IS NOT A PERMIT

ALL HOLES

SOIL PROFILE

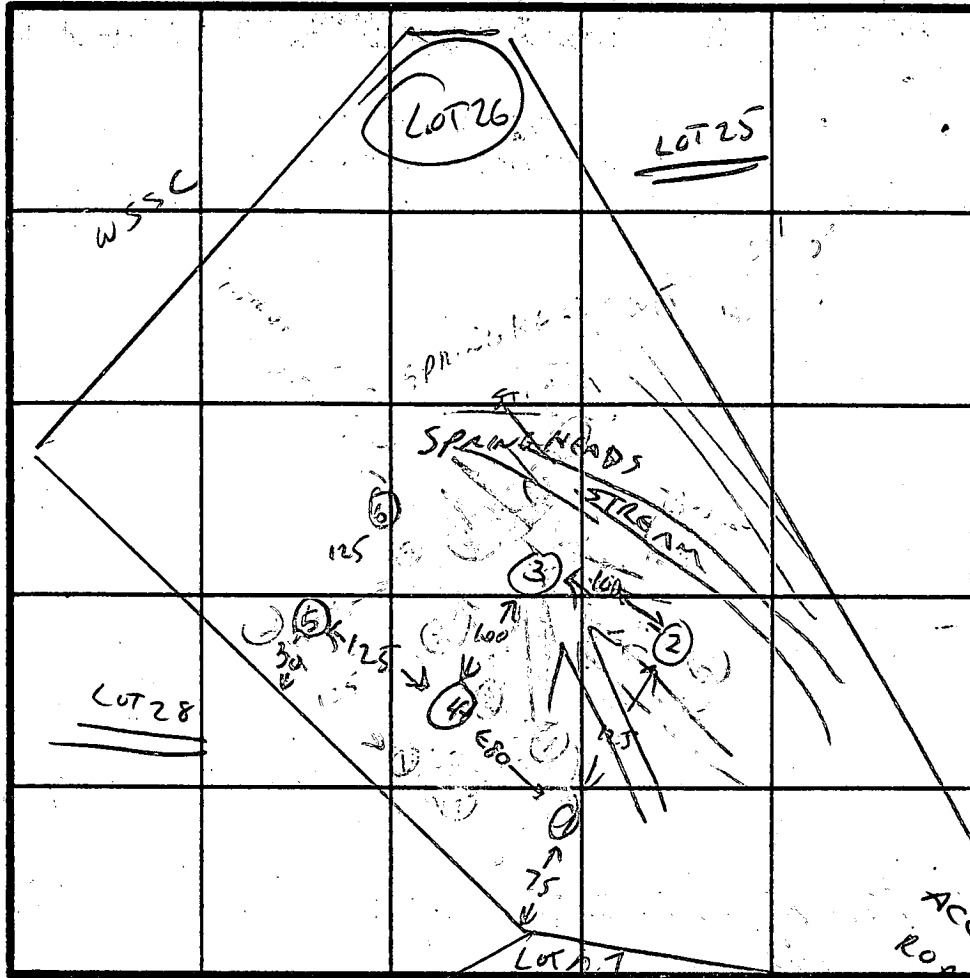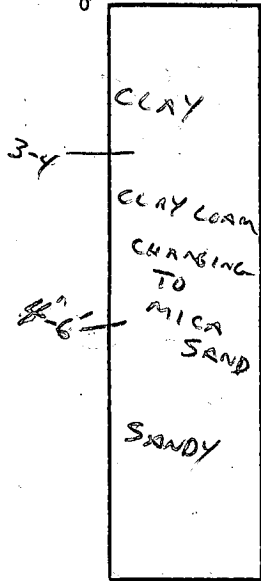

INDICATE NORTH - NAME ADJOINING ROADWAY AS BASE LINE.


DATE	TEST NO.	DEPTH	PRE-WET		TEST - 1" DROP		TIME
			START	STOP	START	STOP	
2-17-84	1 HIGH	4	11:04	11:08	11:08	11:15	7 MIN
		8	11:15	11:17	11:17	11:18	3 MIN
		12	CLAY TO 3'	THEN CLAY LOAM MICA SAND			
2-17-84	2	4	11:07	11:10	11:10	11:14	4 MIN
		8	11:20	11:22	11:22	11:24	2 MIN
		12	CLAY TO 4'	THEN MICA SAND			
2-17-84	3	4	11:09	11:11	11:11	11:13	2 MIN
		8	11:09	11:11	11:11	11:13	
2-17-84	4 2ND HIGH	4	11:10	11:30	11:30	12:00	30 MIN
		5 1/2	12:10	12:13	12:13	12:18	5 MIN
		8	12:10	12:12	12:12	12:14	2 MIN
2-17-84	5	4	2:10	2:14	2:14	2:20	6 MIN
		12	MICA SAND				
2-17-84	6	4	2:10	2:13	2:13	2:16	3 MIN
		12	MICA SAND				

ALL HOLES OK - LAYOUT NEEDS ADJUSTMENT TO AVOID DRAINAGE PROBLEMS.
REMARKS DRAINAGE AREA IN CENTER OF PLOT AREA SPRING HEADS ADJACENT TO LAYOUT UNACCEPTABLE

TYPE OF SOIL MICA SAND LOAM

TESTED BY C. William ALSO PRESENT DEMMIT, PHIL

EH-12-1079

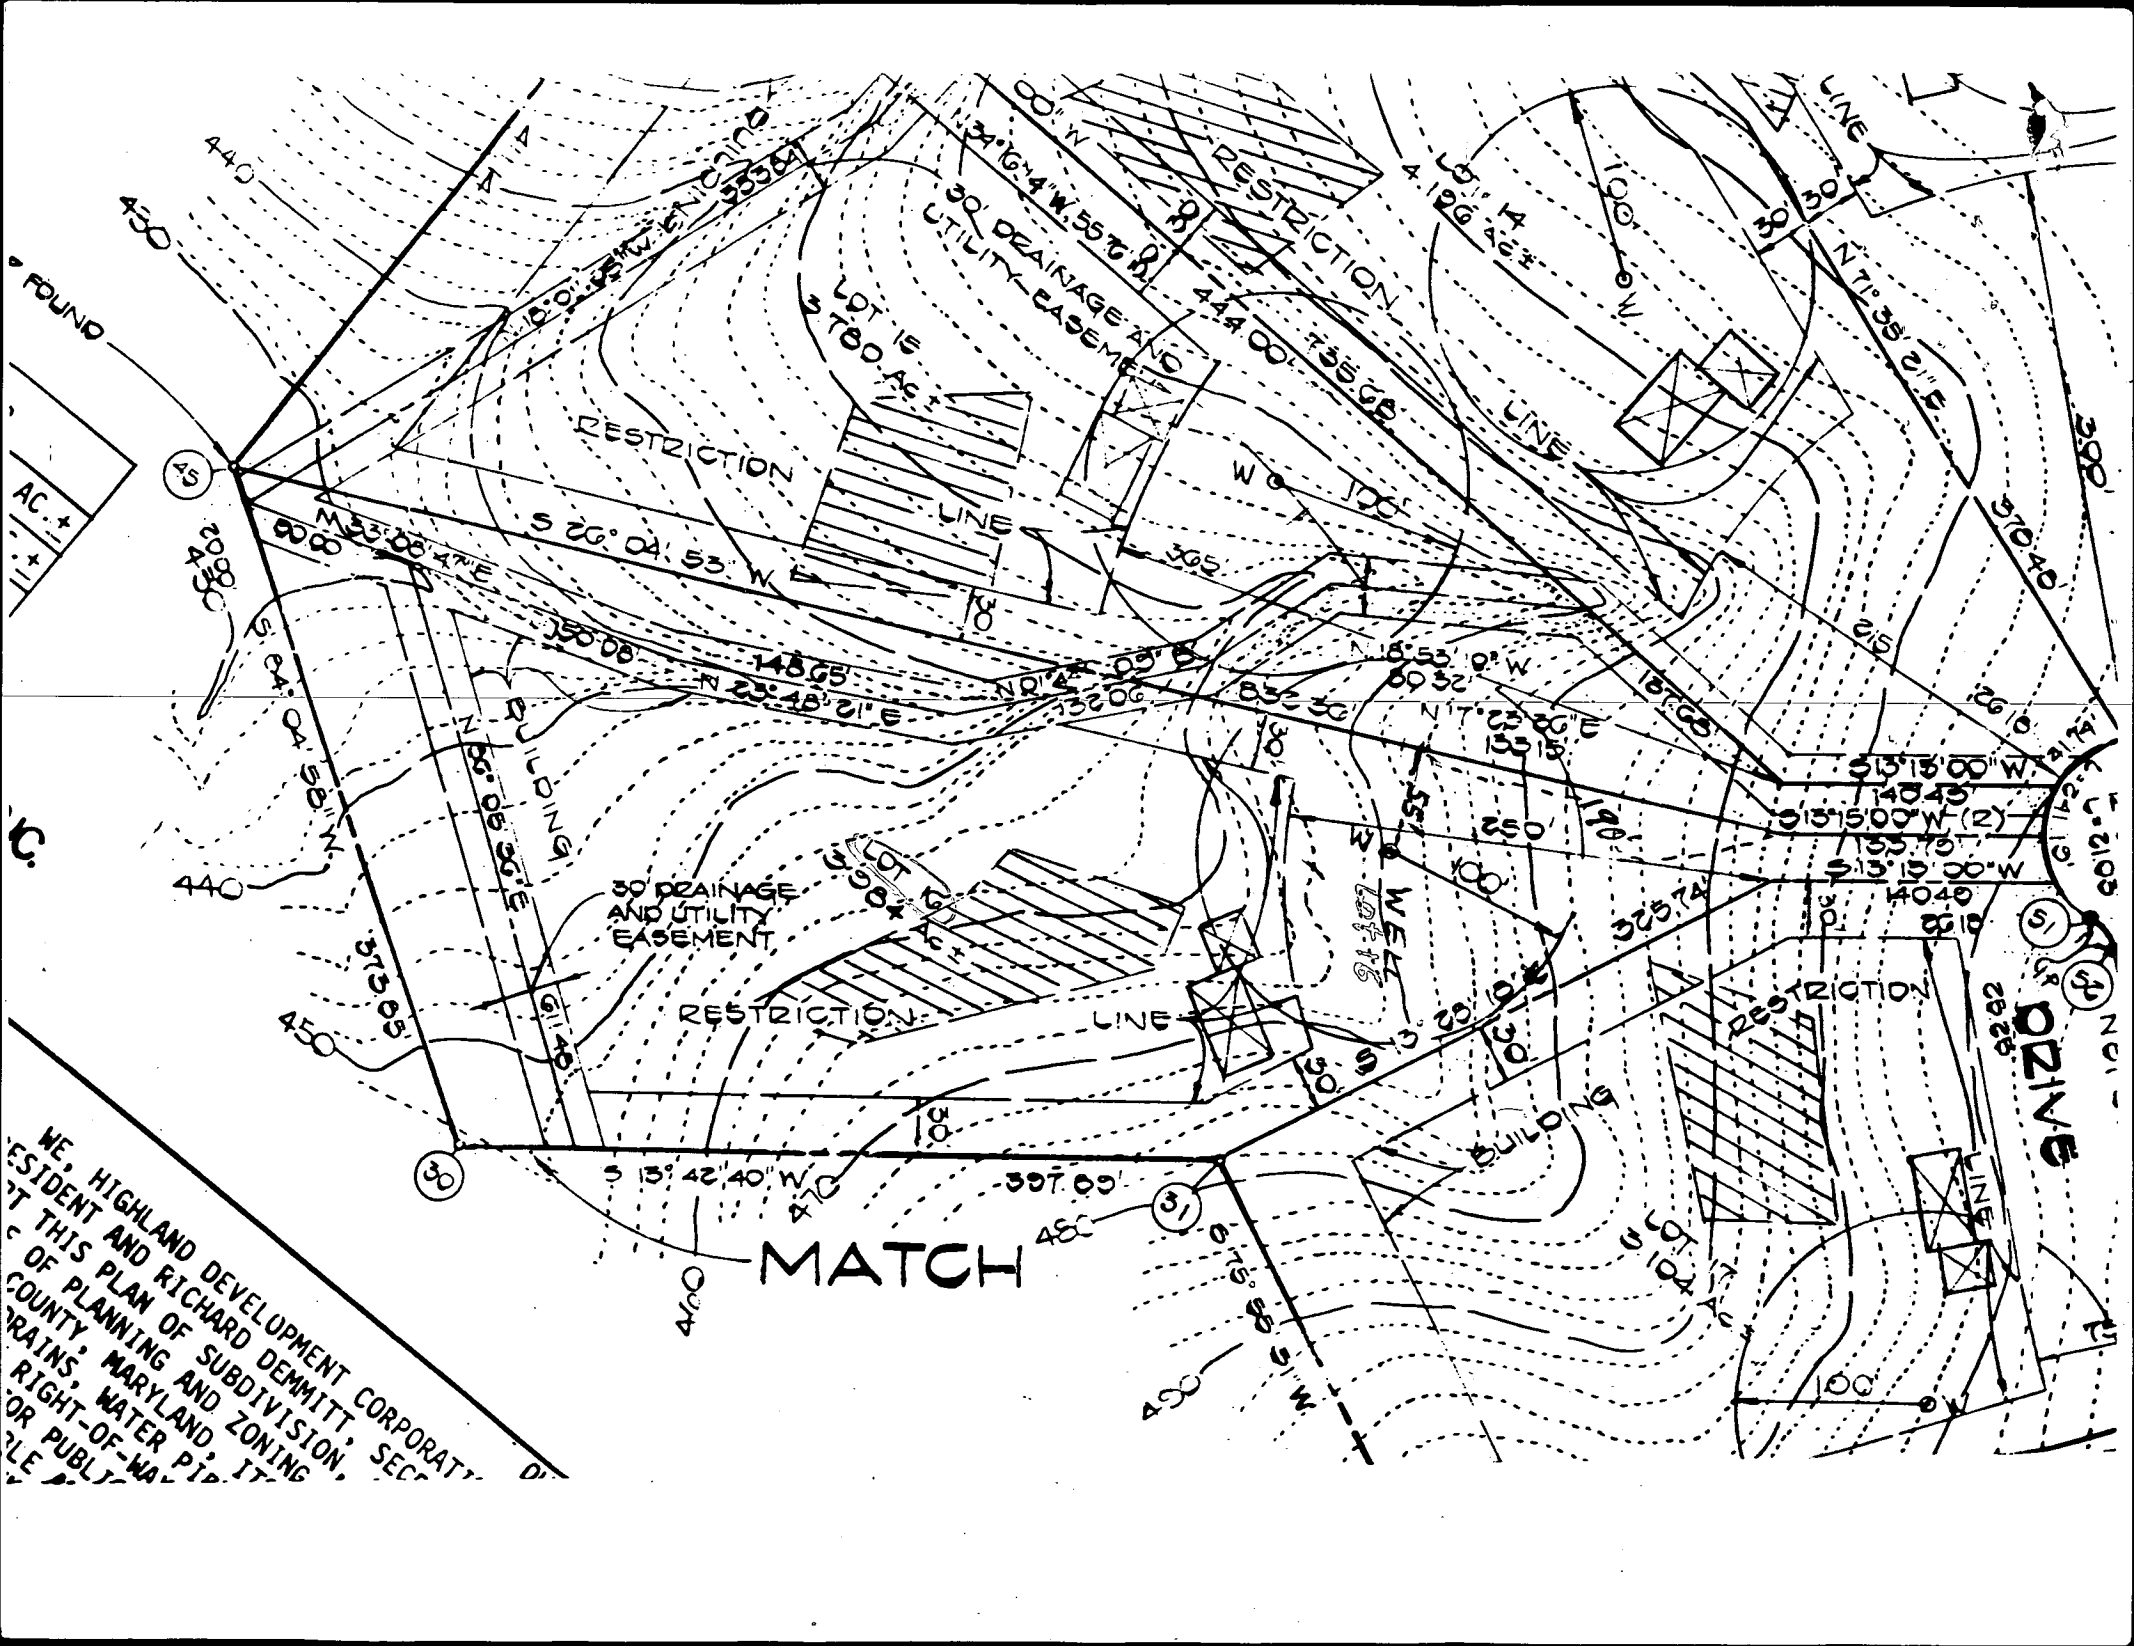

WE, HIGHLAND DEVELOPMENT CORPORATION,
 PRESIDENT AND RICHARD DEMMITT, SECRETARY,
 OF THIS PLAN OF SUBDIVISION, SECURED
 COUNTY OF PLANNING AND ZONING
 COUNTY, MARYLAND, THE RIGHTS OF
 DRAINAGE, WATER PIPE, AND
 RIGHT-OF-WAY, AND THE RIGHTS OF PUBLIC
 OR PRIVATE UTILITIES.

MATCH

DRIVE

30' DRAINAGE AND UTILITY EASEMENT

RESTRICTION LINE

RESTRICTION LINE

LINE

LINE

RESTRICTION LINE

BUILDING

LOT 15
 3700 AC.

WELL

30' DRAINAGE AND UTILITY EASEMENT

30' DRAINAGE AND UTILITY EASEMENT

31

45

30

35

36

37

