

Bureau of Environmental Health
 7178 Gateway Drive Columbia, MD 21046
 (410) 313-2640 Fax (410) 313-2648
 TDD (410) 313-2323 Toll Free 1-866-313-6300
 website: www.hchealth.org

Maura J. Rossman, M.D., Health Officer

RECEIPT DATE: 4/23/14 **ONSITE SEWAGE DISPOSAL SYSTEM** P 546325

INSTALLATION APPROVAL DATE: 6/17/14 **PERMIT** A _____
(Signature)
MINOR REPAIR

PROPERTY ADDRESS: 12476 Lime Kiln Road

SUBDIVISION: _____ LOT: _____ TAX ID: 05-363225

CONTRACTOR: Joseph Heil Company INC. EMAIL: _____

CONTRACTOR ADDRESS: 8177 Mission Road, Jessup, MD 20794 PHONE: 410-799-7727

PROPERTY OWNER: Mary Jane Bradford EMAIL: _____

OWNER ADDRESS: 12476 Lime Kiln Road, Fulton, MD 20759 PHONE: _____


NUMBER OF BEDROOMS: n/a HOUSE SQ. FT. n/a

LOCATION:	
NOTES:	

ISSUED BY: _____ ISSUE DATE: _____ EXPIRATION DATE: _____

NOTE: CONTRACTOR MUST SCHEDULE AN INSPECTION AND GAIN APPROVAL OF ALL COMPONENTS PRIOR TO COVERING
 NOTE: AN ELECTRICAL PERMIT IS REQUIRED FOR INSTALLATION OF ANY ELECTRICAL COMPONENTS OF THE SYSTEM

**NEITHER THE HOWARD COUNTY COUNCIL NOR THE HEALTH DEPARTMENT IS RESPONSIBLE FOR THE SUCCESSFUL OPERATION OF ANY SYSTEM.
 PERMITTEE RESPONSIBLE FOR OBTAINING FINAL APPROVAL ON THIS PERMIT.
 CALL 410-313-1771 FOR INSPECTION OF SEPTIC SYSTEM.**

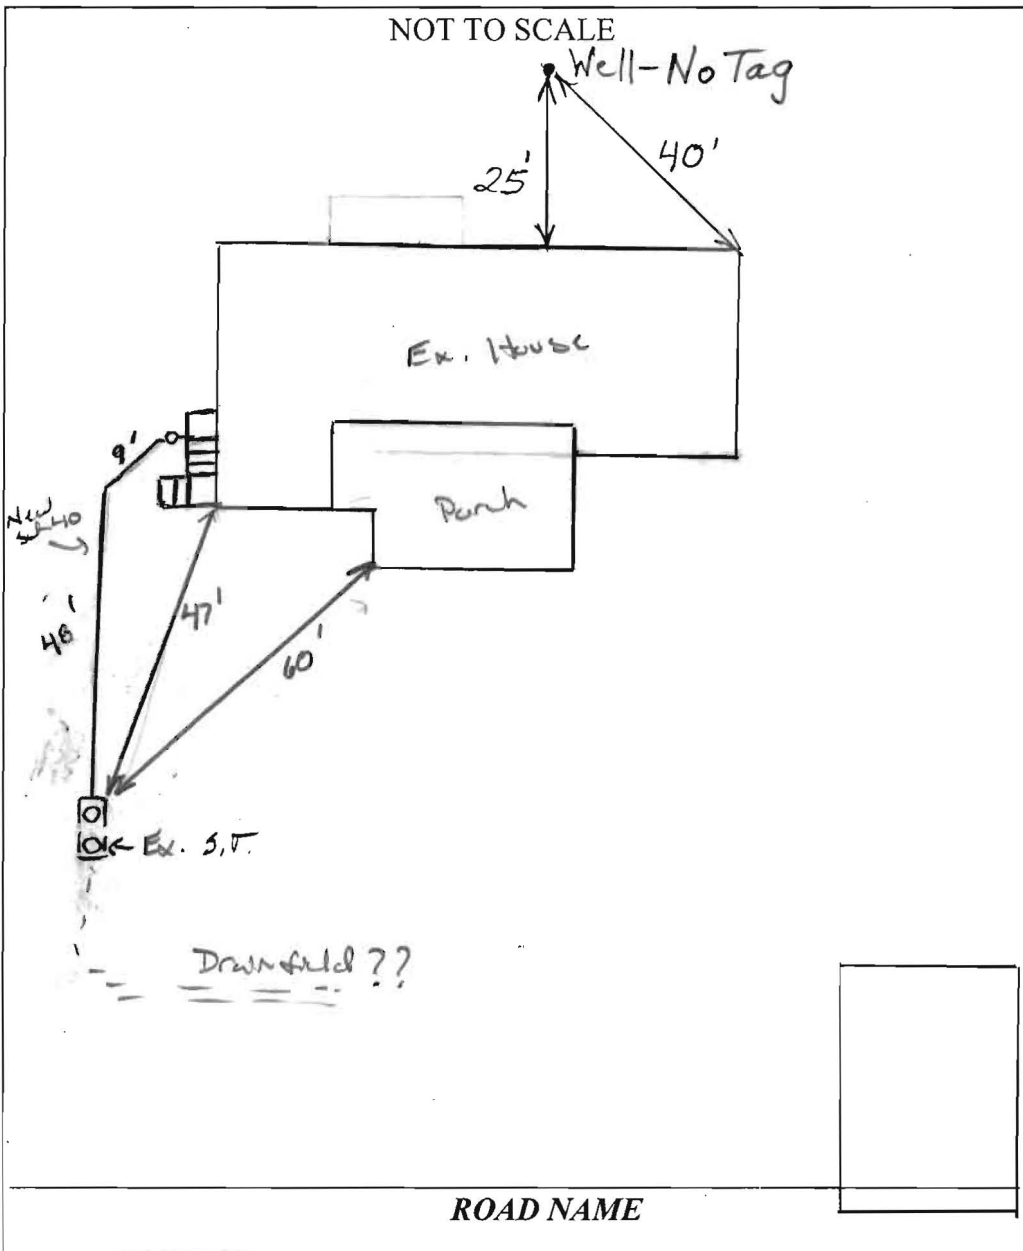

TRENCH/DRAINFIELD DATA		
WIDTH	INLET	BOTTOM
_____	_____	_____
NUMBER OF TRENCHES	_____	
TOTAL LENGTH	_____	
ABSORPTION AREA	_____	
DISTRIBUTION BOX LEVEL	_____	
DISTRIBUTION BOX BAFFLE	_____	
DISTRIBUTION BOX PORT	_____	

SEPTIC TANK DATA	
SEPTIC TANK I LEVEL	<u>Yes</u>
MANUFACTURER	<u>?</u>
CAPACITY	<u>1250?</u> GAL
SEAM LOC	<u>mid</u>
TANK LID DEPTH	<u>3'</u>
BAFFLES	<u>Yes</u>
BAFFLE FILTER	<u>—</u>
MANHOLE LOC	<u>Front/Rear (New)</u>
6" PORT LOC	<u>none</u>
WATERTIGHT TEST	<u>OK</u>
SLOTTED	<u>no</u>
DATE ON LID	<u>—</u>
PUMP/SEPTIC TANK LEVEL _____	
MANUFACTURER	_____
CAPACITY	_____ GAL
SEAM LOC	_____
TANK LID DEPTH	_____
BAFFLES	_____
BAFFLE FILTER	_____
MANHOLE LOC	_____
6" PORT LOC	_____
WATERTIGHT TEST	_____
SLOTTED	_____
DATE ON LID	_____

PRE-CONSTRUCTION:

4/23/2014 Called Heil Co. they said they would call when starting repair. (BB)

INSTALLATION:

6/13/2014 No work done. Got well location. (BB)
6/17/14 90% completion of new 4" sch 40 sewer line from house to tank. OK to cover when finished. Contractor to place stone around pipe as well. (BB)

FINAL INSPECTOR

K. Wolf

DATE OF APPROVAL

6/17/14