

PUB. SEWER STATUS VERIFIED BY _____

ISSUE DATE: 03/19/07

P 526289

APPROVAL DATE: 4/25/07 - Logged into Permit Manager

A UPGRADE 33515

PERMIT

Tax ID # 05-398533

ON-SITE SEWAGE DISPOSAL SYSTEM HOWARD COUNTY HEALTH DEPARTMENT BUREAU OF ENVIRONMENTAL HEALTH

Wheatley Associates, Inc. IS PERMITTED TO INSTALL ALTER

ADDRESS: 16928 York Road, Monkton, MD 21111 PHONE NUMBER: 410-329-2500

SUBDIVISION: Brighton Pines LOT NUMBER: 16

ADDRESS: 13833 Lakeside Drive PROPERTY OWNER: Joseph B. Long

SEPTIC TANK CAPACITY (GALLONS): 2000

PUMP CHAMBER CAPACITY (GALLONS): _____

NUMBER OF BEDROOMS: _____

SQUARE FEET PER BEDROOM: _____

LINEAR FEET OF TRENCH REQUIRED: _____

TRENCHES:	Trench to be _____ feet wide. Inlet _____ feet below original grade. Bottom maximum depth _____ feet below original grade. Effective area begins at _____ feet below original grade. _____ feet of stone below distribution pipe.
LOCATION:	_____
PURPOSE:	To install a 2,000 Gallon Septic Tank in order to have building permit for an addition approved. Call for an inspection when ground is opened. <i>Tank must be 10' off addition</i>

PLANS APPROVED: SFO ten DATE: 3/19/07

- NOTE: PERMIT VOID AFTER 2 YEARS.
- NOTE: CONTRACTOR RESPONSIBLE FOR SCHEDULING A PRE-CONSTRUCTION INSPECTION FOR ALL INSTALLATIONS
- NOTE: WATERTIGHT SEPTIC TANKS REQUIRED
- NOTE: ALL PARTS OF SEPTIC SYSTEM SHALL BE 100 FEET FROM ANY WATER WELL
- NOTE: MANHOLE RISERS REQUIRED ON ALL SEPTIC TANKS AND PUMP CHAMBERS

NEITHER THE HOWARD COUNTY COUNCIL OR THE HEALTH DEPARTMENT IS RESPONSIBLE FOR THE SUCCESSFUL OPERATION OF ANY SYSTEM PERMITTEE RESPONSIBLE FOR OBTAINING FINAL APPROVAL ON THIS PERMIT CALL 410-313-2640 FOR INSPECTION OF SEPTIC SYSTEM


BUILDING PERMIT SIGNED AND RETURNED

4/23/07 B07000756 2 STORY ADDITION

A33515

H0-81-1850

NOT TO SCALE

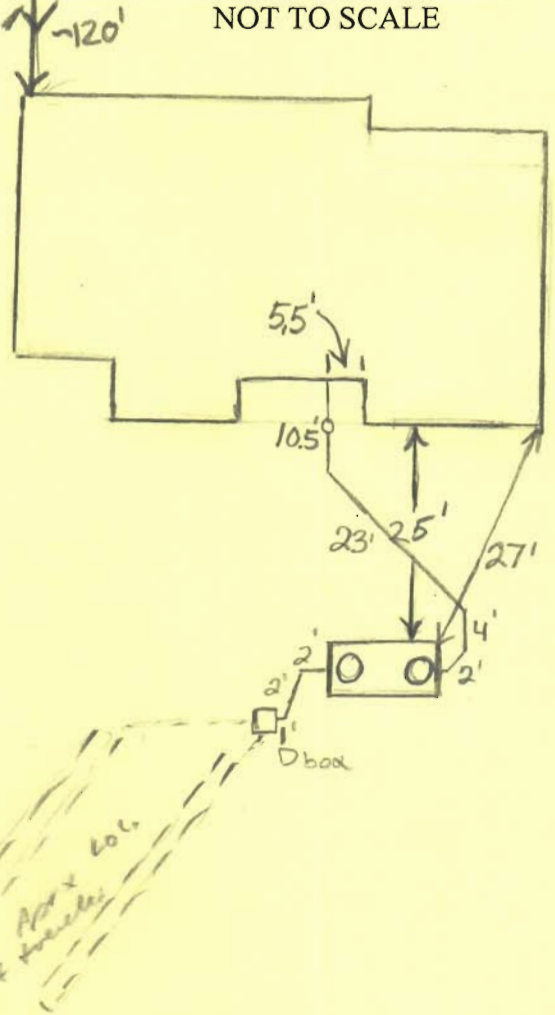

ROAD

TRENCH/DRAINFIELD DATA		
WIDTH	INLET	BOTTOM
_____	_____	_____
NUMBER OF TRENCHES _____		
TOTAL LENGTH _____		
ABSORPTION AREA _____		
DISTRIBUTION BOX LEVEL _____		
DISTRIBUTION BOX BAFFLE _____		
DISTRIBUTION BOX PORT _____		

SEPTIC TANK DATA		
SEPTIC TANK 1 LEVEL	Yes	
CAPACITY	2000	GAL
SEAM LOC	Top	
TANK LID DEPTH	1.5'-3'	
BAFFLES	Yes	
BAFFLE FILTER	No	
MANHOLE LOC	Front+Rear	
6" PORT LOC	None	
WATERTIGHT TEST	No	
SEPTIC TANK 2 LEVEL	N/A	
CAPACITY	_____	GAL
SEAM LOC	_____	
TANK LID DEPTH	_____	
BAFFLES	_____	
BAFFLE FILTER	_____	
MANHOLE LOC	_____	
6" PORT LOC	_____	
WATERTIGHT TEST	_____	

Babylon
2 comp
slotted

PRE-CONSTRUCTION 4/10/07 Tank installed per installation. Contractor to re-install plumbing coming out of house. Have to wait

INSTALLATION for Deck to come down before proceeding (K&W)

No baffles installed w/pt. To be connected perhaps 4/23

4/25/06 New tank connected to house. Old tank pumped out and filled in (BB)

FINAL INSPECTOR B. Baker

DATE OF APPROVAL 4/25/07