


Lot 1

209-09

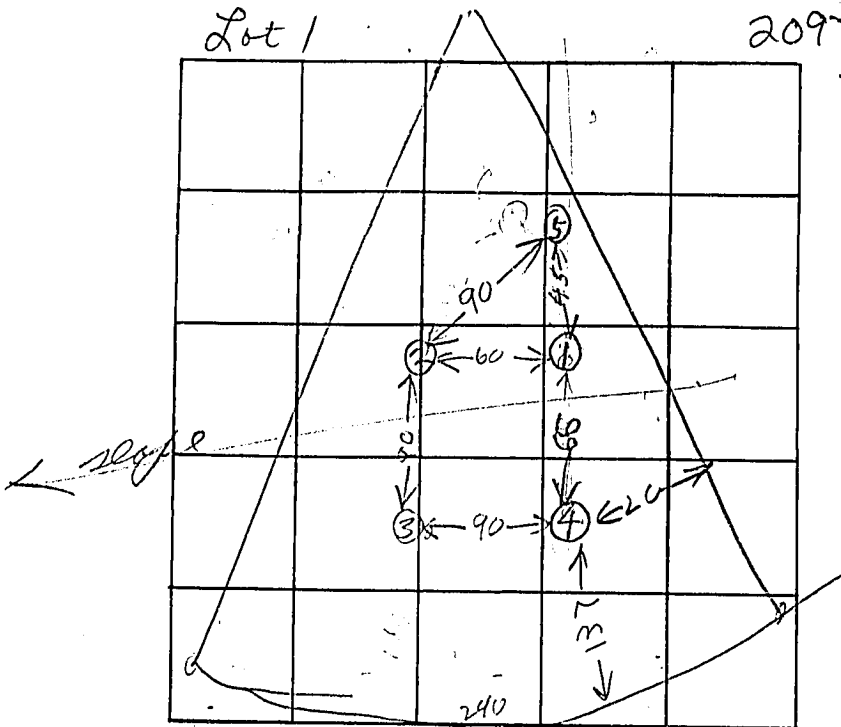

INDICATE NORTH. - NAME ADJOINING ROADWAY AS BASE LINE.

LAMP LIGHTER DR

SURVEYOR
LOT #

1D

1C

1B

1A

NO NUMBER

DATE	LOT # TEST NO.	DEPTH	PRE-WET		TEST - 1" DROP		TIME	
			START	STOP	START	STOP		
11/21/74	1	5	958	1000	1000	1003	3	TOP 3 FT CLAY MAY BE TOR DW
"	1A	12	1000	1001	1001	1002	2	
"	2	1 1/2	1006	1008	1008	1011	3	TOP 3 FT CLAY LOW
"	2A	6	1008	1011	1011	1021	9	
"	3	12	1014	1017	1017	1021	8	TOP 3 FT CLAY LOW
"	3A	4	1021	1032	1032	1045	13	
11/21/74	4	10	TOP 3 12 RY	FT CLAY 1027	1027	1027	5	TOP 3 FT CLAY MAY BE TOR DW
11/21/74	5	1 1/2	TOP 1307	2 FT 1027	2 FT 1027	CLAY SANDY DR		TOP 3 FT CLAY LOWEST

REMARKS: Hold location to be called. Artime 7 Max Depth

TYPE OF SOIL: SANDY

TESTED BY: B. HODGES

ALSO PRESENT: B. BARTH