

4/19/77 - a.m. if possible

8-9-77 F.F. 77

# PERMIT

P. 26328

SEWAGE DISPOSAL SYSTEM

A. 20909

MARYLAND STATE DEPARTMENT OF HEALTH

HOWARD COUNTY

ELLICOTT CITY

DISTRICT 3rd

**INDEXED**

DATE 6/30/77

Jim Brittingham IS PERMITTED TO INSTALL  ALTER

ADDRESS 3004 N. Rogers Ave., Ellicott City, Md. PHONE 461-1870

A SEWAGE DISPOSAL SYSTEM LOCATED AT \_\_\_\_\_

SUBDIVISION Sand Hill Acres ROAD Lamplighters Drive LOT 1

PROPERTY OWNER Sand Hill Joint Venture

ADDRESS 1010 Rockville Pike, Rockville, Md.

SPECIFICATIONS 4 bedrooms

DRAIN FIELD \_\_\_\_\_ DEPTH \_\_\_\_\_ FEET, BOTTOM AREA \_\_\_\_\_ SQ. FT.

SEEPAGE PITS \_\_\_\_\_ ABSORBENT SIDE-WALL AREA \_\_\_\_\_ SQ. FT.

SEPTIC TANK CAPACITY 1250 GALLONS

FOR GARBAGE GRINDER, INCREASE DISPOSAL AREA 22% & TANK CAPACITY 50%.

OTHER DRY WELL-480 sq. ft. sidewall area below inlet. Dry Well inlet to be 3 ft. deep below original grade and bottom of dry well to be 11 ft. below original grade. Place the dry well 137 ft. from the front lot line and 20 ft. from the right side of the lot as seen when facing the lot from Lamplighter Drive.

NOTE: ALL PIPE FROM HOUSE TO DISPOSAL AREA MUST BE CAST IRON. PERMIT VOID AFTER 3 YEARS.

NOTE: INSTALL STAND PIPES ON SEPTIC TANK AND DRY WELL. STAND PIPES MUST BE 6 INCHES IN DIAMETER. CAST IRON, CONCRETE OR TERRA COTTA ACCEPTED.


PLANS APPROVED BY Raymond Hodges DATE 3/15/77

FILL SEPTIC TANK AND DISTRIBUTION BOX WITH WATER BEFORE CALLING FOR AN INSPECTION. COVER NO WORK UNTIL INSPECTED AND APPROVED.

NEITHER THE HOWARD COUNTY COMMISSIONERS NOR THE HEALTH DEPARTMENT IS RESPONSIBLE FOR THE SUCCESSFUL OPERATION OF ANY SYSTEM.

A 20909

20709

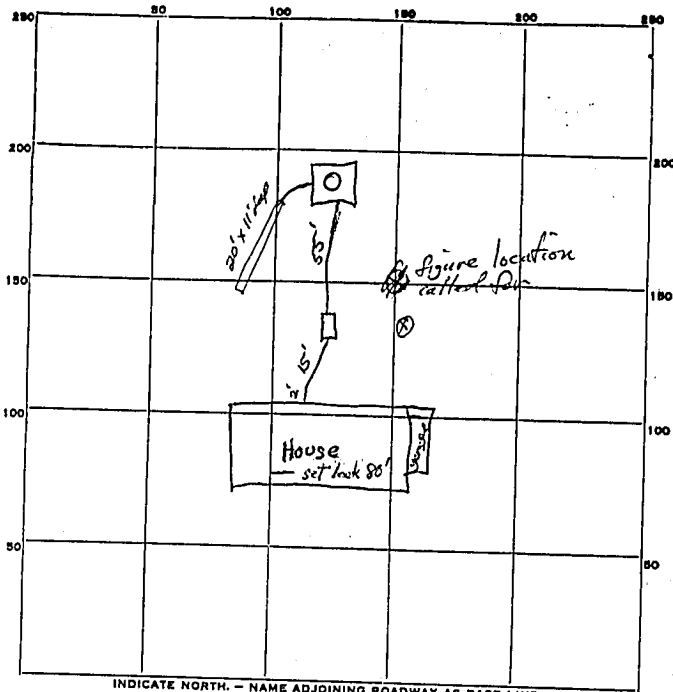

Setback 80  
 Home 254  
 Seepage Pit 17  
 " 10  
 Sum = 55  
 1.85

INDICATE NORTH. - NAME ADJOINING ROADWAY AS BASE LINE.

Road

PERMIT CARD \_\_\_\_\_

SEPTIC TANK, LEVEL ok CLEANOUTS ok

DISTRIBUTION BOX, LEVEL \_\_\_\_\_

TILE FIELD, DEPTH 11 FT. TRENCH WIDTH 2 FT.

GRAVEL DEPTH \_\_\_\_\_ IN. TOTAL LENGTH 20 FT.

NUMBER OF TRENCHES 1 TOTAL BOTTOM AREA \_\_\_\_\_

SEEPAGE PITS, INSIDE DIAMETER 43 FT. DEPTH BELOW INLET 8 FT.

ABSORBENT AREA 340 SQ. FT.

REMARKS location ? seems to be about 50' farther back,  
but can repair to (X)

DATE SYSTEM APPROVED 8/19/72 INSPECTOR Leonard