




AVP  
 9B  
 Brown  
 20cm  
 11'  
 Red  
 Silty  
 10cm  
 Silty  
 5 1/2'  
 Yellow  
 Brown  
 Yellow  
 Silty  
 15 90  
 Rock  
 13'

9A  
 Brown  
 20cm  
 8"  
 Red  
 Silty  
 10cm  
 Silty  
 5 1/2'  
 Yellow  
 Brown  
 Silty  
 15 90  
 Rock  
 13'

Brown  
 10cm  
 1'  
 Red  
 Brown  
 Silty  
 10cm  
 Silty  
 5  
 Silty  
 (Quartz  
 pocket  
 on S. side  
 of hole  
 9 3-6'  
 6'  
 Yellow  
 Brown  
 Silty

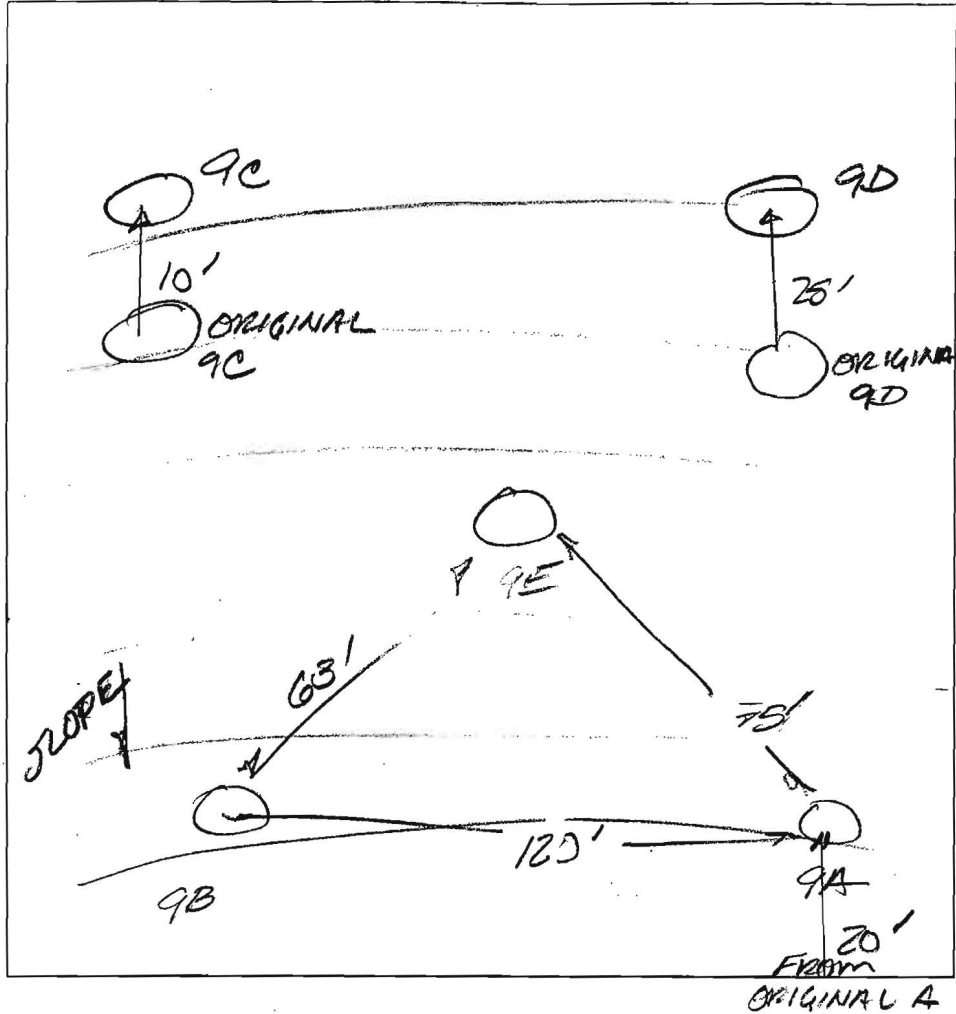

DATE	TEST #	DEPTH	START	BREAK 1" DROP	STOP 2" DROP	TIME OF 2nd INCH	P/F/H
1/22/03	9B	6' / 13'	11:42	11:45	11:50	5min	F
	9A	6' / 13'	12:46	12:49	12:56	7min	F
	9E	6 1/2' / 12'	1:23	1:26	1:29	3min	F

REMARKS 9C MOVED 10' UPHILL; 9D MOVED 25' UPHILL; 9A 20' UPHILL  
 SANITARIAN \_\_\_\_\_ BACKHOE \_\_\_\_\_ OTHERS \_\_\_\_\_  
 TEST HOLES USED IN SDA \_\_\_\_\_ AVG. PERC TIME \_\_\_\_\_ SQ. FT/BR \_\_\_\_\_  
 TRENCH WIDTH \_\_\_\_\_ INLET DEPTH \_\_\_\_\_ MAX. BOT DEPTH \_\_\_\_\_ EFFECTIVE SW \_\_\_\_\_

