

03-306917

EMERGENCY/TEMP NO. IF ANY

B 1 25694

SEQUENCE NO. (MDE USE ONLY)

STATE OF MARYLAND APPLICATION FOR PERMIT TO DRILL WELL 555292 please type

STATE PERMIT NUMBER

Ho-14-0135 fill in this form completely

Date Received (APA) 10/29/14

OWNER INFORMATION

Partner T/E Jonathan + Valerie 11703 Laurel Oak Ct Ellicott City MD 21042

LOCATION OF WELL

Howard Farside Ellicott City

DRILLER INFORMATION

C John Hess MWD 553 Allied Environmental Services PO Box 129 Annapolis Junction MD 20701

SOURCES OF DRILLING WATER

Public

11703 Laurel Oak Ct

ON WHICH SIDE OF ROAD (CIRCLE APPROPRIATE BOX)



DISTANCE FROM ROAD ENTER FT OR MI

TAX MAP 0023 BLK 0021 PARCEL 0126

WELL INFORMATION APPROX. PUMPING RATE 10 GAL. PER MIN. AVERAGE DAILY QUANTITY NEEDED 11000 GAL. PER DAY

USE FOR WATER (CIRCLE APPROPRIATE BOX)

- DOMESTIC POTABLE SUPPLY & RESIDENTIAL IRRIGATION (circled) FARMING (LIVESTOCK WATERING & AGRICULTURAL IRRIGATION) INDUSTRIAL, COMMERCIAL, DEWATERING PUBLIC WATER SUPPLY WELL TEST, OBSERVATION, MONITORING OPEN LOOP GEOTHERMAL CLOSED LOOP GEOTHERMAL

NOT TO BE FILLED IN BY DRILLER HEALTH DEPARTMENT APPROVAL

Howard 713 A512746 COUNTY NAME COUNTY NO. STATE SIGNATURE DATE ISSUED 11/10/14 CO SIGNATURE EXP. DATE 11/10/15

APPROXIMATE DEPTH OF WELL 400 FEET APPROXIMATE DIAMETER OF WELL 6 INCH NEAREST


PROPOSED LOCATION OF WELL ON LOT SHOW PERMANENT STRUCTURES SUCH AS BUILDINGS, SEPTIC SYSTEM, ROADS AND/OR LANDMARKS AND INDICATE NOT LESS THAN TWO DISTANCE MEASUREMENTS TO WELL

METHOD OF DRILLING (circle one)

- BORED (or Augered) JETTED Jetted & DRIVEN AIR-ROTARY AIR-PERCussion ROTARY (Hydraulic Rotary) CABLE REVerse-ROTary DRive-POINT other

REPLACEMENT OR DEEPEMED WELLS (CIRCLE APPROPRIATE BOX)

- THIS WELL WILL NOT REPLACE AN EXISTING WELL THIS WELL WILL REPLACE A WELL THAT WILL BE ABANDONED AND SEALED THIS WELL WILL REPLACE A WELL THAT WILL BE USED AS A STANDBY-CONTACT LOCAL APPROVING AUTHORITY FOR POLICY ON STANDBY WELLS THIS WELL WILL DEEPMEN AN EXISTING WELL PERMIT NUMBER OF WELL TO BE REPLACED OR DEEPEMED (IF AVAILABLE) Ho-14-2460

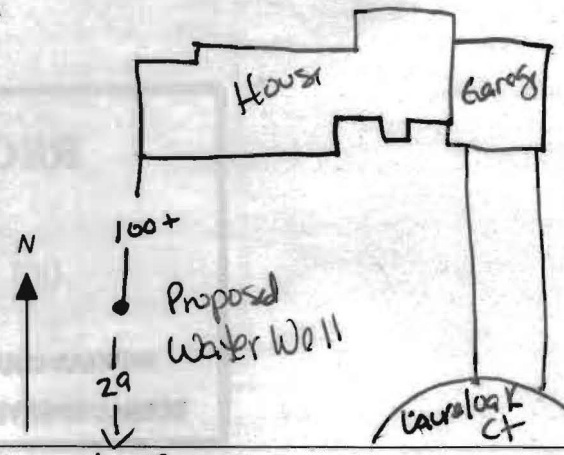

Not to be filled in by driller (MDE OR COUNTY USE ONLY) APPROX. PERMIT NUMBER G PERMIT No. Ho-14-0135

SPECIAL CONDITIONS Potable well must be 30' from geo bones.

Ex. Well to be sealed. ORIGINAL

B 1 **25694** SEQUENCE NO. (MDE USE ONLY) STATE OF MARYLAND APPLICATION FOR PERMIT TO DRILL WELL STATE PERMIT NUMBER  
 1 2 3 6 555292 please type Ho - 14 - 0135  
 70 fill in this form completely 79

Date Received (APA) 10/21/14  
 8 MM DD YY 13  
**OWNER INFORMATION**  
 15 Last Name Owner First Name 34  
 Partner T/E Jonathan + Valerie  
 36 Street or RFD 55  
 11703 Laurel Oak Ct  
 57 Town 70 State 72 Zip 76  
 Ellicott City MD 2012

B 3 **LOCATION OF WELL**  
 8 COUNTY 21  
 Howard  
 23 SUBDIVISION 42  
 Farside  
 SECTION 44 46 LOT 48 50  
 52 NEAREST TOWN 71  
 Ellicott City

**DRILLER INFORMATION**  
 C John Hess MWD 553  
 76 License No. 81  
 Driller's Name  
 Allied Environmental Services  
 Firm Name  
 PO Box 129 Annapolis Junction MD 20701  
 Address  
 C John Hess 10/18/14  
 Signature Date

B 4 **SOURCES OF DRILLING WATER**  
 1. Public  
 2.   
 3.   
 11 STREET ADDRESS 30  
 11703 Laurel Oak Ct  
 ON WHICH SIDE OF ROAD (CIRCLE APPROPRIATE BOX)  
 NORTH N WEST W EAST E SOUTH S  
 34 37  
 DISTANCE FROM ROAD  
 ENTER FT OR MI 38 39  
 TAX MAP: 002 BLK: 001 PARCEL 0126

B 2 **WELL INFORMATION**  
 1 2 APPROX. PUMPING RATE 10  
 (GAL. PER MIN.) 8 12  
 AVERAGE DAILY QUANTITY NEEDED 11000  
 (GAL. PER DAY) 14 20

**USE FOR WATER (CIRCLE APPROPRIATE BOX)**  
 D DOMESTIC POTABLE SUPPLY & RESIDENTIAL IRRIGATION  
 F FARMING (LIVESTOCK WATERING & AGRICULTURAL IRRIGATION)  
 I INDUSTRIAL, COMMERCIAL, DEWATERING  
 P PUBLIC WATER SUPPLY WELL  
 T TEST, OBSERVATION, MONITORING  
 O OPEN LOOP GEOTHERMAL  
 C CLOSED LOOP GEOTHERMAL

**NOT TO BE FILLED IN BY DRILLER HEALTH DEPARTMENT APPROVAL**  
 Howard 73 A512746  
 COUNTY NAME COUNTY NO.  
 STATE SIGNATURE INSERT S →  
 DATE ISSUED 11/10/15  
 43 MM DD YY 48 CO SIGNATURE EXP. DATE

APPROXIMATE DEPTH OF WELL 100 FEET  
 24 28  
 APPROXIMATE DIAMETER OF WELL 6 INCH  
 NEAREST INCH


**PROPOSED LOCATION OF WELL ON LOT**  
 SHOW PERMANENT STRUCTURES SUCH AS BUILDINGS, SEPTIC SYSTEM, ROADS AND/OR LANDMARKS AND INDICATE NOT LESS THAN TWO DISTANCE MEASUREMENTS TO WELL

**METHOD OF DRILLING (circle one)**  
 BORED (or Augered) JETTED Jetted & DRIVEN  
 30 AIR-ROTary AIR-PERCussion ROTARY (Hydraulic Rotary)  
 37 CABLE REVerse-ROTary Drive-POINT  
 other

**REPLACEMENT OR DEEPEMED WELLS (CIRCLE APPROPRIATE BOX)**  
 N THIS WELL WILL NOT REPLACE AN EXISTING WELL  
 Y THIS WELL WILL REPLACE A WELL THAT WILL BE ABANDONED AND SEALED  
 S THIS WELL WILL REPLACE A WELL THAT WILL BE USED AS A STANDBY-CONTACT LOCAL APPROVING AUTHORITY FOR POLICY ON STANDBY WELLS  
 D THIS WELL WILL DEEPEM AN EXISTING WELL  
 PERMIT NUMBER OF WELL TO BE REPLACED OR DEEPEMED (IF AVAILABLE) 41 Ho - 14 - 2160 52

**Not to be filled in by driller (MDE OR COUNTY USE ONLY)**  
 APPROP. PERMIT NUMBER G  
 PERMIT No. Ho - 14 - 0135  
 70 71 72 73 74 75 76 77 78 79

**SPECIAL CONDITIONS** Potable well must be 30' from geo bores.  
 NOTE APPROVING AUTHORITIES SHOULD USE SEPARATE SHEET IF NEEDED.

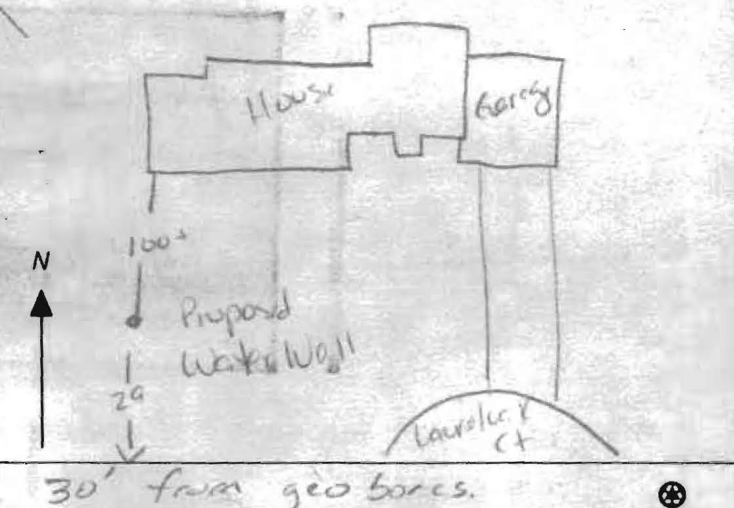



WELL DRILLING

P.O. Box 129

Annapolis Junction, MD 20701

p) 301-776-8370, f) 301-776-8374

[www.alliedwells.com](http://www.alliedwells.com)

December 30, 2014

Attn: Well and Septic Department.

OK - Power 1/8/15

Attached is permit HO-14-0135. We would like to request a refund.

We drilled two holes for permit HO-14-0134 for the geothermal loops and we never hit water so the customer cancelled the water well.

If you have any questions please call me at 301-776-8370.

Sincerely,

A handwritten signature in black ink that reads "Donna Perez". The signature is written in a cursive style with a large, looping "D" and "P".

Donna Perez

Operations Manager