


NOT TO SCALE

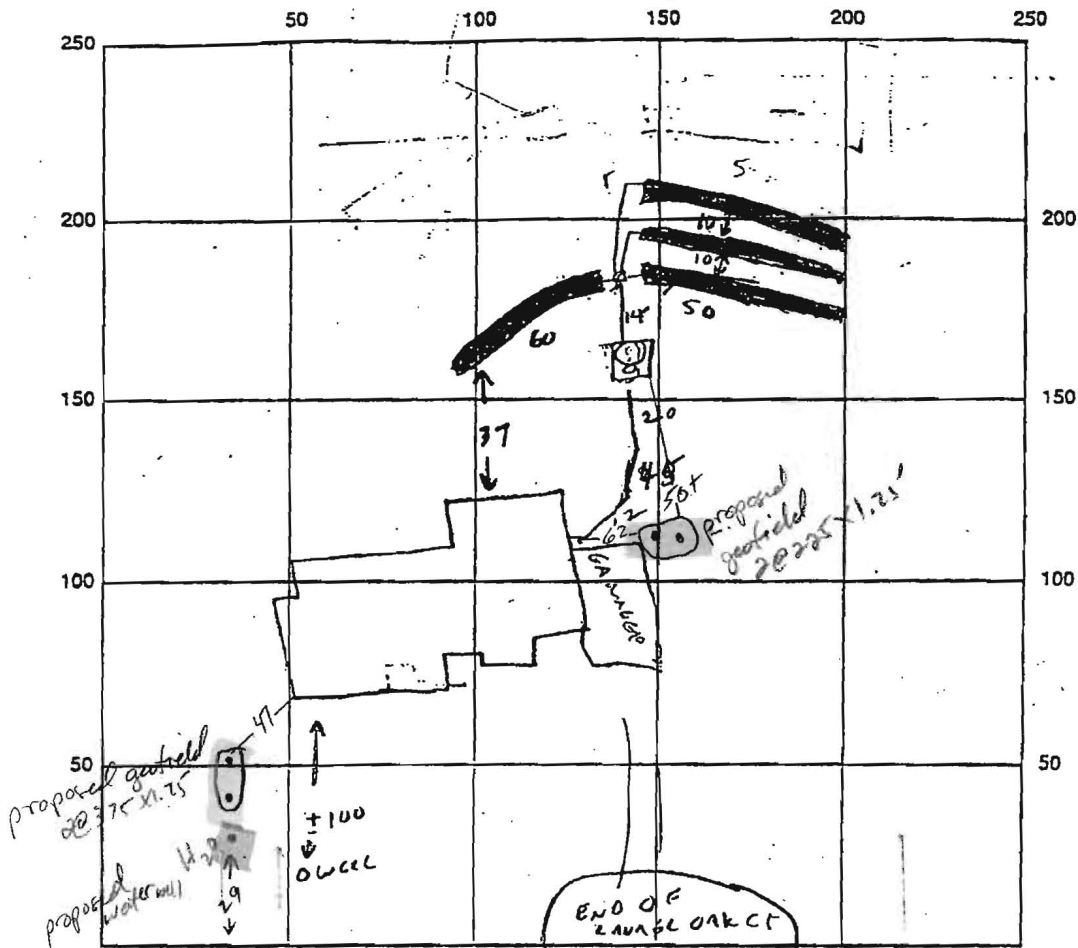

INDICATE NORTH - NAME ADJOINING ROADWAY AS BASE LINE

SEPTIC TANK LEVEL OK - 1500 gal CLEANOUTS one on sit. manhole on sit.

DISTRIBUTION BOX LEVEL OK

DRAIN FIELD/TITLE DEPTH 8 FT. TRENCH WIDTH 2 FT. INLET DEPTH 4 FT.

EFFECTIVE GRAVEL DEPTH 4 FT. TOTAL LENGTH 210 FT.

NUMBER OF TRENCHES 4 ^{1 @ 60'} _{3 @ 50'} ONE SIDEWALL/BOTTOM AREA 840 SQ. FT.

DRYWALL INSIDE DIAMETER — FT. EFFECTIVE DEPTH BELOW INLET — FT.

ABSORBENT AREA — SQ. FT.

REMARKS: HOUSE SEWER LINE + UPPER 2 TRENCHES COMPLETE. 1/13/00 CW


REMAINING TRENCHES COMPLETE 1/13/00 PM CW

1/14/00 FINAL INSP - OK TO COVER ALL SEPTIC WORK. DKS

1/14/00 WPI - Well line, P.A. 4.5' below grade, well casing 1.5' above grade, 2 pc cap OK, PVC conduit to be 18" big, then OK TO COVER.

DATE SYSTEM APPROVED 1/14/00 INSPECTOR [Signature]

NOT TO SCALE

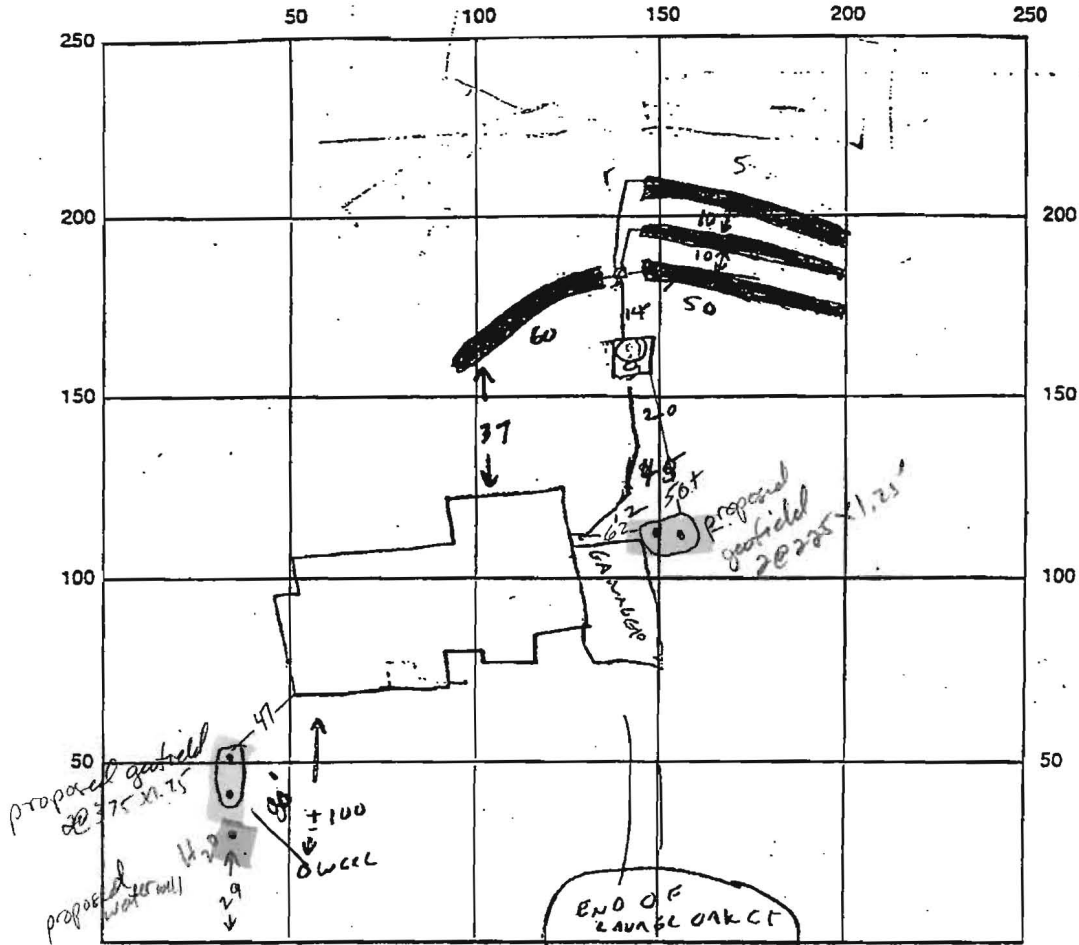

INDICATE NORTH - NAME ADJOINING ROADWAY AS BASE LINE

SEPTIC TANK LEVEL OK - 1500 gal

CLEANOUTS one on s.t. manhole on s.t.

DISTRIBUTION BOX LEVEL OK

DRAIN FIELD/TITLE DEPTH 8 FT. TRENCH WIDTH 2 FT. INLET DEPTH 4 FT.

EFFECTIVE GRAVEL DEPTH 4 FT. TOTAL LENGTH 210 FT.

NUMBER OF TRENCHES 4 ^{1 @ 60'} _{3 @ 50'} ONE SIDEWALL/BOTTOM AREA 840 SQ. FT.

DRYWALL INSIDE DIAMETER — FT. EFFECTIVE DEPTH BELOW INLET — FT.

ABSORBENT AREA — SQ. FT.

REMARKS: HOUSE SEWER LINE + UPPER 2 TRENCHES COMPLETE. 1/13/00 CW

REMAINING TRENCHES COMPLETE 1/13/00 PM CW

1/14/00 FINAL INSP - OK TO COVER ALL SEPTIC WORK. DKS

1/14/00 WPI - Well line, P.A. 4.5' below grade, well casing 1.5' above grade, 2 pc cap OK, PVC conduit to be 18" big. then OK TO COVER.

DATE SYSTEM APPROVED 1/14/00

INSPECTOR [Signature] DKS