

LAYOUT _____ INSP 4 _____
INSP 2 _____ INSP 5 _____
INSP 3 _____ INSP 6 _____

ISSUE DATE: 9/11/95

P 22122

APPROVAL DATE: 10/31/95

A 511659

PERMIT
INDEXED

TAX ID #05-362342

**ON-SITE SEWAGE DISPOSAL SYSTEM
HOWARD COUNTY HEALTH DEPARTMENT
BUREAU OF ENVIRONMENTAL HEALTH**

IS PERMITTED TO INSTALL ALTER

ADDRESS: _____ PHONE NUMBER: _____

SUBDIVISION: Aintree Estates LOT NUMBER: 11, Sec. 1

ADDRESS: 6289 Linkythorn Lane PROPERTY OWNER: Robert Ostrosky

SEPTIC TANK CAPACITY (GALLONS): _____ OUTLET BAFFLE FILTER REQUIRED

PUMP CHAMBER CAPACITY (GALLONS): _____ COMPARTMENTED TANK REQUIRED

NUMBER OF BEDROOMS: _____

SQUARE FEET PER BEDROOM: _____

LINEAR FEET OF TRENCH REQUIRED: _____

TRENCHES:	Trench to be _____ feet wide. Inlet _____ feet below original grade. Bottom maximum depth _____ feet below original grade. Effective area begins at _____ feet below original grade. _____ feet of stone below distribution pipe.
LOCATION:	
NOTES:	

PLANS APPROVED: _____ DATE: _____

- NOTE: PERMIT VOID AFTER 2 YEARS
- NOTE: CONTRACTOR RESPONSIBLE FOR SCHEDULING A PRE-CONSTRUCTION INSPECTION FOR ALL INSTALLATIONS
- NOTE: WATERTIGHT SEPTIC TANKS REQUIRED
- NOTE: ALL PARTS OF SEPTIC SYSTEM SHALL BE 100 FEET FROM ANY WATER WELL
- NOTE: MANHOLE RISERS REQUIRED ON ALL SEPTIC TANKS AND PUMP CHAMBERS UNLESS SPECIFICALLY AUTHORIZED

**NEITHER THE HOWARD COUNTY COUNCIL NOR THE HEALTH DEPARTMENT IS
RESPONSIBLE FOR THE SUCCESSFUL OPERATION OF ANY SYSTEM
PERMITTEE RESPONSIBLE FOR OBTAINING FINAL APPROVAL ON THIS PERMIT
CALL 410-313-2640 FOR INSPECTION OF SEPTIC SYSTEM**

A 511659

10/30/75
11/30/75

PERMIT

P-221221

A 11659

SEWAGE DISPOSAL SYSTEM

MARYLAND STATE DEPARTMENT OF HEALTH

HOWARD COUNTY

ELLICOTT CITY

DISTRICT 5th

INDEXED

05362342

DATE 9/11/75

Jack Pycok IS PERMITTED TO INSTALL ALTER

ADDRESS Ten Oaks Road, Glenelig, Md. PHONE 286-2939

A SEWAGE DISPOSAL SYSTEM LOCATED AT

SUBDIVISION ALPINE ESTATE ROAD 6200 Lakeshore Lane LOT 11, Sub. 1

PROPERTY OWNER Robert M. Meehan

ADDRESS 600 North Cliff, Rockville, Md. Phone: 762-8354

SPECIFICATIONS 4 bedrooms

DRAIN FIELD DEPTH FEET, BOTTOM AREA SQ. FT.

SEEPAGE PYS ABSORBENT SIDEWALL AREA SQ. FT.

SEPTIC TANK CAPACITY 1250 GALLONS

FOR GARBAGE GRINDER, INCREASE DISPOSAL AREA 25% & TANK CAPACITY 50%.

~~TRENCH - 400 sq. ft. absorbent sidewall area - one side - to begin below the first 4 ft. of original grade. Maximum depth permitted for trench is 10 ft. below original grade. Place trench 130 ft. from front lot line and 25 ft. from right sideline as shown manufacturing lot from the front. Septic tank - 750 gallon and 300 sq. ft. dry well for kitchen and garbage disposal and washer. Maximum depth permitted for dry well is 11 ft. below original grade; inlet at 4 ft.~~
PERMIT VOID AFTER THREE YEARS.


NOTE: ALL PIPE FROM HOUSE TO DISPOSAL AREA MUST BE CAST IRON.
NOTE: INSTALL STAND PIPE ON SEPTIC TANK AND DRY WELL. STAND PIPES MUST BE 6 INCHES IN DIAMETER. CAST IRON, CONCRETE OR TERRA COTTA ACCEPTED.

PLANS APPROVED BY J. Horgan & Donald W. Knaghen DATE 4/29/66 and 9/2/75

FILL SEPTIC TANK AND DISTRIBUTION BOX WITH WATER BEFORE CALLING FOR AN INSPECTION. COVER NO WORK UNTIL INSPECTED AND APPROVED.

NEITHER THE HOWARD COUNTY COMMISSIONERS NOR THE HEALTH DEPARTMENT IS RESPONSIBLE FOR THE SUCCESSFUL OPERATION OF ANY SYSTEM.

5114-59

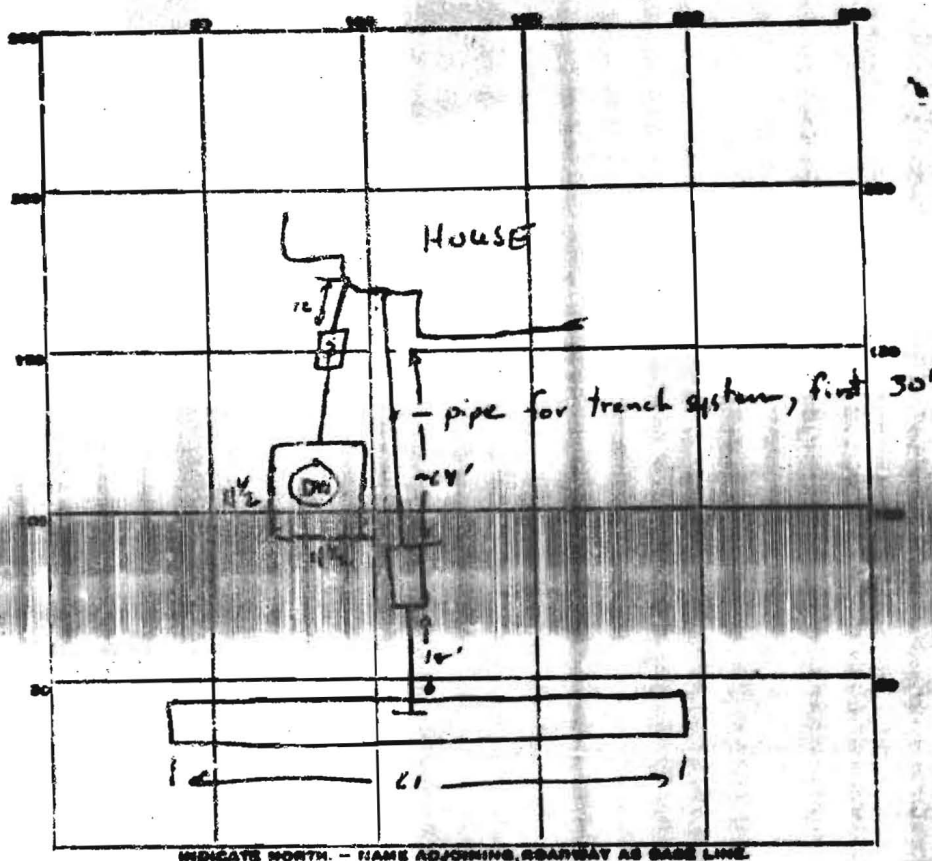

INDICATE NORTH - NAME ADJOINING ROADWAY AS BASE LINE.
 L111 KY THORN DL

PERMIT CARD

SEPTIC TANK, LEVEL CLEANOUTS

DISTRIBUTION BOX, LEVEL _____

TILE FIELD, DEPTH 11 FT. TRENCH WIDTH 2 FT.

GRAVEL DEPTH 7 ^{1/4} IN. TOTAL LENGTH 61 FT.

NUMBER OF TRENCHES 1 TOTAL SURFACE AREA 427 ^{sq ft}

SEEPAGE PITS, INSIDE DIAMETER 46 FT. DEPTH BELOW INLET 7 FT.

ABSORBENT AREA 326 ^{sq} FT.

REMARKS 10/30/75 DW system: 322 ft in DW; complete except for
 pipe for house to ST. WWB+HTZ
 10/21/75 system for Ketchum RM
 man. @ 12' ok; ok in trench to 11'

DATE SYSTEM APPROVED: 10/31/75 INSPECTOR: L. Macaul