




1/29/03  
10:30

SITE INSPECTION SHEET

OWNER: Robert Ostrosky PHONE #: (w) 301-740-3546  
 ADDRESS: 6289 Linky Thorn Lane CONTRACTOR: Easterday  
 WELL TAG #: 73-1029  
 SUBDIVISION: Centree Est I LOT: 11 COUNTY #: \_\_\_\_\_  
 PROPOSAL: low flow in ex. well, repl. requested

LOCATION DIAGRAM

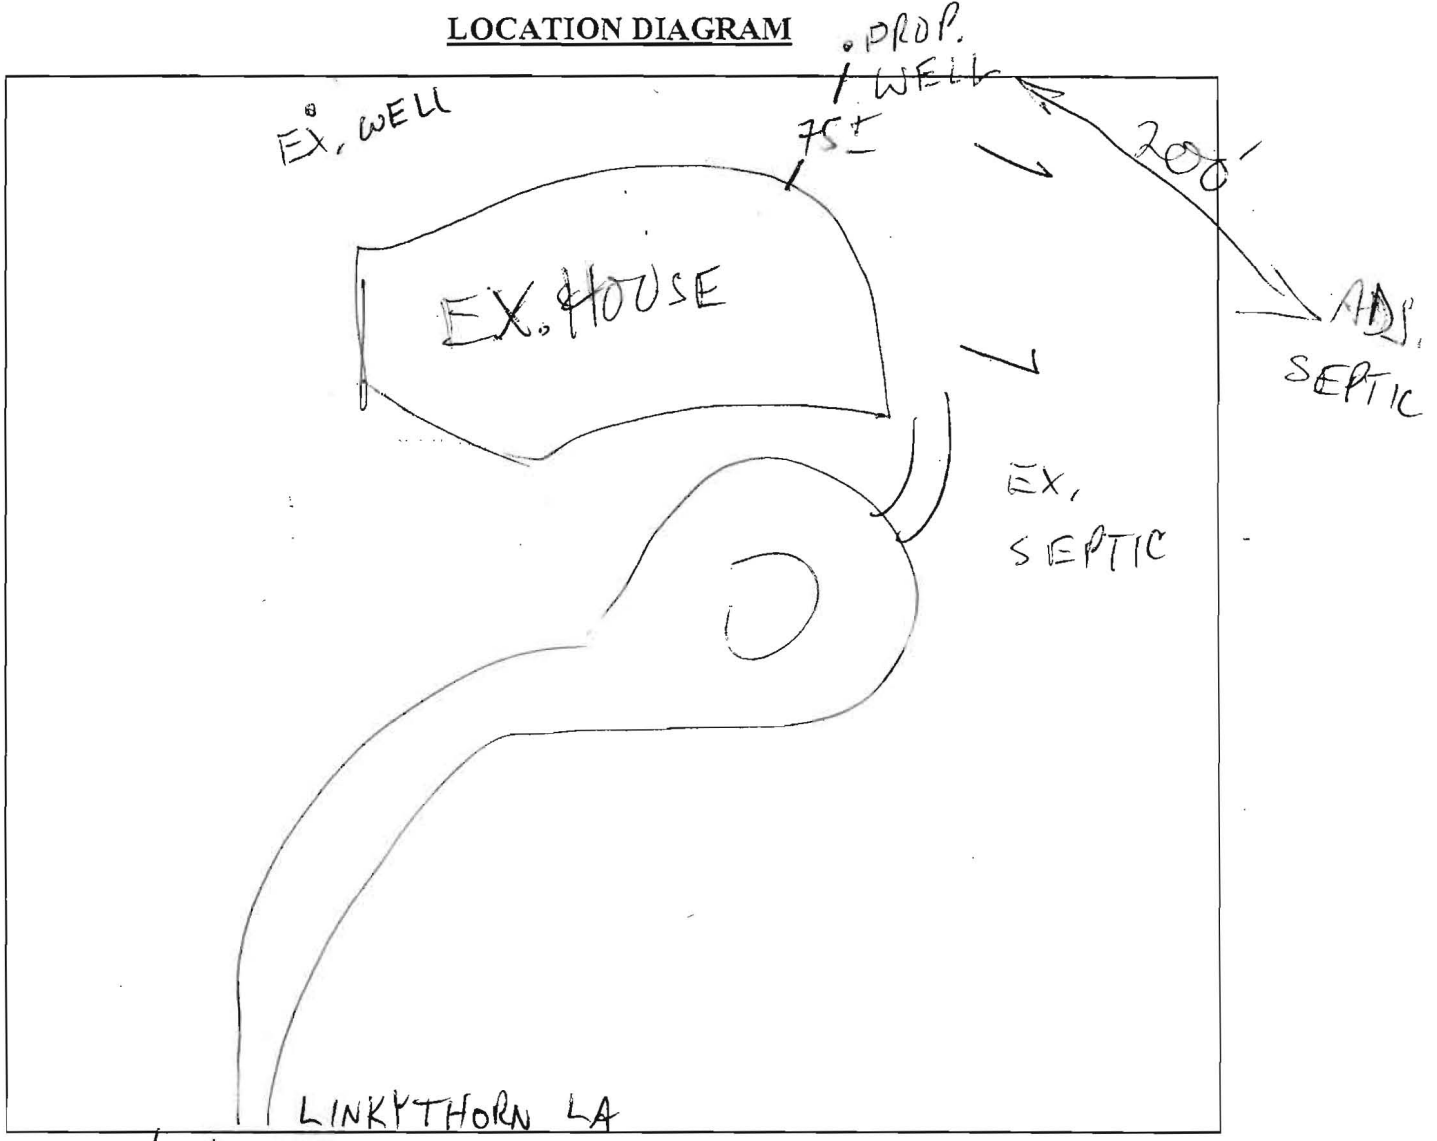

COMMENTS: 1/30/02 PROP. WELL SITE OK AS SHOWN (MR)

DATE: \_\_\_\_\_ INSPECTOR: \_\_\_\_\_