

5/2/74 - *Viewed*

# APPLICATION

A 11650

P \_\_\_\_\_

*needed.* SEWAGE DISPOSAL TESTING

MARYLAND STATE DEPARTMENT OF HEALTH

HOWARD COUNTY

ELLICOTT CITY

DISTRICT 5

DATE 3/30/66

*viewed hole*  
8/9/74  
9:30

*3 bedrooms - 1000 gal. septic tank.*

*Drain well 12 ft. in dia. by 9 ft. deep below the inlet located 115 ft. from the front property line and 25 ft. off the right side property line as seen when viewing the lot from road A. Locate inlet 3 ft. below original ground.*

TO: THE COUNTY HEALTH OFFICER  
ELLICOTT CITY, MARYLAND

I, HEREBY, APPLY FOR THE PERMIT TO CONSTRUCT A SEWAGE DISPOSAL SYSTEM.

PROPERTY OWNER \_\_\_\_\_

ADDRESS 301 Cedar Ave., N. W. - Washington, D. C. PHONE HO 5-1636

PROPERTY LOCATION:

SUBDIVISION Aintree Estates, Inc. LOT NO. 11, Sec. 1 *marked*

ROAD AND DESCRIPTION Road "A" *(Closest road to house)*

OCCUPANT \_\_\_\_\_ PHONE \_\_\_\_\_

PERSON TO CONSTRUCT SYSTEM \_\_\_\_\_

ADDRESS \_\_\_\_\_ PHONE \_\_\_\_\_

SIZE OF LOT 3.1 acres TYPE BLDG. 3 or 4  
NUMBER OF UNITS

IF NOT SINGLE RESIDENCE DESCRIBE \_\_\_\_\_

SIGNATURE OF APPLICANT /s/ Mr. Lincefield per Mr. Sutherland

APPROVED BY J. Henninger FOR J. Henninger DATE 4-21-66


REJECTED BY \_\_\_\_\_ FOR \_\_\_\_\_ DATE \_\_\_\_\_

HOLD PENDING FURTHER TESTS \_\_\_\_\_ DATE \_\_\_\_\_

REASONS FOR REJECTION OR HOLDING Michael Henninger (Architect)

706 S. Belgrade Rd.  
Beltsville, Md.  
644-5122 *(National)*  
762-8354

## THIS IS NOT A PERMIT

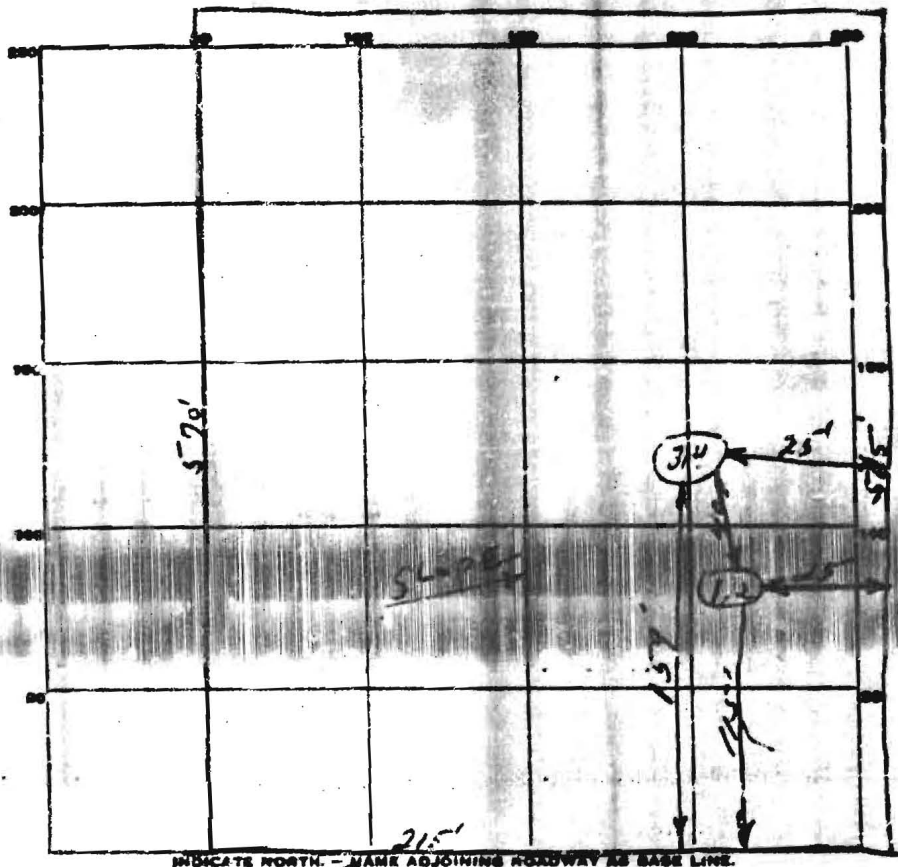

INDICATE NORTH - NAME ADJOINING ROADWAY AS BASE LINE.  
*Road "A"*

| DATE   | TEST NO. | DEPTH   | PRE-WET |      | TEST - 1" DROP |      | TIME   |
|--------|----------|---------|---------|------|----------------|------|--------|
|        |          |         | START   | STOP | START          | STOP |        |
| 4-6-66 | 1, Sand  | 10 1/2' | 2:10    | 2:13 | 2:13           | 2:19 | 6 min. |
|        | 2/Pit    | 5 1/2'  | 2:11    | 2:13 | 2:13           | 2:17 | 4 min. |
|        | 3, Sand  | 10'     | 2:25    | 2:29 | 2:29           | 2:35 | 6 min. |
|        | 4/Pit    | 5'      | 2:26    | 2:28 | 2:28           | 2:32 | 4 min. |
|        |          |         |         |      |                |      |        |
|        |          |         |         |      |                |      |        |
*av. fine  
 fine  
 10 min*

SOIL AUGER FINDING *Good after top 4 FT both pits.*  
 TESTED BY *J.H.*  
 REMARKS \_\_\_\_\_

