


H0-94-1239

A/P

(A)

Topsoil
 Or Sa Cl Loam
 2-2.5' Moderately Dense Beige Sa Loam
 3.5-4' ~10% Rock Moderately Dense Loamy Sa ~15% Rock
 13' Hard Bottom
 13.5'

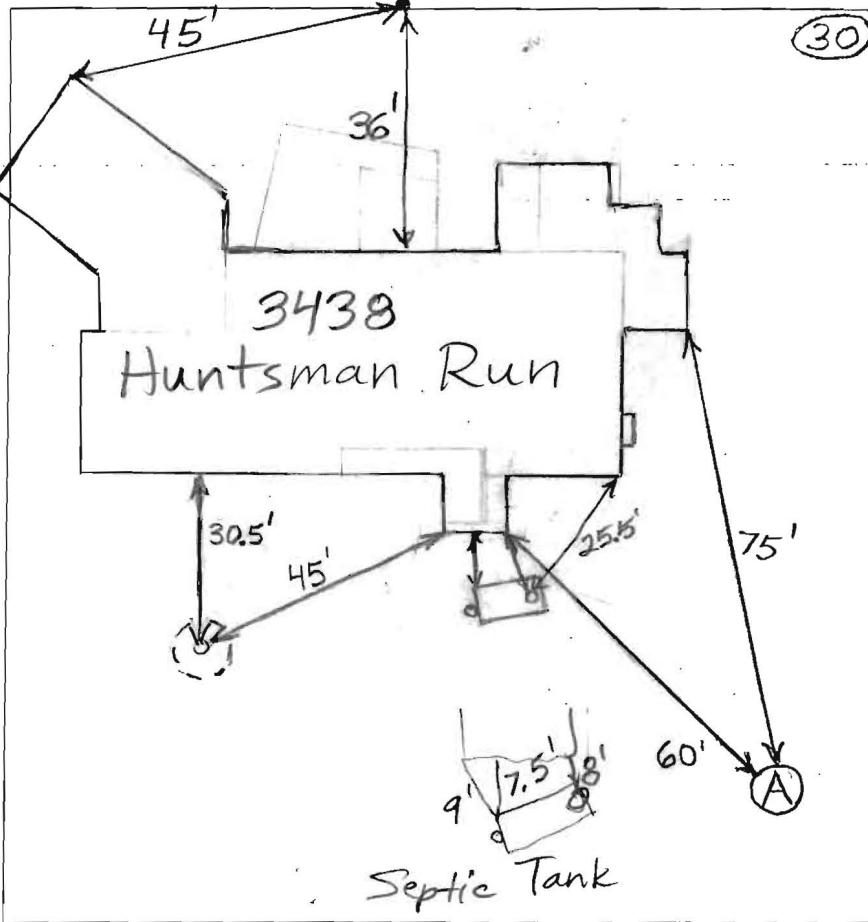

(30)

DATE	TEST #	DEPTH	START	BREAK 1" DROP	STOP 2" DROP	TIME OF 2ND INCH	P/F/H
5/5/14	A	4'/13.5'	11:49:30	11:55:30	12:06:45	11	P
		5'	12:19	12:22:45	12:28	5	P

REMARKS Water Poured in Bottom of Hole - Rate O.K.

SANITARIAN B. Baker BACKHOE R. Heaps OTHERS Homeowner

TEST HOLES USED IN SDA A AVG. PERC TIME _____ SQ. FT/BR _____

TRENCH WIDTH _____ INLET DEPTH _____ MAX. BOT DEPTH _____ EFFECTIVE S/W _____