

PUB. SEWER STATUS VERIFIED BY _____

ISSUE DATE: _____

P527916

APPROVAL DATE: 12/7/07

PERMIT

Tax ID # 01-166549

A REPAIR

ON-SITE SEWAGE DISPOSAL SYSTEM HOWARD COUNTY HEALTH DEPARTMENT BUREAU OF ENVIRONMENTAL HEALTH

South Carroll Backhoe Services

IS PERMITTED TO INSTALL ALTER

ADDRESS: 4410 Salem Bottom Road

PHONE NUMBER: 410-875-4197

SUBDIVISION: _____

LOT NUMBER: _____

ADDRESS: 5063 Landing Road

PROPERTY OWNER: George W. Gault

SEPTIC TANK CAPACITY (GALLONS): 1500 COMPARTMENTED TANK REQUIRED

PUMP CHAMBER CAPACITY (GALLONS): _____

NUMBER OF BEDROOMS: _____

SQUARE FEET PER BEDROOM: _____

LINEAR FEET OF TRENCH REQUIRED: _____

TRENCHES:	Trench to be _____ feet wide. Inlet _____ feet below original grade. Bottom maximum depth _____ feet below original grade. Effective area begins at _____ feet below original grade. _____ feet of stone below distribution pipe.
LOCATION:	
PURPOSE:	Existing septic system has failed. Call for inspection when ground is opened so sanitarian can recommend repair.

PLANS APPROVED: Stuart Oster

DATE: 11/21/2007

NOTE: PERMIT VOID AFTER 2 YEARS

NOTE: CONTRACTOR RESPONSIBLE FOR SCHEDULING A PRE-CONSTRUCTION INSPECTION FOR ALL INSTALLATIONS

NOTE: WATERTIGHT SEPTIC TANKS REQUIRED


NOTE: ALL PARTS OF SEPTIC SYSTEM SHALL BE 100 FEET FROM ANY WATER WELL

NOTE: MANHOLE RISERS REQUIRED ON ALL SEPTIC TANKS AND PUMP CHAMBERS

NEITHER THE HOWARD COUNTY COUNCIL OR THE HEALTH DEPARTMENT IS RESPONSIBLE FOR THE SUCCESSFUL OPERATION OF ANY SYSTEM PERMITTEE RESPONSIBLE FOR OBTAINING FINAL APPROVAL ON THIS PERMIT CALL 410-313-2640 FOR INSPECTION OF SEPTIC SYSTEM

*Earlier record
filed under
P57009*

NOT TO SCALE

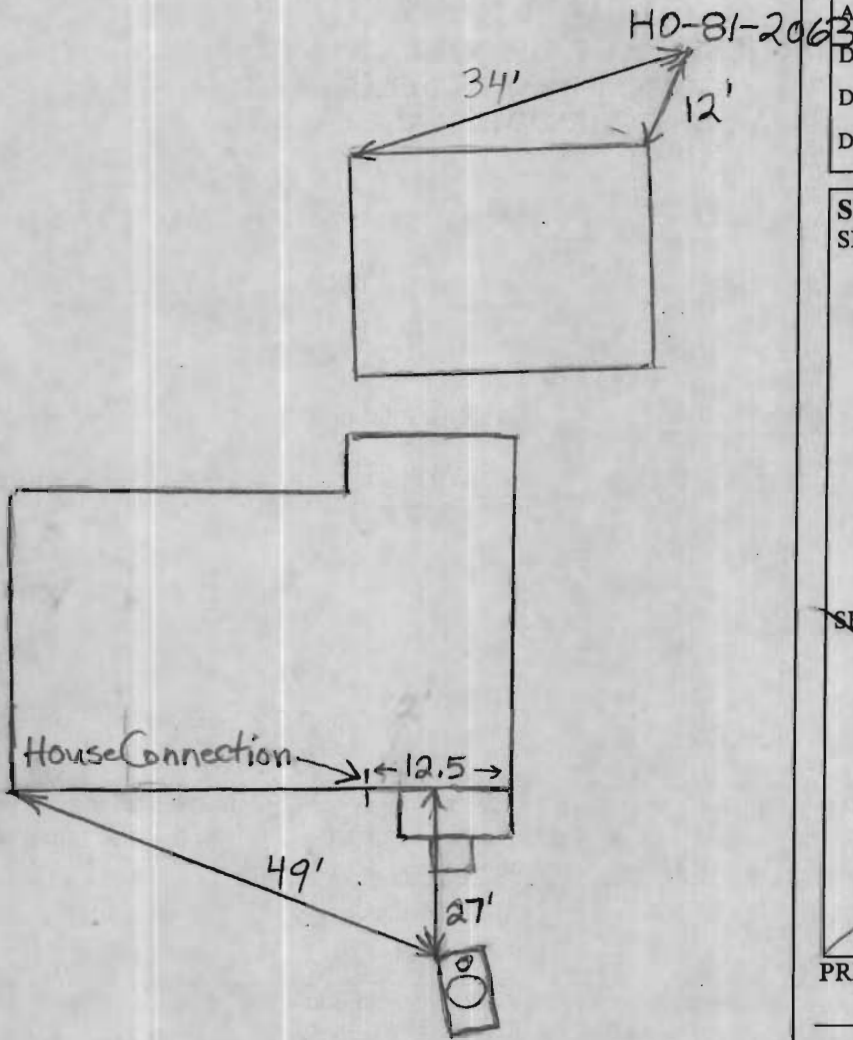

ROAD

TRENCH/DRAINFIELD DATA

WIDTH	INLET	BOTTOM
_____	_____	_____
NUMBER OF TRENCHES _____		
TOTAL LENGTH _____		
ABSORPTION AREA _____		
DISTRIBUTION BOX LEVEL _____		
DISTRIBUTION BOX BAFFLE _____		
DISTRIBUTION BOX PORT _____		

SEPTIC TANK DATA

SEPTIC TANK 1 LEVEL Yes

CAPACITY 1000 GAL

SEAM LOC Midseam

TANK LID DEPTH 3'

BAFFLES Yes

BAFFLE FILTER No

MANHOLE LOC Middle

6" PORT LOC Front

WATERTIGHT TEST No

SEPTIC TANK 2 LEVEL N/A

CAPACITY _____ GAL

SEAM LOC _____

TANK LID DEPTH _____

BAFFLES _____

BAFFLE FILTER _____

MANHOLE LOC _____

6" PORT LOC _____

WATERTIGHT TEST _____

PRE-CONSTRUCTION

INSTALLATION:

12/7/07 Nothing wrong with existing tank. Manhole riser installed BB

FINAL INSPECTOR

B. Baker

DATE OF APPROVAL

12/7/07

Fee Paid \$
Receipt #P

SEPTIC SYSTEM REPAIR / UPGRADE / EVALUATION REQUEST

Please fill out this form completely and check off the reason for the request:

Date requested: 11/21/07

Reason for Request

Failing System (includes surface discharge or inadequate treatment zone)

Has the contractor verified through excavation/pumping evaluation, that there are no pipe blockages?
Yes, it has caved in.

In support of a building permit. Type of building addition: _____

*System relocation for proposed addition for setback compliance _____

*Verification of adequate system capacity per COMAR 26.04.02.02D (4) _____

To replace collapsed septic tank or upgrade tank capacity

To replace collapsed drywell

Septic Contractor: South Carroll Backhoe Services

Contractor's Address: 4410 Salem Bottom Rd.
Westminster, Md. 21157

Contractor's Phone #: 410875-4197

Property Address: 5063 Landing Rd

Property (Subdivision) & Lot # Tx. map 31 Grid 31-11 parcel 164

Owner's Name: GFL Plumbing + Heating Inc

Is public sewer available/nearby: NO

Names of Any Previous Owners: Gault, George W.

Year House Built: 1959

of Existing Bedrooms: 3

of Bedrooms after completion of addition: N/A

Has this request been discussed previously with a Sanitarian, who? NO

If public sewer is close, further research will be performed to verify availability and possible hook up to public sewer.

A Sanitarian will be in contact within three business days depending upon the urgency of the situation to coordinate the scheduling of the repair /upgrade/evaluation. No inspection will be performed without fee collection at the office.

Environmental Sanitarian tentatively assigned _____

\$ 330

1500 gal
septic tank
2 compartment