

7/19/71 PM
after!

PERMIT

SEWAGE DISPOSAL SYSTEM

MARYLAND STATE DEPARTMENT OF HEALTH

HOWARD COUNTY

ELLCOTT CITY

DISTRICT 1

DATE 7/15/71

P 16110

A 15802

INDEXED

Paul Gregor

IS PERMITTED TO INSTALL ALTER

ADDRESS Hanover, Maryland

PHONE 796-0952

A SEWAGE DISPOSAL SYSTEM LOCATED AT _____

SUBDIVISION _____

5360

ROAD Landing Road

LOT 2

PROPERTY OWNER Christofer Robert Vale

ADDRESS _____

SPECIFICATIONS - 4 bedrooms

DRAIN FIELD _____ DEPTH _____ FEET, BOTTOM AREA _____ SQ. FT.

SEEPAGE PITS _____ ABSORBENT SIDE-WALL AREA _____ SQ. FT.

SEPTIC TANK CAPACITY 1,200 GALLONS

FOR GARBAGE GRINDER, INCREASE DISPOSAL AREA 22% & TANK CAPACITY 50%.

OTHER Dry well to be 400 sq. ft. of absorbent sidewall area below the inlet

pipe. Inlet pipe to begin 3 1/2 ft. below original grade. Maximum depth of dry well to be 12 ft. below original grade. Locate dry well 30 ft. from right side line and in original percolation hole no. 1-2 as lot is seen standing on front property line facing lot. If not clear refer to percolation sheet.

NOTE: ALL PIPE FROM HOUSE TO SEPTIC TANK MUST BE CAST IRON.

PERMIT VOID AFTER THREE YEARS.

THE BUILDING PERMIT FOR THIS PROPERTY WILL NOT BE SIGNED UNTIL THE SEPTIC SYSTEM IS INSTALLED AND APPROVED.

PLANS APPROVED BY James T. Wright DATE 4/29/71


FILL SEPTIC TANK AND DISTRIBUTION BOX WITH WATER BEFORE CALLING FOR AN INSPECTION. COVER NO WORK UNTIL INSPECTED AND APPROVED.

NEITHER THE HOWARD COUNTY COMMISSIONERS NOR THE HEALTH DEPARTMENT IS RESPONSIBLE FOR THE SUCCESSFUL OPERATION OF ANY SYSTEM.

BLDG. PERMIT SIGNED
AND RETURNED VLP/3

Serial # 52132
Page

A158022

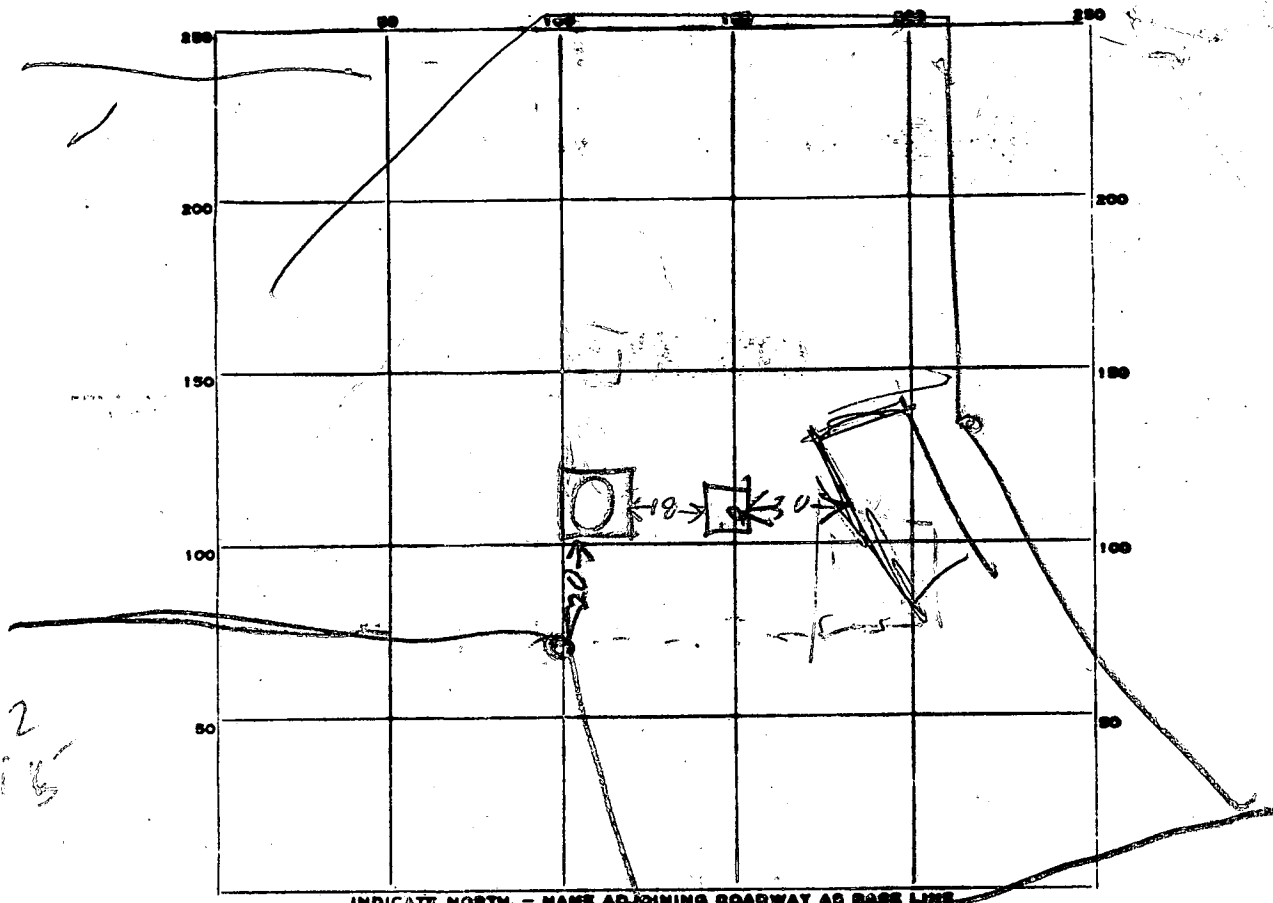

PERMIT CARD _____

SEPTIC TANK, LEVEL OK 1250 CLEANOUTS _____
concrete
 DISTRIBUTION BOX, LEVEL Top 1-1/2 FT below grade

TILE FIELD, DEPTH _____ FT. TRENCH WIDTH _____ FT.

GRAVEL DEPTH _____ IN. TOTAL LENGTH _____ FT.

NUMBER OF TRENCHES _____ TOTAL BOTTOM AREA _____

SEEPAGE PITS, INSIDE DIAMETER 8 FT. DEPTH BELOW INLET 9 FT.
225 not counting stone

ABSORBENT AREA 450 SQ. FT. *counting stone*

REMARKS 7/19/71 - Dry Well outlet to be 3 FT below grade
Permanently dry well 50 FT
House not yet built Location Dry Well is OK
Well not yet drilled

DATE SYSTEM APPROVED 7/19/71 INSPECTOR Raymond Hedges