


A#00887

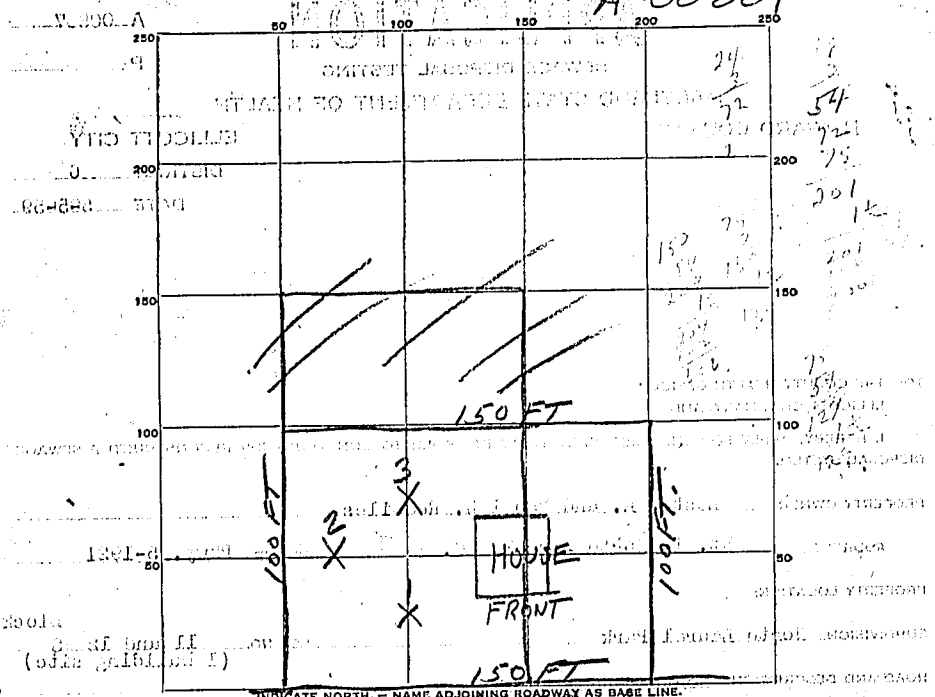

DATE	TEST NO.	DEPTH	PRE-WET		TEST - 1" DROP		TIME
			START	STOP	START	STOP	
5-14-59	1	3 FT.	1:38	1:40	1:40	1:47	7 Minutes
	2		1:40	1:43	1:43	1:57	14 Minutes
	3		1:41	1:43	1:43	1:49	6 Minutes

SOIL AUGER FINDING _____

TESTED BY *J.H.*

REMARKS *Public Water Supply*

ALSO PRESENT *Lester Williams* LOT NO. _____