

Scale 1" = 50 feet



APPROVED


WALK-THRU BUILDING PERMIT

BP# _____ A# 10005

APP. SAN SC DATE: 7/4/06


DESC. OF WORK:

40' x 16' in ground pool

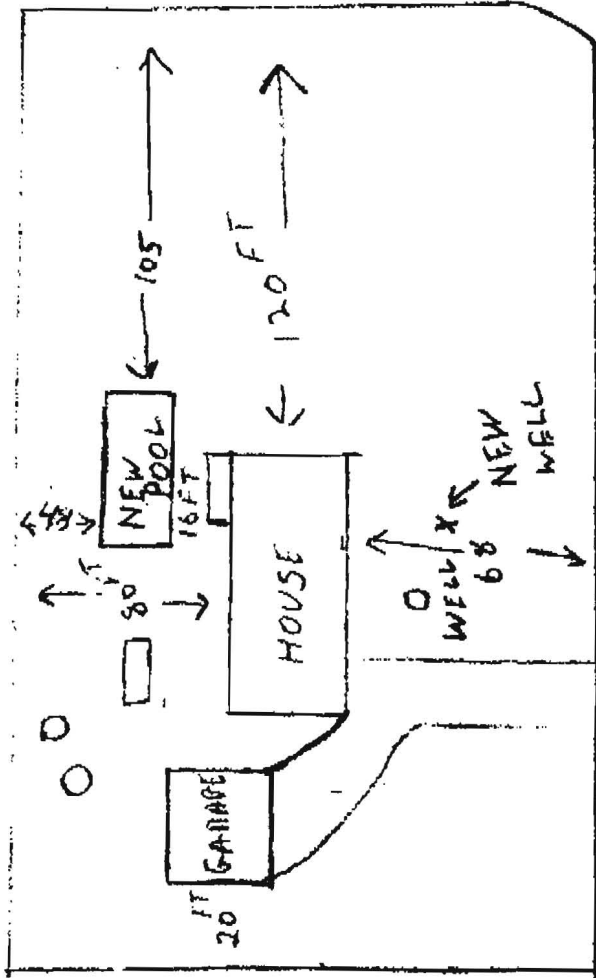


12570 Indian Hill Dr
Sylvestria, MO 64788

Scale 1" = 50 feet

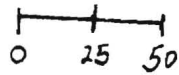

APPROVED

WALK-THRU BUILDING PERMIT
BP# B00158898A# 10005
APP. SAN SF DATE: 4/4/06
DESC. OF WORK: 40 x 16' inground pool
(P14345)

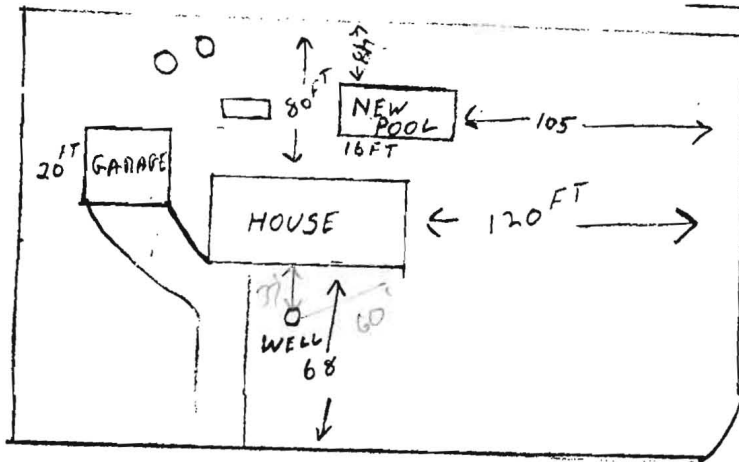

12570 Indian Hill Dr
Sykesville, MD 21784