

PERMIT

SEWAGE DISPOSAL SYSTEM

MARYLAND STATE DEPARTMENT OF HEALTH

HOWARD COUNTY

ELLICOTT CITY

DISTRICT 6

DATE June 8, 1959

P 01096
A 00887

INDEXED

Wesley M. Roby IS PERMITTED TO INSTALL ALTER

ADDRESS 11606 Baltimore Avenue, Beltsville, Maryland PHONE We 5-5663

A SEWAGE DISPOSAL SYSTEM LOCATED AT North Laurel Road - 1 mile off of Route #1

SUBDIVISION North Laurel Park ROAD _____

LOT 11 and 12
Block "B"
1 Bldg. Site

PROPERTY OWNER Lester E. and Naomi H. Redmiles

ADDRESS Route #1, North Laurel, Maryland

SPECIFICATIONS

DRAIN FIELD DEPTH 3 FEET, BOTTOM AREA 360 SQ. FT.

SEEPAGE PITS _____ ABSORBENT SIDE-WALL AREA _____ SQ. FT.

SEPTIC TANK CAPACITY 750 GALLONS

FOR GARBAGE GRINDER, INCREASE DISPOSAL AREA 22% & TANK CAPACITY 50%.


OTHER _____

PLANS APPROVED BY James Hennigan DATE 5/14/59

FILL SEPTIC TANK AND DISTRIBUTION BOX WITH WATER BEFORE CALLING FOR AN INSPECTION. COVER NO WORK UNTIL INSPECTED AND APPROVED.

NEITHER THE HOWARD COUNTY COMMISSIONERS NOR THE HEALTH DEPARTMENT IS RESPONSIBLE FOR THE SUCCESSFUL OPERATION OF ANY SYSTEM.

18800

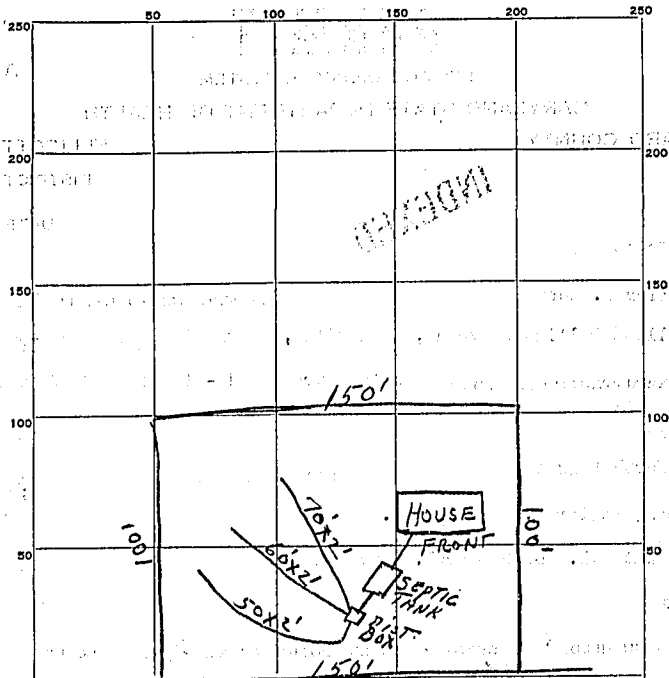

INDICATE NORTH. - NAME ADJOINING ROADWAY AS BASE LINE.

NORTH LAUREL ROAD

PERMIT CARD _____

SEPTIC TANK, LEVEL OK CLEANOUTS stand by

DISTRIBUTION BOX, LEVEL OK

TILE FIELD, DEPTH 3 FT. TRENCH WIDTH 2 FT.

GRAVEL DEPTH 2 ^{over} IN. TOTAL LENGTH 180 FT.

NUMBER OF TRENCHES 3 TOTAL BOTTOM AREA 360 sq. FT.

SEEPAGE PITS, INSIDE DIAMETER _____ FT. DEPTH BELOW INLET _____ FT.

ABSORBENT AREA 360 SQ. FT.

REMARKS _____

DATE SYSTEM APPROVED 8-5-59

INSPECTOR J. Hennigan