

# PERMIT

SEWAGE DISPOSAL SYSTEM

MARYLAND STATE DEPARTMENT OF HEALTH\*

P 33832

A \_\_\_\_\_

DISTRICT 5th

DATE 4/27/84

COMPLETE BUT NOT

DATE SYSTEM APPROVED 5/11/88

INSPECTOR CW

HOWARD COUNTY  
BUREAU OF ENVIRONMENTAL HEALTH  
461-9933

05-364442

p2/2

INDEXED

WM, REED

IS PERMITTED TO INSTALL \_\_\_\_\_ ALTER X

ADDRESS \_\_\_\_\_ PHONE \_\_\_\_\_

SUBDIVISION \_\_\_\_\_ ROAD \_\_\_\_\_ LOT \_\_\_\_\_

PROPERTY OWNER WILLIAM REED

ADDRESS 11865 LIME KILN RD.

IF GARBAGE GRINDER IS USED INCREASE SEPTIC TANK CAPACITY BY 50% AND ABSORPTION AREA BY 22%.

GARBAGE GRINDER? YES \_\_\_\_\_ NO \_\_\_\_\_

SEPTIC TANK CAPACITY \_\_\_\_\_ GALLONS NUMBER OF BEDROOMS \_\_\_\_\_

VERY SHALLOW SYSTEM, SEASONAL HIGH WATER TABLE

SEE ATTACHED FOR ADDITIONAL BACKGROUND.

PLANS APPROVED BY S. ABEL DATE 5/4/88

COVER NO WORK UNTIL INSPECTED AND APPROVED.

NEITHER THE HOWARD COUNTY COUNCIL NOR THE HEALTH DEPARTMENT IS RESPONSIBLE FOR THE SUCCESSFUL OPERATION OF ANY SYSTEM.

NOTE: CLEANOUT REQUIRED EVERY 70 FEET OF SEWER LINE AND/OR AT 90° SWEEPS IN LINES FROM HOUSE TO DRAIN FIELDS.

NOTE: ALL PARTS OF SEPTIC SYSTEMS (I.E., TANK, DISTRIBUTION BOX, TRENCHES) TO BE 100 FEET FROM WELL (UNLESS OTHERWISE SPECIFICALLY AUTHORIZED)

NOTE: IF DEEP TRENCHES ARE USED CALL FOR INSPECTION BEFORE AND AFTER PLACING GRAVEL IN TRENCHES.

NOTE: NO DRY WELL SHALL EXCEED 15 FOOT IN DIAMETER. NO ABSORPTION TRENCH TO EXCEED 100 FEET IN LENGTH.

NOTE: ALL PIPE FROM HOUSE TO SEPTIC TANK MUST BE CAST IRON OR SCHEDULE 40 PVC OR ABS.

PERMIT VOID AFTER TWO YEARS.

NOTE: INSTALL STAND PIPE ON SEPTIC TANK AND DRY WELL. STAND PIPES MUST BE 6 INCHES IN DIAMETER. CAST IRON, CONCRETE OR TERRA COTTA OR PVC OR ABS ACCEPTED. IF TOP OF SEPTIC TANK IS DEEPER THAN 3 FEET, MANHOLE TO GRADE REQUIRED.


NOTE: DISTRIBUTION BOXES MUST HAVE BAFFLES.

**\*INSTALLER IS RESPONSIBLE FOR OBTAINING FINAL APPROVAL ON THIS PERMIT**

\*CALL 461-9933 FOR INSPECTION OF SEPTIC SYSTEMS.

EH - 2-1186

P 33832

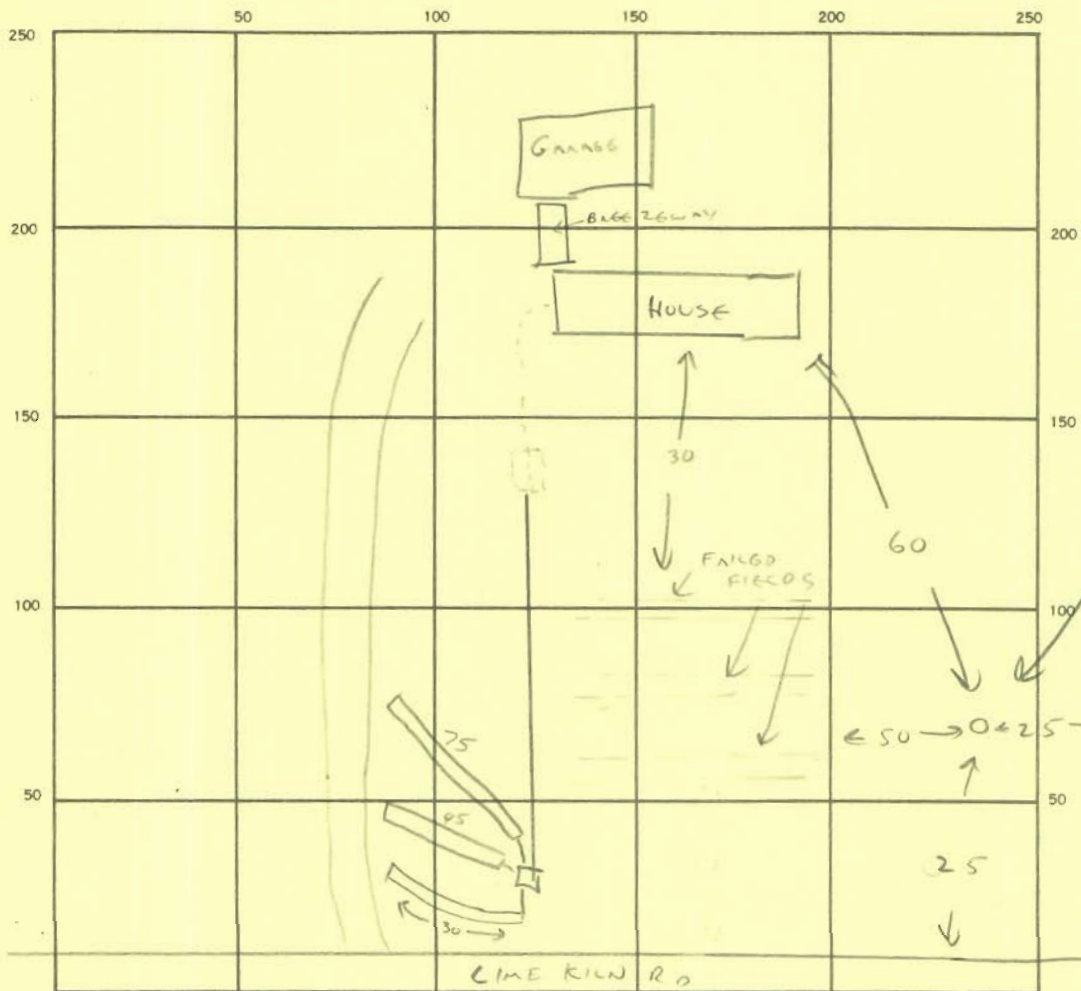

INDICATE NORTH - NAME ADJOINING ROADWAY AS BASE LINE.

SEPTIC TANK LEVEL EXISTING CLEANOUTS S.T. EXISTING

DISTRIBUTION BOX LEVEL ✓

DRAIN FIELD/TILE FIELD DEPTH \_\_\_\_\_ FT. TRENCH WIDTH \_\_\_\_\_ FT. INLET DEPTH \_\_\_\_\_ FT.

EFFECTIVE GRAVEL DEPTH \_\_\_\_\_ FT. TOTAL LENGTH \_\_\_\_\_ FT.

NUMBER OF TRENCHES \_\_\_\_\_ ONE SIDEWALL/BOTTOM AREA \_\_\_\_\_ SQ. FT.

DRYWELL INSIDE DIAMETER \_\_\_\_\_ FT. EFFECTIVE DEPTH BELOW INLET \_\_\_\_\_ FT.

ABSORBENT AREA \_\_\_\_\_ SQ. FT.

REMARKS 5/11/88 REPAIR TRENCHES INSTALLED TO APPROXIMATELY 5' TRENCH DEPT

TO ROAD PENETRATES GROUNDWATER - MUST BE DISCONNECTED AND FILLED. OTHER TWO TRENCHES

CLOSE TO CURBOUT WATER TABLE AND INT. MOTTLED SOIL. OWNER WILL INSTALL DRAINAGE SWALE

TRENCH ON HIGH SIDE OF DRIVEWAY IN ATTEMPT TO ALLOW BACK 2 TRENCHES TO REMAIN IN SERVICE.

WILL CONTACT US FOR INSPECTION. CW

- NO RECORD OF ADDITIONAL INSPECTION REQUEST AS OF 7/17/95 INDEX AS COMPLETE, NOT APPROVED (CW)

DATE SYSTEM APPROVED \_\_\_\_\_ INSPECTOR \_\_\_\_\_

9/23/87 11 AM  
5/4/88  
5/11/88

# PERMIT

P 33832  
A Repair

SEWAGE DISPOSAL SYSTEM

MARYLAND STATE DEPARTMENT OF HEALTH

HOWARD COUNTY  
BUREAU OF ENVIRONMENTAL HEALTH  
992-2330

ELLICOTT CITY  
DISTRICT 5th  
DATE 4/27/84

p1/2

Mr. William Reed IS PERMITTED TO INSTALL \_\_\_\_\_ ALTER X

ADDRESS 11865 Lime Kiln Road, Fulton, Md. 20759 PHONE 725-2375

SUBDIVISION \_\_\_\_\_ ROAD 11865 Lime Kiln Road LOT \_\_\_\_\_

PROPERTY OWNER Mr. William Reed

ADDRESS same as above (ACROSS FROM MAUCKS MEAT MKT.)

IF GARBAGE GRINDER IS USED INCREASE SEPTIC TANK CAPACITY BY 50% AND ABSORPTION AREA BY 22%.

GARBAGE GRINDER? YES \_\_\_\_\_ NO \_\_\_\_\_

SEPTIC TANK CAPACITY \_\_\_\_\_ GALLONS NUMBER OF BEDROOMS \_\_\_\_\_

REPAIR - Call for an appointment when ground is opened up and Sanitarian will recommend the repair system.

5-4-88 Repair UPH-11 HOPING TO ADD CAPACITY FOR FUTURE ADDITION

MAINTAIN SHALLOW TRENCH w/18" OF STONE - INLET	WATER TABLE ON LOW SIDE PREVENTS <sup>MAJOR</sup> EXPANSION.
3-4' MAX w/18" STONE REPLACE DIST. BOX, CHECK	NO PROBLEM WITH EXISTING SYSTEM.
OUTLET BAFEL FOR FUNCTION PLACE DB CLOSE TO Lime Kiln Rd. + RUN TRENCHES ON CONTOUR TOWARD LEFT OF LOT	EXPANSION LIMITED TO (BR ONLY). ANY FURTHER EXPANSION WOULD REQUIRE
INSTALL ISOLE OF TRENCH w/ 9' CENT. TO CONT SEPARATION.	ADDITION TO SEPTIC AND TRENCH IS NOT ADEQUATE ROOM FOR REQ'D REPLACEMENT SYSTEMS
PLANS APPROVED BY <u>S. M. Frank A. Skinner</u>	DATE <u>4/27/84</u>

COVER NO WORK UNTIL INSPECTED AND APPROVED.

NEITHER THE HOWARD COUNTY COUNCIL NOR THE HEALTH DEPARTMENT IS RESPONSIBLE FOR THE SUCCESSFUL OPERATION OF ANY SYSTEM.

NOTE: IF TRENCH IS USED CALL FOR INSPECTION BEFORE AND AFTER PLACING GRAVEL IN TRENCH.

NOTE: NO DRY WELL SHALL EXCEED 15 FOOT IN DIAMETER. NO ABSORPTION TRENCH TO EXCEED 100 FEET IN LENGTH.

NOTE: ALL PIPE FROM HOUSE TO SEPTIC TANK MUST BE CAST IRON OR SCHEDULE 40 PVC OR ABS.

PERMIT VOID AFTER THREE YEARS.

NOTE: INSTALL STAND PIPE ON SEPTIC TANK AND DRY WELL. STAND PIPES MUST BE 6 INCHES IN DIAMETER. CAST IRON, CONCRETE OR TERRA COTTA, OR PVC OR ABS ACCEPTED. IF TOP OF SEPTIC TANK IS DEEPER THAN 3 FEET MANHOLE TO GRADE REQUIRED.

BLDG. PERMIT SIGNED  
AND RETURNED 12/4/87  
Serial # 15361-dab



BLDG. PERMIT SIGNED  
AND RETURNED 10/5/82  
Serial # 14904  
Garage Storage

A 33832

**\*INSTALLER IS RESPONSIBLE FOR OBTAINING FINAL APPROVAL ON THIS PERMIT**

P 33832

REED  
11865 LIMSKILN RD

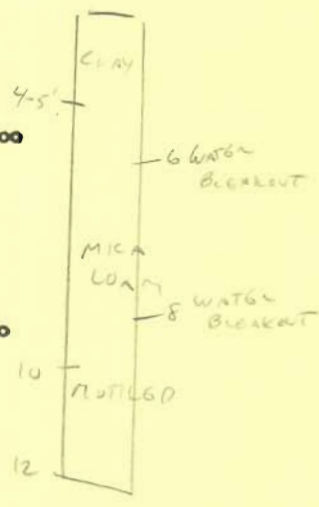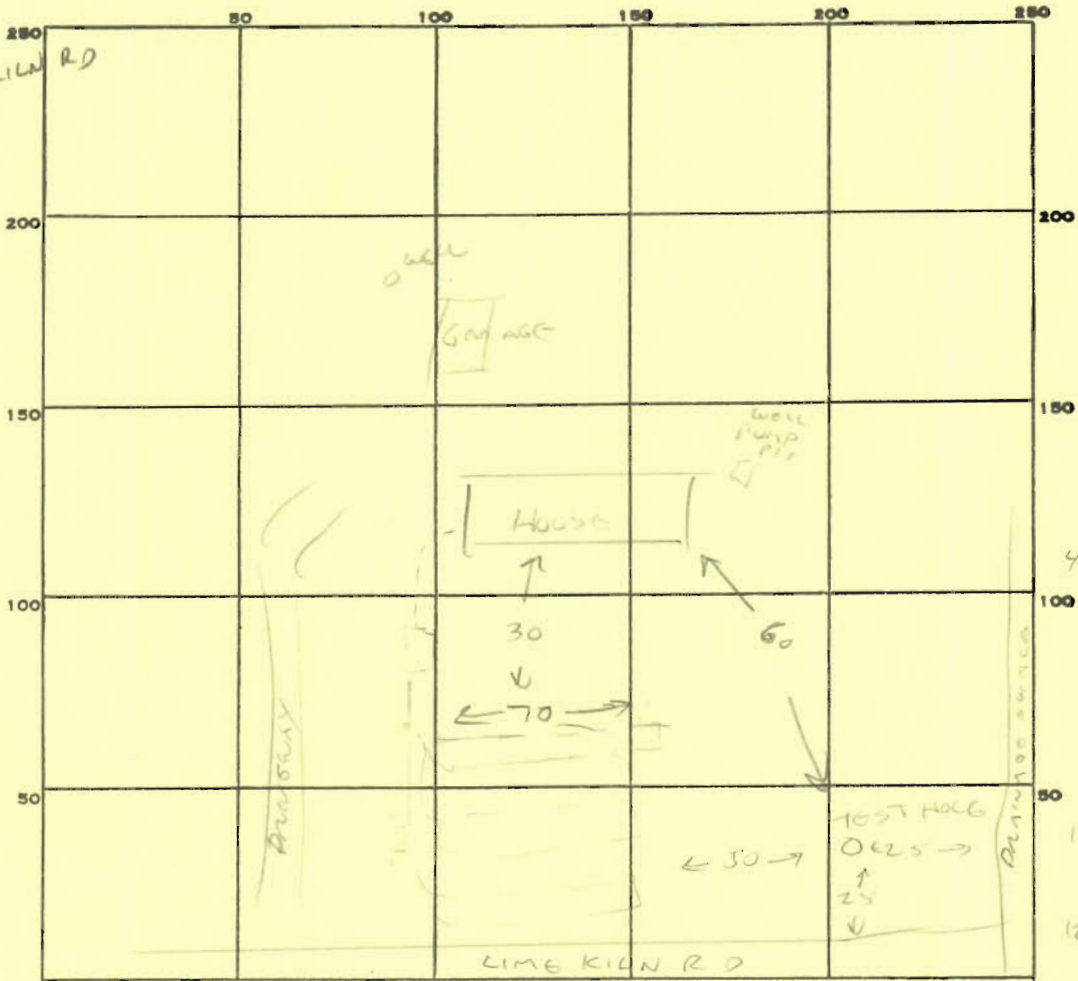

INDICATE NORTH. - NAME ADJOINING ROADWAY AS BASE LINE.

PERMIT CARD \_\_\_\_\_

SEPTIC TANK, LEVEL \_\_\_\_\_ CLEANOUTS \_\_\_\_\_

DISTRIBUTION BOX, LEVEL \_\_\_\_\_

TILE FIELD, DEPTH \_\_\_\_\_ FT. TRENCH WIDTH \_\_\_\_\_ FT.

GRAVEL DEPTH \_\_\_\_\_ IN. TOTAL LENGTH \_\_\_\_\_ FT.

NUMBER OF TRENCHES \_\_\_\_\_ TOTAL BOTTOM AREA \_\_\_\_\_

SEEPAGE PITS, INSIDE DIAMETER \_\_\_\_\_ FT. DEPTH BELOW INLET \_\_\_\_\_ FT.

ABSORBENT AREA \_\_\_\_\_ SQ. FT.

REMARKS 9/23/87 TEST HOLE WET AT 6', CLAY TO 5' - FAILED.

NO ROOM TO INCREASE SEPTIC AREA ANY LOWER ON PROPERTY.

SYSTEM IS FUNCTIONING OK AT THIS TIME.

ADEQUATE AREA REMAINS FOR 2 REPAIR SYSTEMS,

1. BR. CONVERSION OK - ADDITIONAL BEDROOMS CANNOT BE ACCOMMODATED.

\* SYSTEM LATER REPAIRED (5/11/89) - SAME PERMIT, SEE ATTACHED. C Williams

DATE SYSTEM APPROVED \_\_\_\_\_ INSPECTOR \_\_\_\_\_