

C1 9586

SEQUENCE NO. (DENV USE ONLY)

STATE OF MARYLAND WELL COMPLETION REPORT

THIS REPORT MUST BE SUBMITTED WITHIN 45 DAYS AFTER WELL IS COMPLETED.

(THIS NUMBER IS TO BE PUNCHED IN COLS. 3-6 ON ALL CARDS)

COUNTY NUMBER 42143

DATE Received

DATE WELL COMPLETED

Depth of Well (TO NEAREST FOOT)

PERMIT NO. FROM "PERMIT TO DRILL WELL"

OWNER STREET OR RFD SUBDIVISION SECTION LOT

WELL LOG Not required for driven wells STATE THE KIND OF FORMATIONS PENETRATED, THEIR COLOR, DEPTH, THICKNESS AND IF WATER BEARING

Table with columns: DESCRIPTION, FEET (FROM, TO), Check if water bearing. Includes handwritten entries for sandstone and clay mica rock.

GROUTING RECORD WELL HAS BEEN GROUTED TYPE OF GROUTING MATERIAL CEMENT BENTONITE CLAY NO. OF BAGS NO. OF POUNDS

CASING RECORD casing types insert appropriate code below MAIN CASING TYPE Nominal diameter Total depth

OTHER CASING (if used) diameter inch depth (feet) from to

SCREEN RECORD screen type or open hole insert appropriate code below

DEPTH (nearest ft.) E A C H S C R E E N SLOT SIZE 1 2 3 DIAMETER OF SCREEN (NEAREST INCH)

CIRCLE APPROPRIATE LETTER A WELL WAS ABANDONED AND SEALED WHEN THIS WELL WAS COMPLETED

I HEREBY CERTIFY THAT THIS WELL HAS BEEN CONSTRUCTED IN ACCORDANCE WITH COMAR 10.17.13 "WELL CONSTRUCTION"

DRILLERS IDENT. NO.

DRILLERS SIGNATURE (MUST MATCH SIGNATURE ON APPLICATION)


SITE SUPERVISOR (sign. of driller or journeyman responsible for sitework if different from permittee)

GRAVEL PACK IF WELL DRILLED WAS FLOWING WELL INSERT F IN BOX 68

OEP USE ONLY (NOT TO BE FILLED IN BY DRILLER) T (E.R.O.S.) WQ TELESCOPE CASING LOG INDICATOR OTHER DATA

PUMPING TEST HOURS PUMPED PUMPING RATE METHOD USED TO MEASURE PUMPING RATE WATER LEVEL TYPE OF PUMP USED

PUMP INSTALLED DRILLER WILL INSTALL PUMP YES NO CAPACITY: GALLONS PER MINUTE PUMP HORSE POWER PUMP COLUMN LENGTH CASING HEIGHT

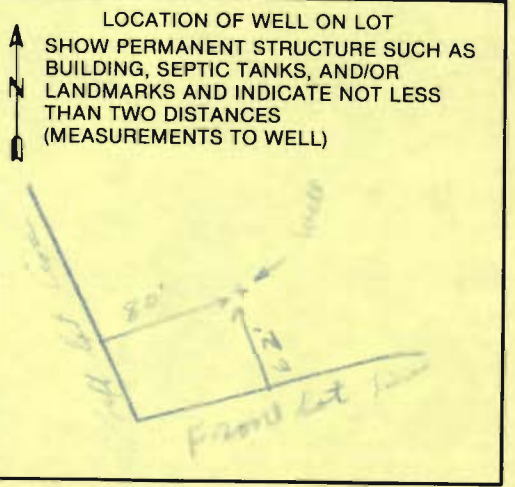

B 1 **1299** SEQUENCE NO. (DP USE ONLY)

(THIS NUMBER IS TO BE PUNCHED IN COLS. 3-6 ON ALL CARDS)

**STATE OF MARYLAND PERMIT TO DRILL WELL**

please print or type

STATE PERMIT NUMBER

**10-88-0555**

fill in this form completely

**OWNER INFORMATION**

Date Received (APA) **070588**

8 COUNTY **070588** 13

15 Last Name **JAMES** Owner First Name **JAMES** 34

36 Street or RFD **747** 55

57 Town **CLARKVILLE** 70 State 72 **MD** Zip 76 **21286**

**DRILLER INFORMATION**

Driller's Name **Joseph P. Mayne** 77 License No. 80 **238**

Firm Name **Joseph P. Mayne Well Drilling**

Address **5512 Hilton Rd. Mt. Airy 21271**

Signature **Joseph P. Mayne** Date **6/27/88**

**WELL INFORMATION**

APPROX. PUMPING RATE (GAL. PER MIN.) **0000**

AVERAGE DAILY QUANTITY NEEDED (GAL. PER DAY) **0000**

**USE FOR WATER (CIRCLE APPROPRIATE BOX)**

HOME (SINGLE OR DOUBLE HOUSEHOLD UNIT ONLY)

FARMING (LIVESTOCK WATERING & AGRICULTURAL IRRIGATION)

INDUSTRIAL, COMMERCIAL, STATE AND FEDERAL GOV. OTHER (REQUIRES APPROPRIATION PERMIT)

PUBLIC OR PRIVATE WATER COMPANY (REQUIRES APPROPRIATION PERMIT AND STATE HEALTH DEPARTMENT APPROVAL)

TEST, OBSERVATION, MONITORING (MAY REQUIRE APPROPRIATION PERMIT)

APPROXIMATE DEPTH OF WELL **000** FEET

APPROXIMATE DIAMETER OF WELL **6** INCH

**METHOD OF DRILLING (circle one)**

BORED (or Augered)  JETTED  Jetted & DRIVEN

AIR-ROTary  AIR-PERCussion  ROTARY (Hydraulic Rotary)

CABLE  REVERSE-ROTary  Drive-POINT

other \_\_\_\_\_

**REPLACEMENT OR DEEPEMED WELLS (CIRCLE APPROPRIATE BOX)**

THIS WELL WILL NOT REPLACE AN EXISTING WELL

THIS WELL WILL REPLACE A WELL THAT WILL BE ABANDONED AND SEALED

THIS WELL WILL REPLACE A WELL THAT WILL BE USED AS A STANDBY

THIS WELL WILL DEEPEM AN EXISTING WELL

PERMIT NUMBER OF WELL TO BE REPLACED OR DEEPEMED (IF AVAILABLE) 41 \_\_\_\_\_ 52

Not to be filled in by driller (OEP USE ONLY)

APPROX. PERMIT NUMBER \_\_\_\_\_ GAP \_\_\_\_\_

FORCE **500** WRITE INITIALS IN BOX PERMIT NO. **10-88-0555**

SPECIAL CONDITIONS

**LOCATION OF WELL**


8 COUNTY **070588** 21

23 SUBDIVISION **PAFULENT WILKS** 42

SECTION **44** 46 LOT **1** 50 **HAP29 P40 L2**

52 NEAREST TOWN **CLARKVILLE** 71

MILES FROM TOWN (enter 0 if in town) **1/2** MI

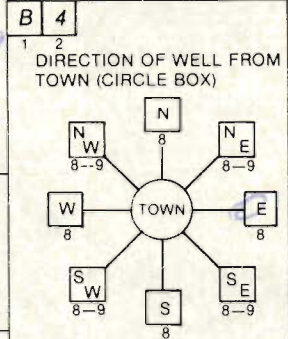

**NEAR WHAT ROAD** **MD 108 Clarksville Pike**

ON WHICH SIDE OF ROAD (CIRCLE APPROPRIATE BOX)

NORTH  WEST  EAST  SOUTH

DISTANCE FROM ROAD **000**

ENTER FT or MI **00**

**NOT TO BE FILLED IN BY DRILLER HEALTH DEPARTMENT APPROVAL**

County Name **Howard** County No. **42143**

STATE SIGNATURE \_\_\_\_\_ INSERT S

DATE ISSUED **6/21/88** CO SIGNATURE **Ch. W. ...** EXP. DATE **1/15/88**

NORTH GRID **506000** EAST GRID **0821000**

**SHOW MAJOR FEATURES OF BOX & LOCATE WELL WITH AN X**

**SOURCES OF DRILLING WATER**

1. **100 ft**



2. \_\_\_\_\_


3. \_\_\_\_\_

WRITE THE BOX NUMBER FROM THE MAP HERE

**8201**


**5006**

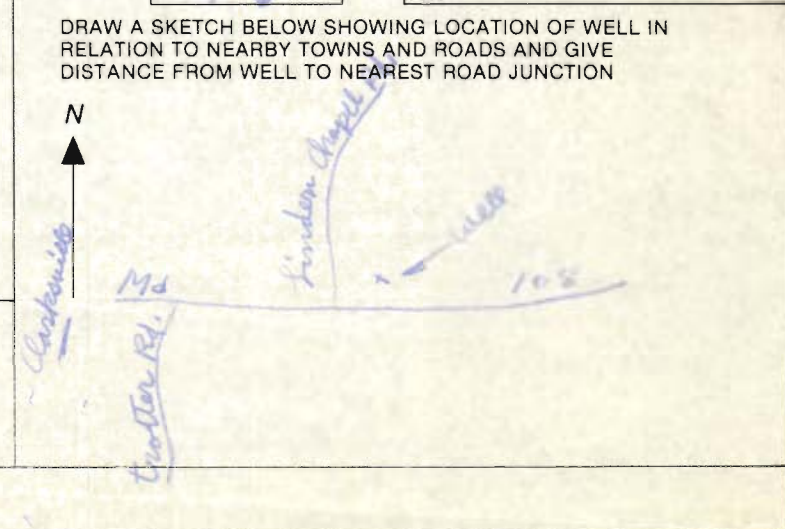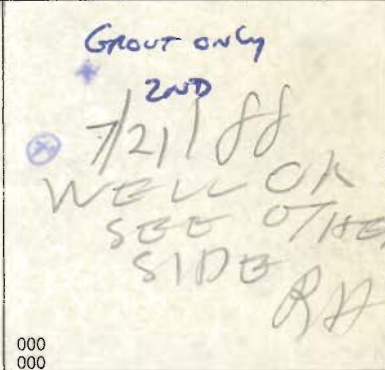


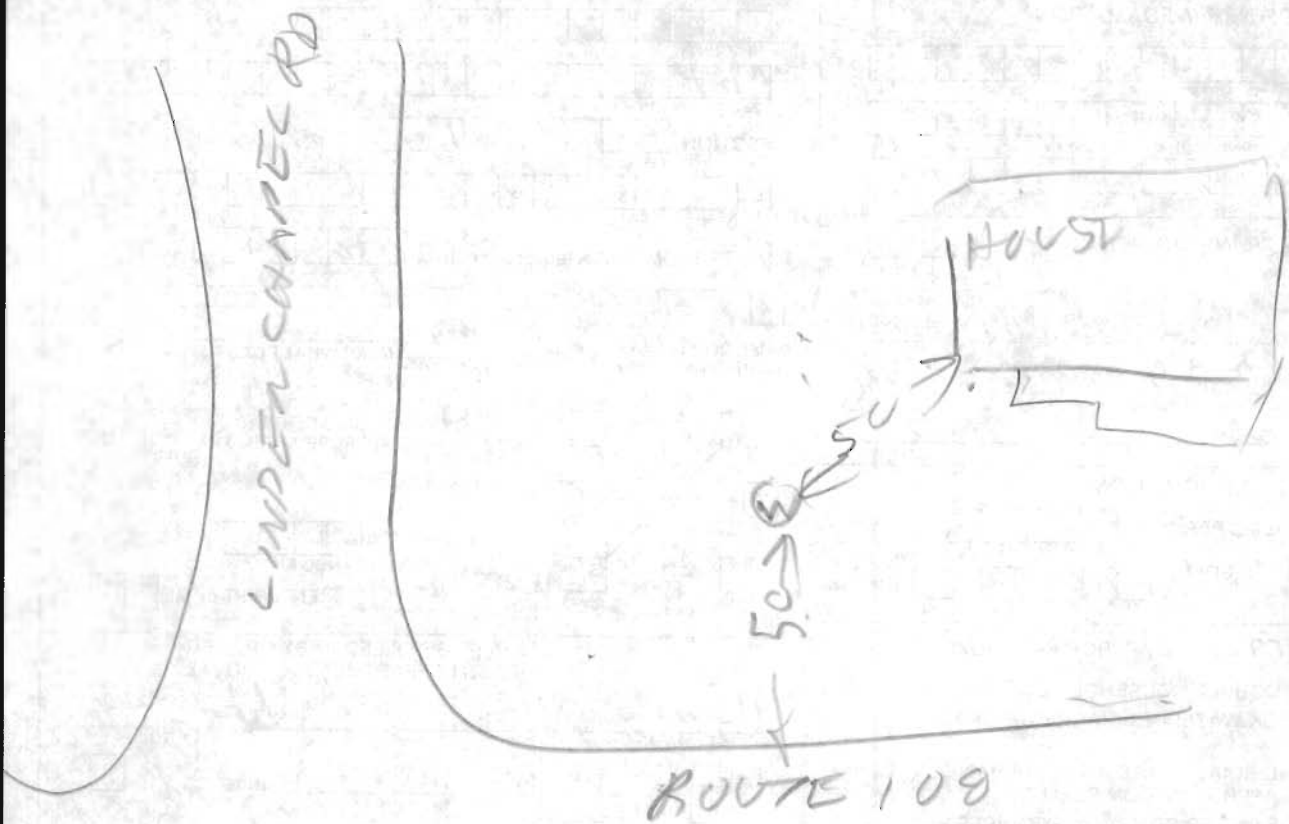

- ① 35 FT open Hole
- ② 42 FT casing
- ③ 8 bags so far Hottel lease

7/1/88  
B. J. Hodges

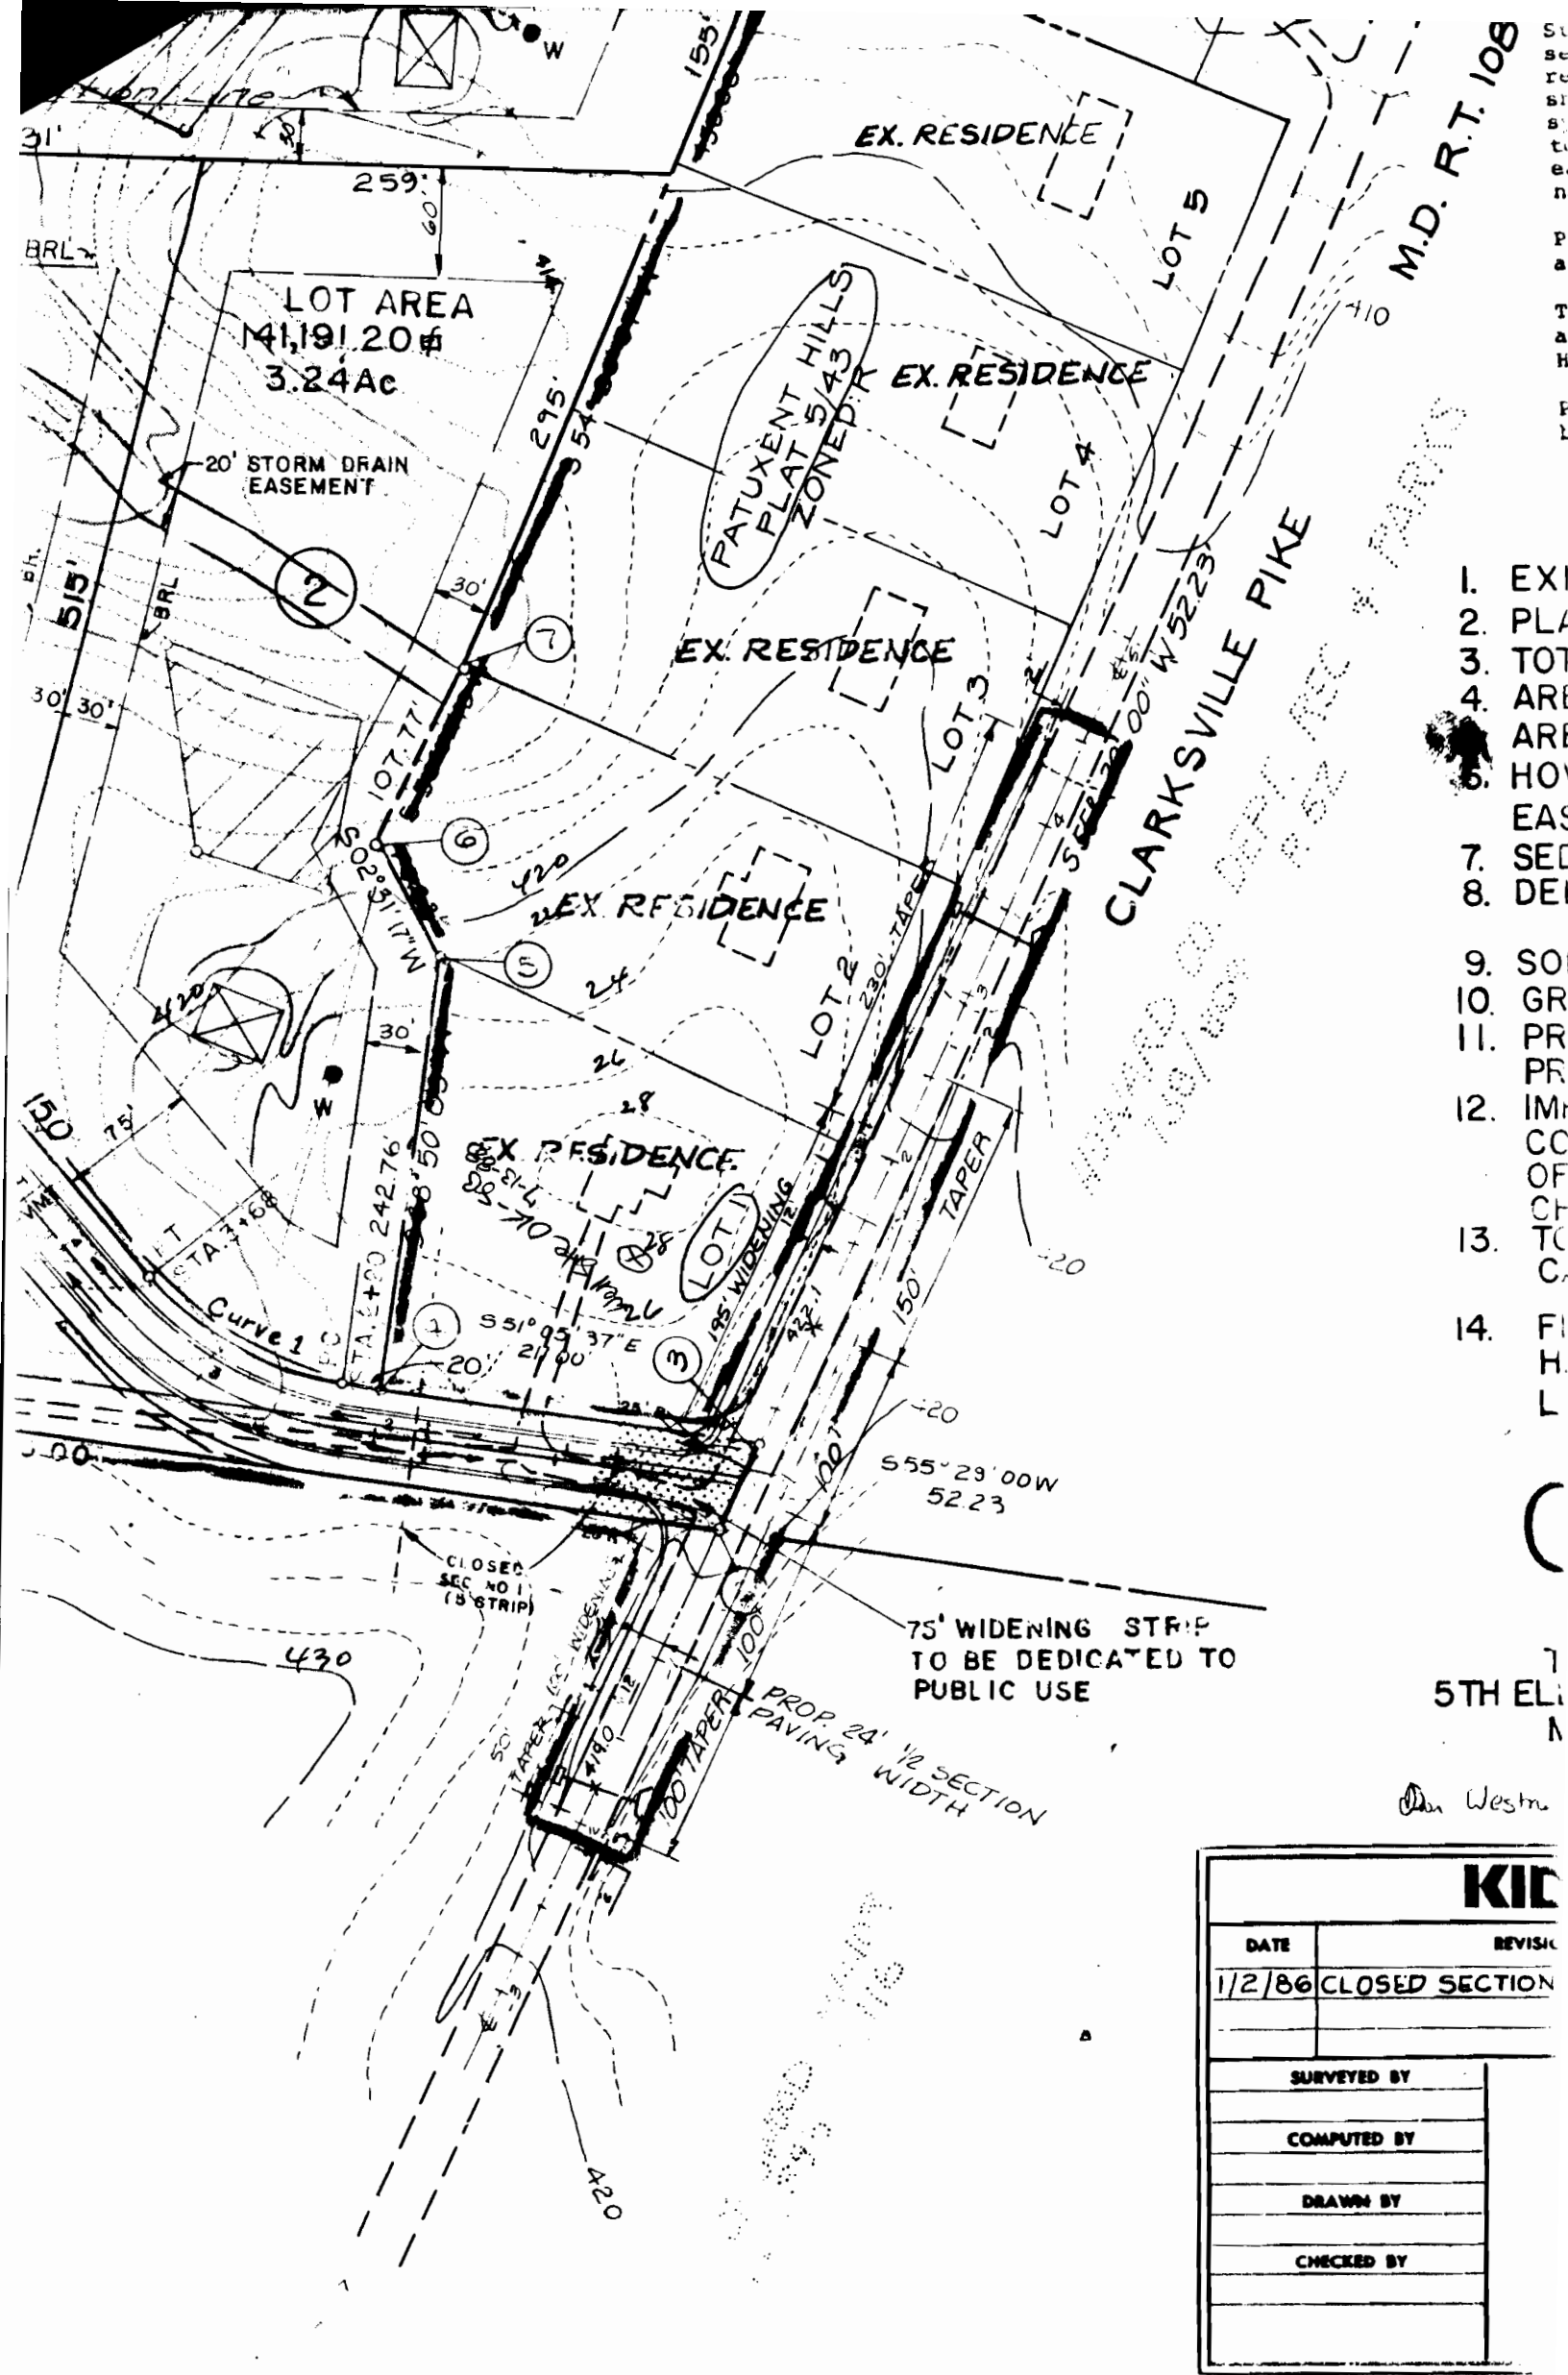

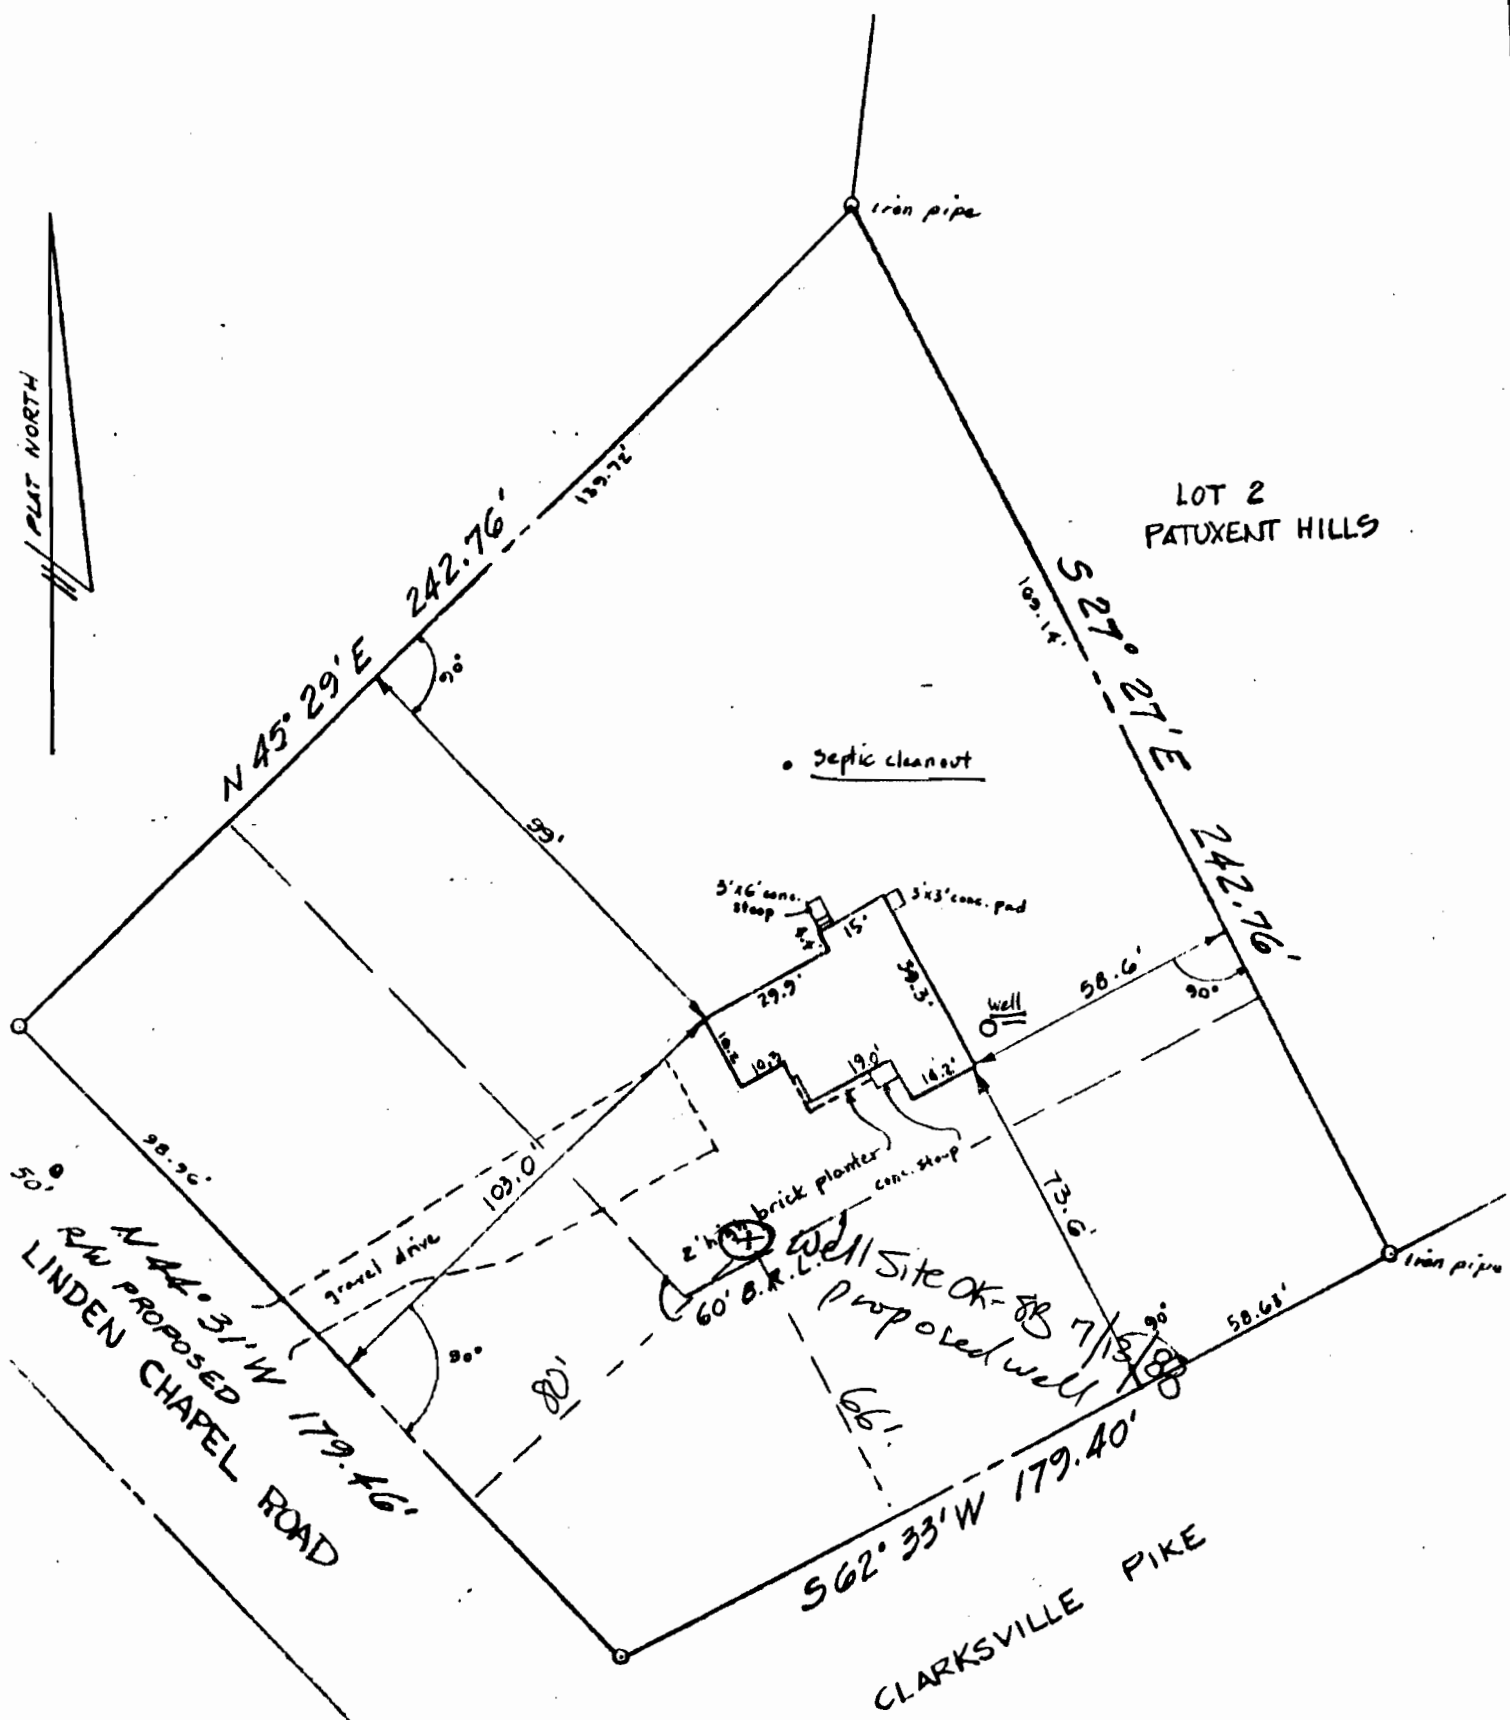


*Union Bridge, Md  
 35755  
 Columbia, Md  
 11752  
 Union Bridge, Md*

**LOCATION SURVEY OF**  
**LOT 1. PATUXENT HILLS**  
 PLAT BOOK 5 FOLIO 43  
 5<sup>TH</sup> ELECTION DISTRICT OF HOWARD CO., MD.  
 SCALE: 1" = 40'  
 DATE: DEC. 8, 1986

This is to certify that I have located the improvements shown hereon

*Henry Richard Moale*  
 Reg. no. 77  
 Henry Richard Moale  
 11933 Beaver Dam Road  
 Union Bridge, Maryland 21791



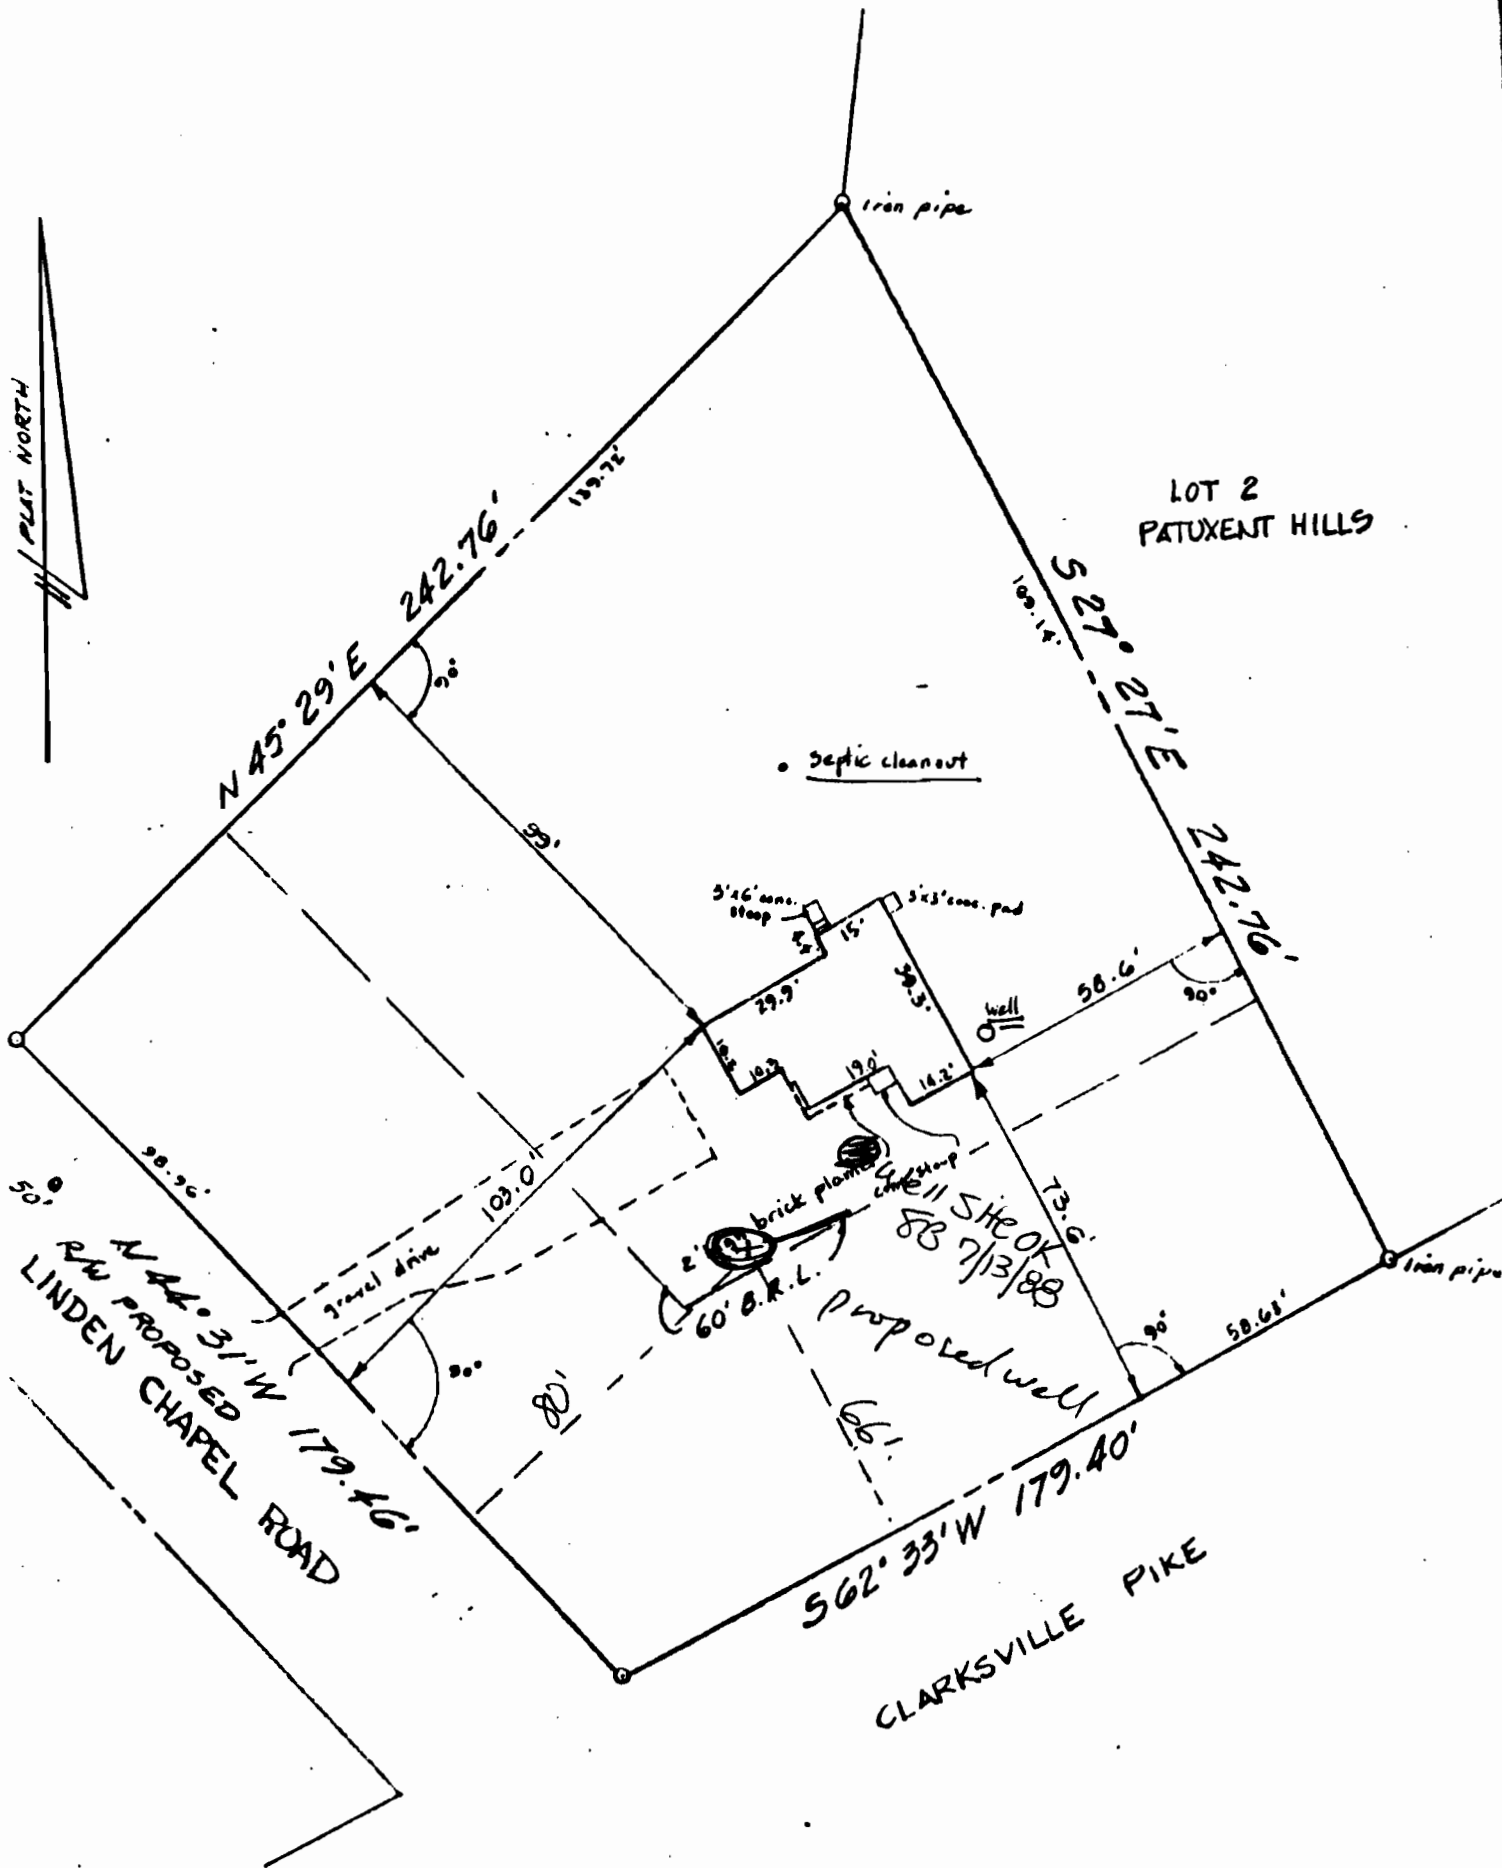

**LOCATION SURVEY OF**  
**LOT 1 - PATUXENT HILLS**  
 PLAT BOOK 5 FOLIO 43

5<sup>TH</sup> ELECTION DISTRICT OF HOWARD CO., MD.  
 SCALE: 1" = 40'      DATE: DEC. 8, 1986

This is to certify that I have located the improvements shown hereon

*Henry Richard Moale*  
 Henry Richard Moale  
 11933 Beaver Dam Road

