

COMPLETE THIS FORM WHEN DROPPING OFF ANY CORRESPONDENCE AND/OR PLANS TO THE HOWARD COUNTY DEPARTMENT OF INSPECTIONS, LICENSES AND PERMITS COUNTER:

Date: 12/15/14
To: James Haran
(Person's Name and Division)
From: James Haran (410) 804 3364
(Your Name, Company Name and Telephone Number)
Subject: Project name 3100 Longfield Rd
Project site address -Same-
Permit # B14003500 SDP # _____
Other information pertinent to this project _____

RECEIVED

- Please check the attachments below that you are submitting with this transmittal:
 - Letter of response to address plan review comment letter
 - Revised plans and/or revised details: When submitting for a complete re-review, **duplicate sets shall be submitted.**
 - Letter Summarizing Changes **Remove windows/Add wood deck in lieu of concrete deck (same size)**
 - Energy conservation calculations
 - Copies of _____ (be specific).
 - Health Department Request DPZ/ DED Request Applicant's Request
 - Two sets of single family dwelling model plans to be placed on permanent file: Model name and/or # _____
 - Other _____

Contact Person Information: (Required)

James Haran
Please Print Name
Telephone No: 410 804 3364
E-Mail Address: James@Level 1 Contracting.com

PLEASE ASSURE ALL DOCUMENTS AND/OR REVISIONS ARE APPROPRIATELY SIGNED AND SEALED, IF NECESSARY, BY A LICENSED ARCHITECT OR ENGINEER. PLEASE BE ADVISED THAT INSUFFICIENT INFORMATION MAY RESULT IN THE DELAY OF REVIEW BY THE PLANS EXAMINER. THE DEPARTMENT OF INSPECTIONS, LICENSES AND PERMITS WILL CONTACT YOU IF THERE IS A PROBLEM. IN ADDITION, ONCE THE BUILDING PERMIT IS APPROVED BY THE PLAN REVIEW DIVISION AND ALL OTHER REQUIRED SIGNATORY AGENCIES, AND THE BUILDING PERMIT IS READY FOR ISSUANCE, THE PERMIT DIVISION WILL NOTIFY THE APPROPRIATE CONTACT PERSON FOR PERMIT PICK UP. ALL PERMIT STATUS INQUIRIES SHALL BE DIRECTED TO THE PERMIT DIVISION AT 410-313-2455. CODE RELATED QUESTIONS AND PLAN REVIEW INQUIRIES SHALL BE DIRECTED TO THE PLAN REVIEW DIVISION AT 410-313-2436. PLEASE ALLOW A MINIMUM OF FIVE (5) WORKING DAYS FOR ANY PLAN SUBMITTALS TO BE REVIEWED. THANK YOU.

Received by cha

cc: DED
HEALTH

MARYLAND GRID NORTH

EX. PRIVATE POND
(MAX W.S. 524.0)
N 590

EX. PRIVATE SWM
ACCESS, DRAINAGE
AND UTILITY EASEMENT
LIBER 3543, FOLIO 192

LOT 2
"TRUSTED INFORMATION"
PLAT #11735
ZONED RC-DEO

N 590000
E1303800

PROP. WELL

EX. WHITE PINES
TO REMAIN

S 76°13'33" E

378.49'

339.67'

550

548

544

129.44'

540

540

60' BRL

26.9 #3

PROPOSED
WOOD
CONSTRUCTION
(PREVIOUS
CONCRETE)

36.0 ±
RG-2

PROP. HSE.
FF 547.75
LL 537.9

GAR.
FF 545.5

2.17' 2.50'

2.60' 9.85'

BAT UNIT

RG-1

LOT 1
2.7465 ACRES ±

EX. SWM POND
SPILLWAY

N 13°47'40" E

142.0 ±

544

540

540

540

EX. WHITE PINES
TO REMAIN

INV. 532.87

75' BRL

MaD
GgC

GgC
GnC

EX. GATE HOUSE &
AND ENTR. WALL
HOA LIBER 6022, FOLIO 303

REVISED
Date: 12-15-14

Comments: Change det'd
to 14003500

S 22°18'07" W

VEHICULAR INGRESS AND EGRESS
IS RESTRICTED WITHIN THESE LIMITS

318.58'

MPA
GA.

22 ±

EX. 60' RW

N 76°12'23" W

302.66'


S 63°02'54" W
37.88'

18 LF RIP RAP OUTLET
W=2' W/3: 1 SIDE SLOPES
CL II RIPRAP D=1.0'
DEPTH STONE=1.25'

LONGFIELD ROAD
LOCAL PUBLIC RD. (60' RW)

N 589550
E1303800

20 LF SOD OUTLET DITCH
W=2' W/3: 1 SIDE SLOPES
D=1.0'

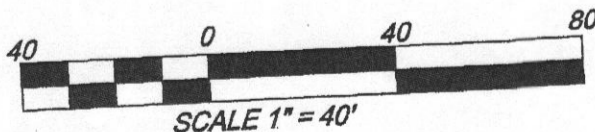

339.67'

RG-2

30'

4" D.

45°
17.0'

MARYLAND