
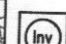
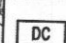
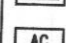
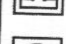
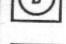
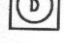
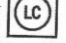



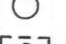
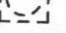



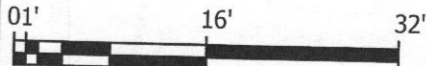

MP1 PITCH: 20 ARRAY PITCH: 20
 AZIMUTH: 192 ARRAY AZIMUTH: 192
 MATERIAL: Comp Shingle STORY: 2 Stories


5213 Kalmia Drive
 Site plan approved
 for B14004201 (solar
 panel system)
 -H.O.
 12/4/14

LEGEND

-  (E) UTILITY METER & WARNING LABEL
-  INVERTER W/ INTEGRATED DC DISCO & WARNING LABELS
-  DC DISCONNECT & WARNING LABELS
-  AC DISCONNECT & WARNING LABELS
-  DC JUNCTION/COMBINER BOX & LABELS
-  DISTRIBUTION PANEL & LABELS
-  LOAD CENTER & WARNING LABELS
-  DEDICATED PV SYSTEM METER
-  STANDOFF LOCATIONS
-  CONDUIT RUN ON EXTERIOR
-  CONDUIT RUN ON INTERIOR
-  GATE/FENCE
-  HEAT PRODUCING VENTS ARE RED
-  INTERIOR EQUIPMENT IS DASHED

SITE PLAN

Scale: 1/16" = 1'

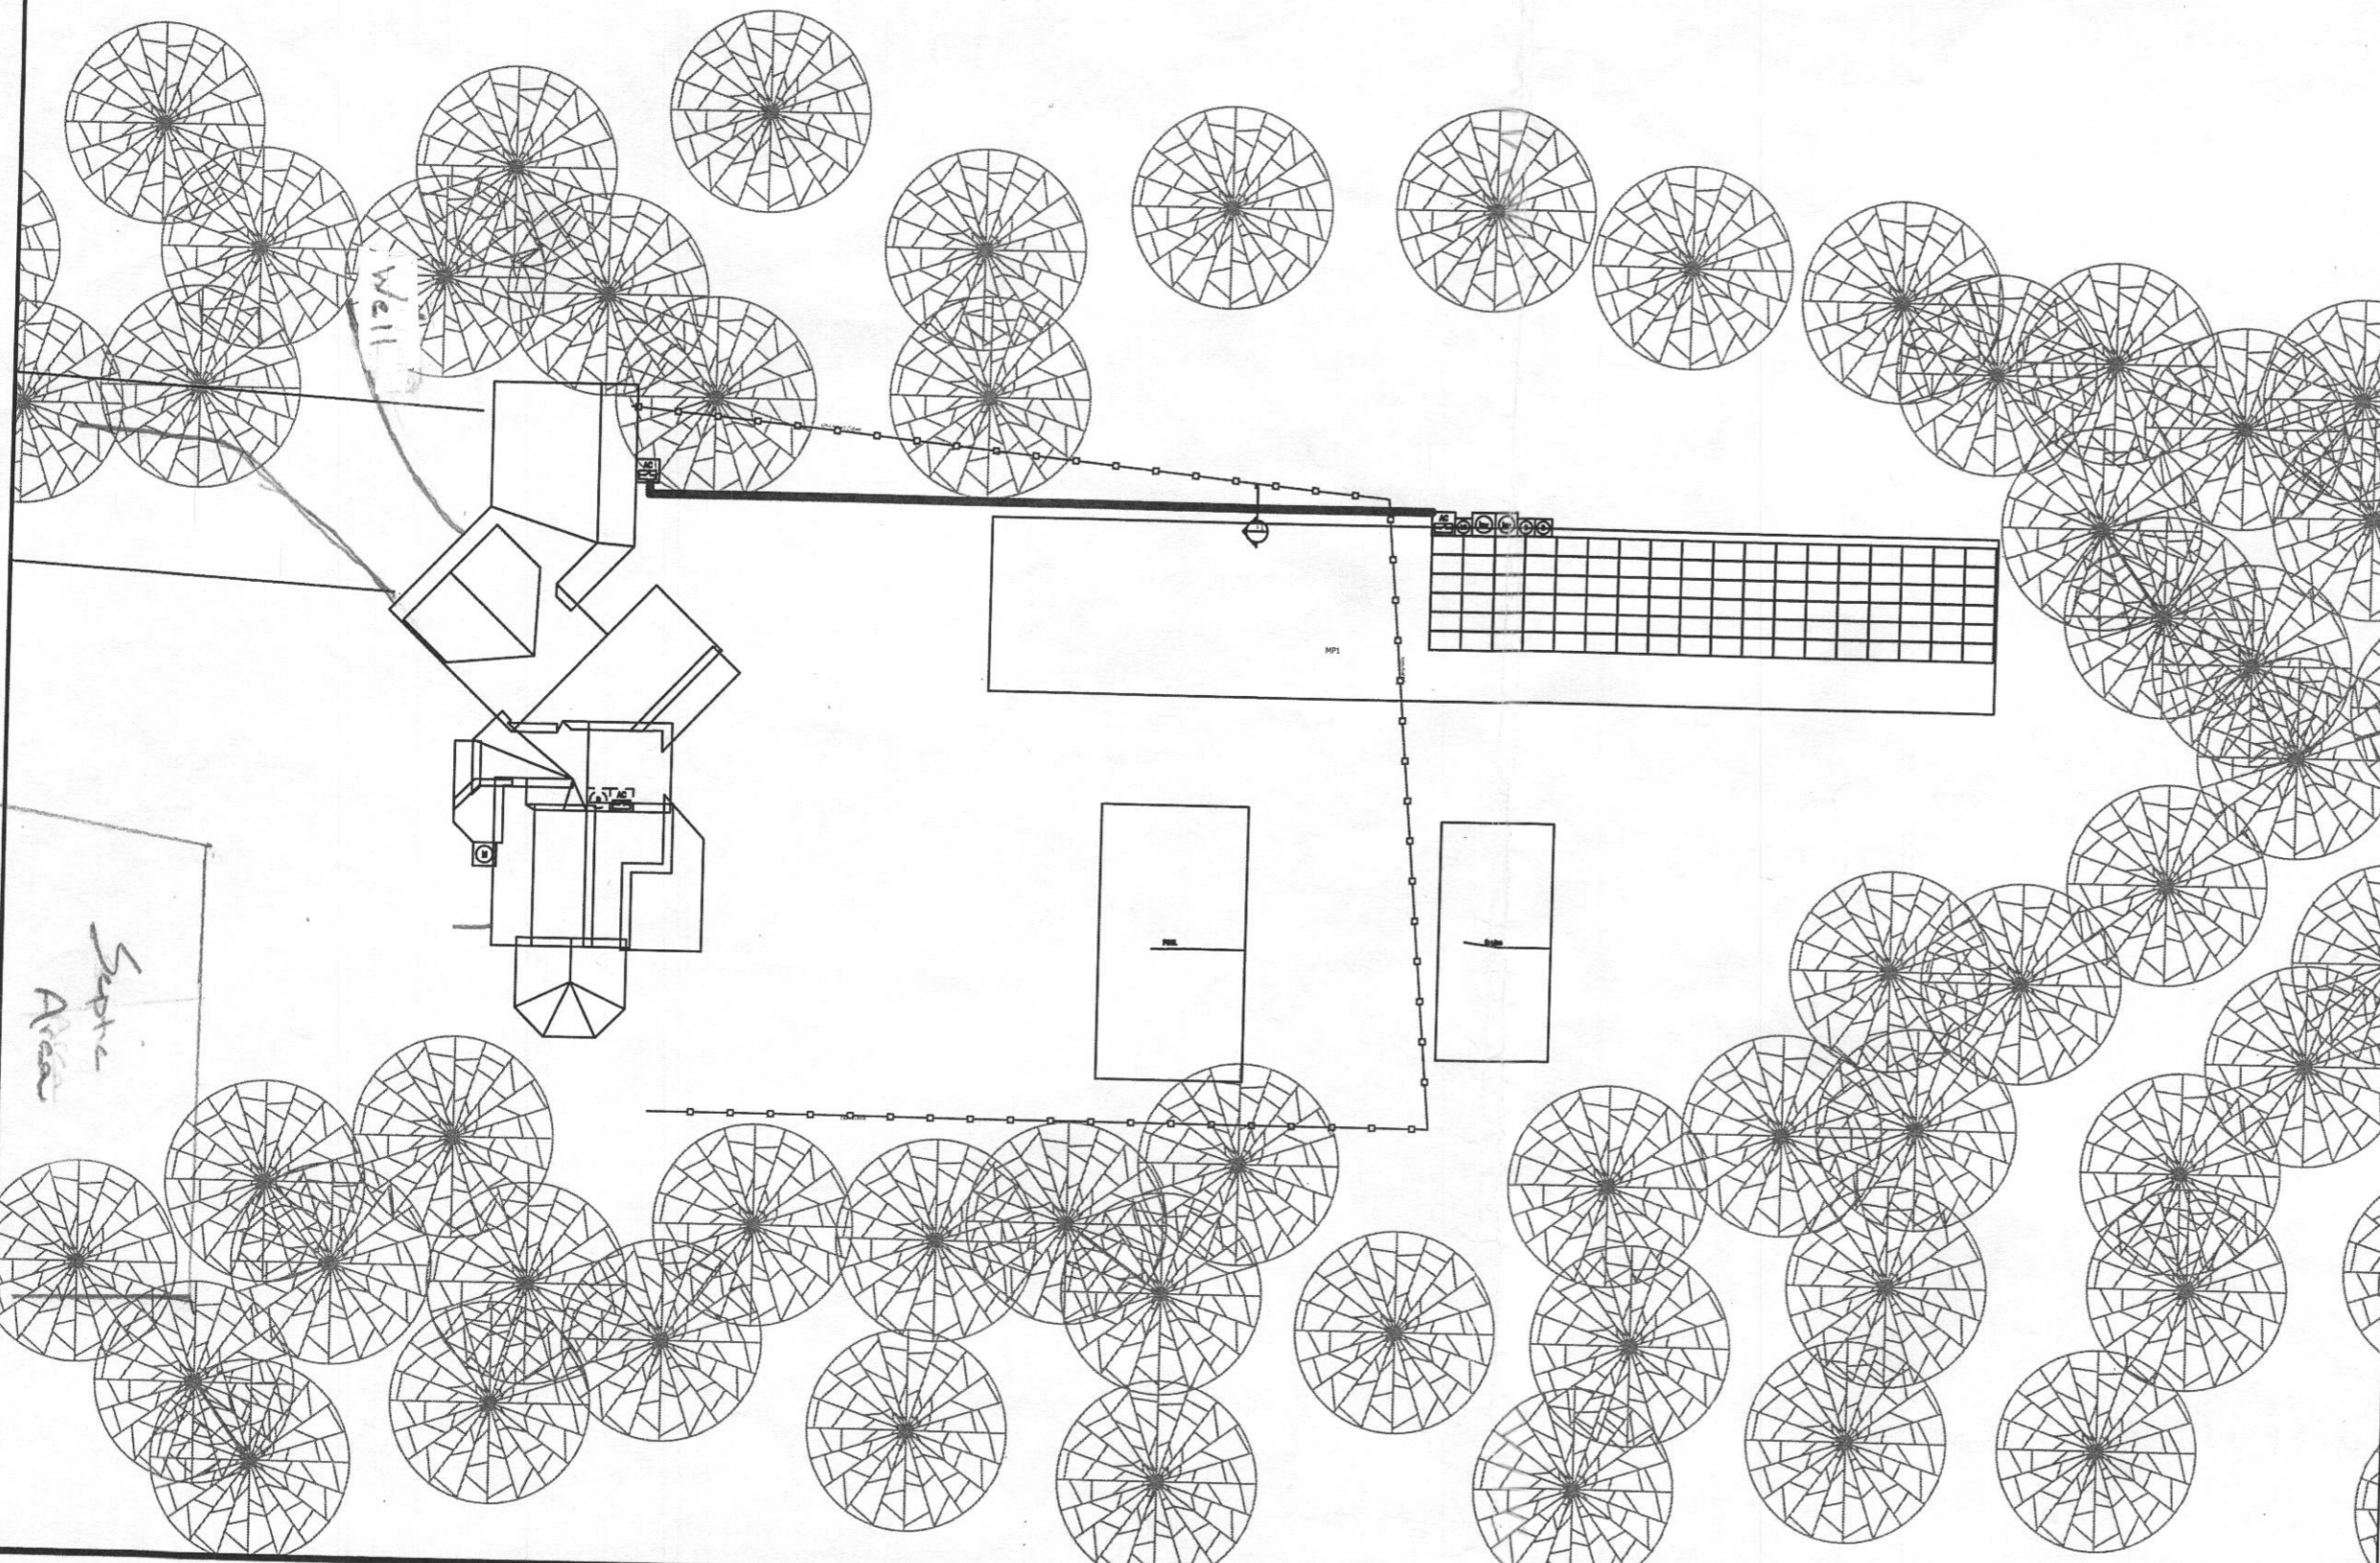



CONFIDENTIAL - THE INFORMATION HEREIN CONTAINED SHALL NOT BE USED FOR THE BENEFIT OF ANYONE EXCEPT SOLARCITY INC., NOR SHALL IT BE DISCLOSED IN WHOLE OR IN PART TO OTHERS OUTSIDE THE RECIPIENT'S ORGANIZATION, EXCEPT IN CONNECTION WITH THE SALE AND USE OF THE RESPECTIVE SOLARCITY EQUIPMENT, WITHOUT THE WRITTEN PERMISSION OF SOLARCITY INC.

JOB NUMBER: JB-210695 00
 MOUNTING SYSTEM:
 Comp Mount Type C
 MODULES:
 (108) YINGLI # YL250P-29b
 INVERTER:
 FRONIUS # IG PLUS A 11.4

PREMISE OWNER:
 AZOULAY, SAM
 5213 KALMIA DR
 DAYTON, MD 21036
 (301) 455-9099

DESCRIPTION:
 AZOULAY RESIDENCE
 27 KW PV ARRAY
 PAGE NAME:
 SITE PLAN

DESIGN:
 Mark Zacchilli
 SHEET: PV 2
 REV: 6/12/2014
 DATE:



3055 Clearview Way
 San Mateo, CA 94402
 T: (650) 638-1028 F: (650) 638-1029
 (888)-SOL-CITY (765-2489) www.solarcity.com