

Name: Farajah Ukondwa  
Street Address: 4783 Leyden Way  
City, State, Zip: Ellicott City MD 21042  
Date: 4/21/15

**RECEIVED**  
APR 21 2015  
LICENSES & PERMITS  
DIVISION

Amendment, Permit # B14003321

Ms. Debbie Whalen  
Division of Plan Review  
Department of Inspections, Licenses and Permits  
Howard County Government  
3430 Court House Dr  
Ellicott City, MD 21043

Dear Ms. Whalen:

I am requesting to amend Permit # B14003321 at  
14341 Fox Creek Ct Cooksville MD 21723 to

1. Change usage of the space under the front porch  
from "Fill" to storage space.
2. Add open deck at the rear of the house  
approximately 45' wide by 14' deep with steps.  
(2 sets of steps)

Enclosed:

INV# 398223

Fee: 50.00

EK# 139

Plot Plans

Sets of Construction Drawings

Other: \_\_\_\_\_


If there is anything we can do to assist you, please let me know.

Sincerely,

Name: Farajah Ukondwa  
Title: Owner  
Phone: 410 660 9960  
Email: Tanzg8@yahoo.com

*Approved  
JW  
5/1/15*  
**HCTH!**

Amendment Letter

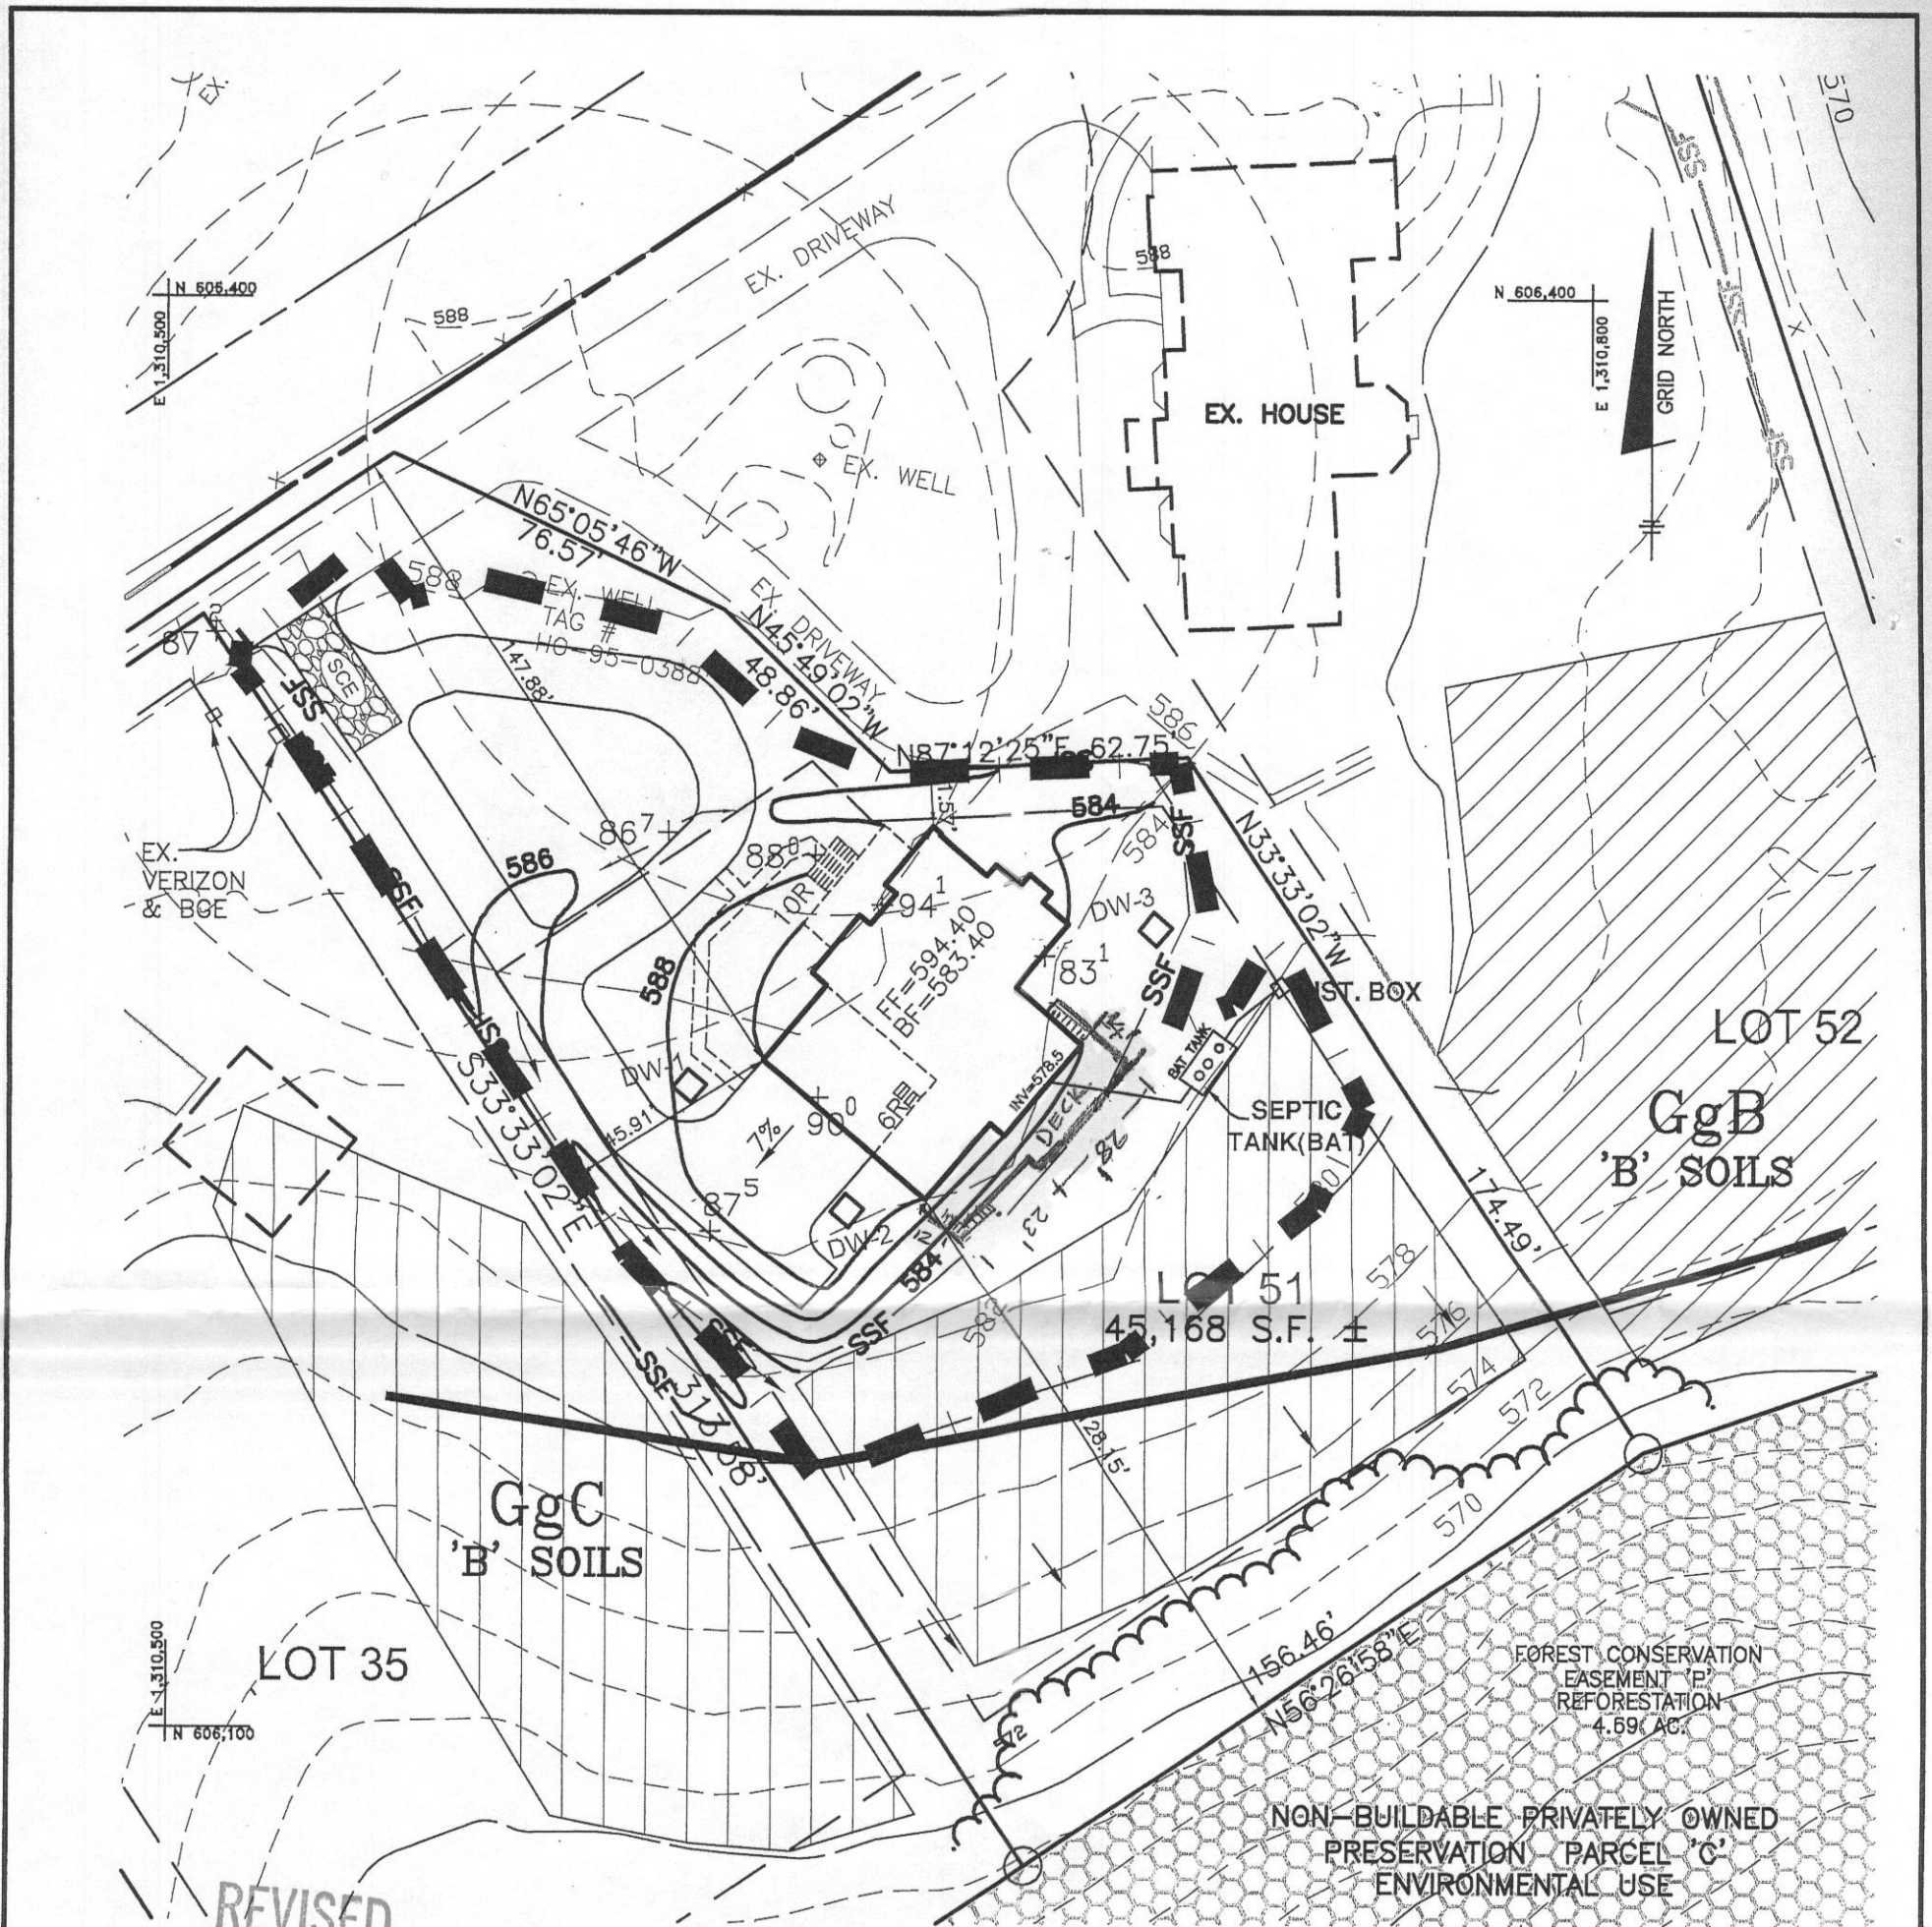

REVISED

Date: 4-21-15

Comments: add deck +  
change space under porch  
to storage space

# B14003321

PLAN  
SCALE: 1"=50'

<p><b>BENCHMARK</b> ENGINEERS • LAND SURVEYORS • PLANNERS <b>ENGINEERING, INC.</b> 6480 BALTIMORE NATIONAL PIKE &amp; SUITE 315 • ELLICOTT CITY, MARYLAND 21043 (P) 410-485-6105 (F) 410-485-0644 WWW.BEI-CIVLENGINEERING.COM</p>	<p><b>OWNER</b> FARAJAH UKONDWA 4783 LEYDEN WAY ELLICOTT CITY, MD 21042</p>	<p>PROJECT: <b>MONTICELLO LOT 51</b></p> <p>TITLE: <b>SEDIMENT CONTROL PLAN</b></p> <p>DATE: AUGUST 2014 PROJECT NO. 2616</p> <p>DRAFT: JCO CHECK: CAM</p>
---	---	--