

THIS REPORT  
MUST BE SUBMITTED  
WITHIN 30 DAYS  
AFTER COMPLETION  
OF THE WELL

WELL COMPLETION REPORT

WELL DESCRIPTION

WELL LOG

State the kind of formations penetrated, their color, their depth, their thickness, and if water-bearing

CASING AND SCREEN RECORD

State the kind and size and position of casing, liner, shoe, screen, and other accessories (if no casing used, give diameter of well).

	FEET from ___ to ___		DIAM. (inches)	FEET from ___ to ___
Topsoil	0-3	Steel	6 1/4	0-19
Shale	3-15			
Brown slate	15-40			
Blue slate	40-260			
water	60			

Permit Number Ho. 67.W. 71  
 Owner Delta Park  
 Address 417 Army road.  
 Subdivision \_\_\_\_\_  
 Section \_\_\_\_\_ Lot \_\_\_\_\_

PUMPING TEST

Hours Pumped 1 1/2  
 Type of Pump Used air  
 Pumping Rate 1/2  
 Gallons per Minute \_\_\_\_\_

WATER LEVEL

Distance from land surface to water:  
 Before Pumping 40 Ft.  
 When Pumping 260 Ft.

APPEARANCE OF WATER

Clear \_\_\_\_\_ Cloudy \_\_\_\_\_  
 Taste \_\_\_\_\_  
 Odor \_\_\_\_\_

Height of Casing Above Land


Surface 2 Ft.

PUMP INSTALLED

Type \_\_\_\_\_  
 Capacity \_\_\_\_\_  
 Gallons per Minute \_\_\_\_\_  
 Gallons per Hour \_\_\_\_\_  
 Pump Column Length \_\_\_\_\_ Ft.

LOCATION OF WELL ON LOT

Show permanent structures such as building(s), septic tank, and/or other landmarks and indicate not less than 2 distances (measurements) to well.

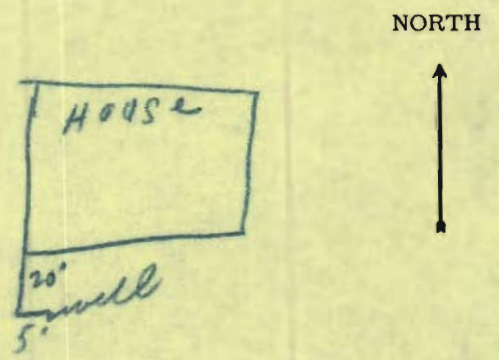

Date Well Apr 17, 66  
 Was Completed \_\_\_\_\_

Well Driller \_\_\_\_\_  
 Signature J. Hester

Rd.

APPLICATION MUST BE SUBMITTED AND PERMIT RECEIVED BEFORE DRILLING IS STARTED.

*Herman Gillis*

APPLICATION FOR PERMIT TO DRILL WELL

70-711

Owner Mrs Delta Perry

Street or R. F. D. Mt Airy

Post Office Md

Quantity of Water to be Produced 4 Gallons Per Minute

Total Quantity Needed For Use 300 Gallons Per Day

Use for Water House

Approximate Depth of Well (feet) 90

Method of Drilling to be used Rotary

Is this a Replacement Well? Yes - No

If YES, indicate date abandoned well is to be sealed: \_\_\_\_\_

and by whom: \_\_\_\_\_

Driller L. F. Easterday License Number 70

Street or R. F. D. Mt. Airy Md.

Post Office \_\_\_\_\_

Date Aug 18, 1966

Location of Well \_\_\_\_\_ County \_\_\_\_\_

Subdivision \_\_\_\_\_

Section \_\_\_\_\_ Lot \_\_\_\_\_

County Howard

Nearest Town Long Corner

Distance from Town \_\_\_\_\_

Direction from Town East

Description of Location of Well  
(This information MUST BE ACCURATE, and should be definite enough to permit locating well on a county map.)

Near what road Pen Shops Rd

On which side of road ✓  
(North, East, South, West)

Distance from road 105 ft.

PERMIT TO DRILL WELL  
(Not To Be Filled In By Driller)

Well Permit No. HO-67-W-71

Samples of Cuttings Required by Department:  Yes  No

Owner Requires Permit to Appropriate Water:  Yes  No

Owner Has Permit to Appropriate Water:  Yes  No

Appropriation Permit No. \_\_\_\_\_  
The applicant is herewith granted a permit to drill this well subject to the conditions stipulated.

Paul W. McKee Director Aug. 8-22-66 Date

**THIS PERMIT IS NOT TRANSFERABLE**  
WITHOUT WRITTEN PERMISSION FROM THE DEPARTMENT  
Special conditions that must be observed:

ETICOTT CITY, MD.  
HEALTH DEPT.  
HOWARD COUNTY

Health Department Approval of Application

Howard County Department of Health

or  State Department of Health

Approved by [Signature]

Title Director, Environmental Health

Date 8/19/66

Draw a sketch below showing location of well in relation to nearby towns, roads and streams with north in the direction of the arrow, and give distance from well to nearest road junction or stream crossing shown on the sketch. Distances may be approximate, but must be indicated.

NORTH

