

# APPLICATION

A 19966

## SEWAGE DISPOSAL TESTING

P \_\_\_\_\_

STATE OF MARYLAND - DEPARTMENT OF HEALTH AND MENTAL HYGIENE

HOWARD COUNTY HEALTH DEPARTMENT  
ENVIRONMENTAL HEALTH SERVICES  
P. O. BOX 476, ELLICOTT CITY, MARYLAND 21043  
TELEPHONE: 465-5000, EXT. 356

DISTRICT 4

DATE 5/15/74

TO: THE COUNTY HEALTH OFFICER  
ELLICOTT CITY, MARYLAND

I, HEREBY, APPLY FOR THE NECESSARY TEST IN ORDER TO CONSTRUCT (OR RECONSTRUCT) A SEWAGE DISPOSAL SYSTEM.

PROPERTY OWNER BAIN

ADDRESS (Dr. C. R. Naples property) PHONE Any questions call:  
Kenneth W. Lyon  
589-1240

PROPERTY LOCATION:

SUBDIVISION \_\_\_\_\_ LOT NO. 21

ROAD AND DESCRIPTION R/W off Windsor Forest Road

SIZE OF LOT 8.3472 acres TYPE BLDG. 3 or 4

NUMBER OF BEDROOMS  
(Single Fmly. Bldg.)

IF NOT SINGLE RESIDENCE DESCRIBE \_\_\_\_\_

THE SYSTEM INSTALLED UNDER THIS APPLICATION IS ACCEPTABLE ONLY UNTIL PUBLIC FACILITIES BECOME AVAILABLE.

SIGNATURE OF APPLICANT /s/ Howard W. Bain

APPROVED BY Frank Chinn FOR DRYWELL DATE 8/12/74  
(KIND OF SYSTEM)


REJECTED BY \_\_\_\_\_ FOR \_\_\_\_\_ DATE \_\_\_\_\_  
(KIND OF SYSTEM)

HOLD PENDING FURTHER TESTS \_\_\_\_\_ DATE \_\_\_\_\_

REASONS FOR REJECTION OR HOLDING \_\_\_\_\_

# THIS IS NOT A PERMIT

A 19966

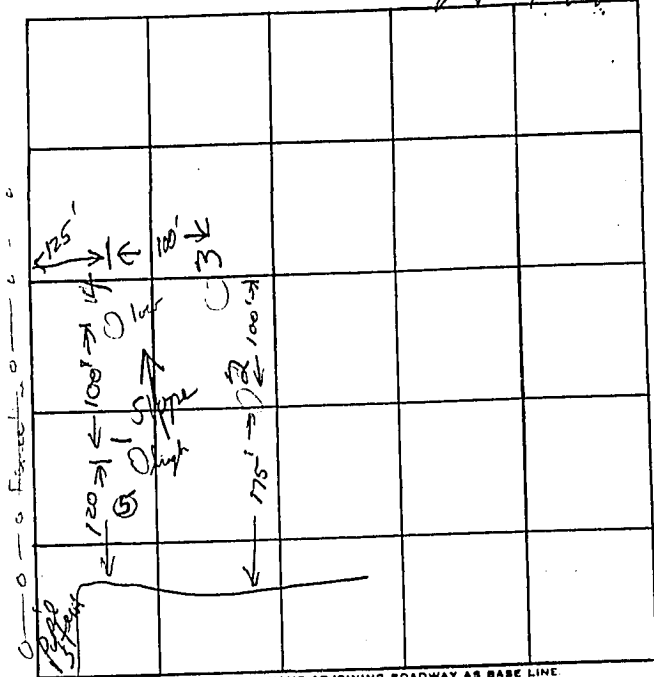

INDICATE NORTH. - NAME ADJOINING ROADWAY AS BASE LINE  
Long Corner Road

DATE	TEST NO.	DEPTH	PRE-WET		TEST - 1" DROP		TIME	
			START	STOP	START	STOP		
4/17/74	1 high	11'	1:24	1:25	1:25	1:40	15 min	
	1a	5'	1:25	1:40	1:40	Failed	230	
	2	10'	run out top 4 1/2' clayey shale below					56 2
	3	10'	run out top 1' clay shale below					133
	4 low	5'	1:36	1:44	1:44	1:56	12 min	
	4a	11 1/2'	1:36	1:38	1:38	1:40	2 min	
	1b	3 1/2'	2:02	2:03	2:03	2:06	3 min	
	5	8 1/2'	hit rock at 8 1/2'					

15  
30  
12  
23  
56 2  
133  
13 min  
avg

REMARKS 15 min + 1 test 20 min + 1 test soil spottily in hole #1

TYPE OF SOIL \_\_\_\_\_

TESTED BY P.S.A.C.B.C. ALSO PRESENT: \_\_\_\_\_