

5/6/75

File final
C.B.K.

PERMIT

SEWAGE DISPOSAL SYSTEM

P. 21082

A. 19966

MARYLAND STATE DEPARTMENT OF HEALTH

HOWARD COUNTY

ELLICOTT CITY

INDEXED

DISTRICT 4th

DATE 1/17/75

Swiger Brothers
Richard Tyler

IS PERMITTED TO INSTALL ALTER

ADDRESS Rt. 3, Box 209, Mt. Airy, Md. PHONE 253-6463

253 6144

A SEWAGE DISPOSAL SYSTEM LOCATED AT _____

SUBDIVISION _____ ROAD ¹⁷⁷⁵ Long Corner Road LOT 21

PROPERTY OWNER Mr. Richard Tyler *John Ferguson (DAVID GOODMAN)*

ADDRESS Route 3, Box 209, Mt. Airy, Maryland

SPECIFICATIONS 3 bedrooms

DRAIN FIELD _____ DEPTH _____ FEET. BOTTOM AREA _____ SQ. FT.

SEEPAGE PITS _____ ABSORBENT SIDE-WALL AREA _____ SQ. FT.

SEPTIC TANK CAPACITY 1000 GALLONS

FOR GARBAGE GRINDER, INCREASE DISPOSAL AREA 22% & TANK CAPACITY 50%.

OTHER DRY WELL - To have 156 sq. ft. effective sidewall absorption area per bedroom to begin below the first 3 1/2 ft. of non-absorbent soil. Maximum depth permitted for dry well is 11 ft. below original grade. Place the dry well 120 ft. from the front lot line and 188 ft. from the left lot line, as seen when facing the lot from Long Corner Road.

NOTE: ALL PIPE FROM HOUSE TO DISPOSAL AREA MUST BE CAST IRON.
PERMIT VOID AFTER THREE YEARS.

NOTE: INSTALL STAND PIPE ON SEPTIC TANK AND DRY WELL. STAND PIPES MUST BE 6 INCHES IN DIAMETER. CAST IRON, CONCRETE OR TERRA COITTA ACCEPTED.

PLANS APPROVED BY Frank Skinner DATE 8/12/74


FILL SEPTIC TANK AND DISTRIBUTION BOX WITH WATER BEFORE CALLING FOR AN INSPECTION. COVER NO WORK UNTIL INSPECTED AND APPROVED.

NEITHER THE HOWARD COUNTY COMMISSIONERS NOR THE HEALTH DEPARTMENT IS RESPONSIBLE FOR THE SUCCESSFUL OPERATION OF ANY SYSTEM.

BDDG. PERMIT SIGNED
AND RETURNED 4/11/86
Serial # 70958.

A 19966

19966

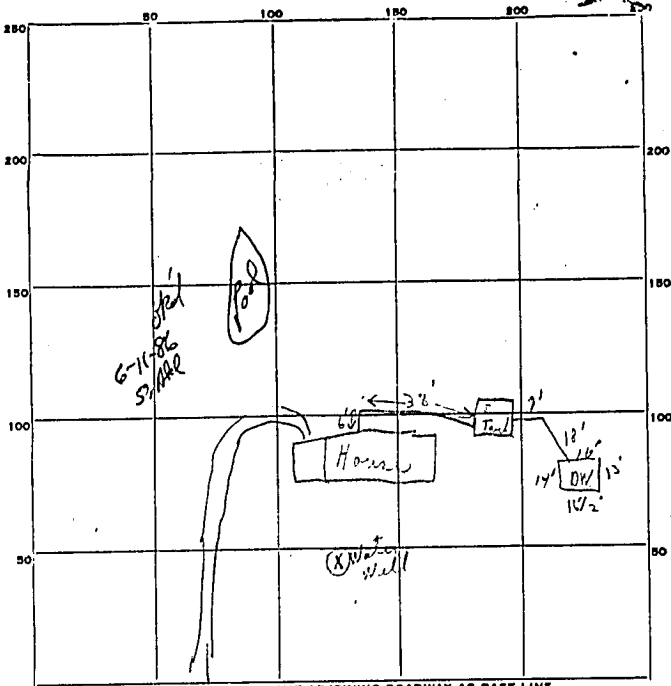

INDICATE NORTH - NAME ADJOINING ROADWAY AS BASE LINE.

PERMIT CARD Not seen Long Corner Road 15 1/3
 SEPTIC TANK, LEVEL OK S.T. / P.W. 468'
 CLEANOUTS OK / OK
 DISTRIBUTION BOX, LEVEL _____
 TILE FIELD, DEPTH _____ FT. TRENCH WIDTH _____ FT. 12 1/2
 GRAVEL DEPTH _____ IN. TOTAL LENGTH _____ FT. 4 1/2
 NUMBER OF TRENCHES _____ TOTAL BOTTOM AREA _____ 8
 SEEPAGE PITS, INSIDE DIAMETER outside pits 5 9/16 FT. ± DEPTH BELOW INLET 8 ± FT.
 ABSORBENT AREA 426 ± SQ. FT.

REMARKS 5/6/75 locate tank cleanouts + dig well cleanout
cut in on road and all pipes cut from house (No well?)
{ in general pits called for }

DATE SYSTEM APPROVED 5/6/75 permes INSPECTOR C. Starker