

APPLICATION

PERCOLATION TESTING

A 510157

P _____

HOWARD COUNTY HEALTH DEPARTMENT
BUREAU OF ENVIRONMENTAL HEALTH
3525-H ELLICOTT MILLS DRIVE/ELLICOTT CITY, MARYLAND 21043
TELEPHONE: 313-2640

DISTRICT _____

DATE 5/20/98

TO: THE COUNTY HEALTH OFFICER
ELLICOTT CITY, MARYLAND

I HEREBY APPLY FOR THE NECESSARY TEST PRIOR TO APPLICATION FOR PERMIT TO CONSTRUCT (OR RECONSTRUCT) A SEWAGE DISPOSAL SYSTEM.

PROPERTY OWNER BRS DEVELOPERS

ADDRESS 70 10805 Hickory Ridge Road PHONE 410-740-2100
COLUMBIA MD 21044

AGENT OR PROSPECTIVE BUYER DONALD R. REWICK @ LAND DESIGN & DEV. INC

ADDRESS 10805 Hickory Ridge Road PHONE 410 740 3244

PROPERTY LOCATION: COLUMBIA, MARYLAND 21044 NEW LOT 3 Lot 7

SUBDIVISION WILKETS PROPERTY LOT NO. RES. PARCEL "A"

ROAD AND DESCRIPTION LEFT SIDE LONG CORNER ROAD OPPOSITE
NEW CUT ROAD, SITE BACKS TO PATUXENT RIVER STATE PARK

TAX MAP 6 PARCEL # 55 GRID 21

SIZE OF LOT _____ TYPE BLDG. SINGLE FAMILY DWELLING
(SINGLE FAMILY DWELLING OR COMMERCIAL)

THE SYSTEM INSTALLED UNDER THIS APPLICATION IS ACCEPTABLE ONLY UNTIL PUBLIC FACILITIES BECOME AVAILABLE. I FULLY UNDERSTAND THE FEE CONNECTED WITH THE FILING OF THIS PERC TEST APPLICATION IS NON-REFUNDABLE UNDER ANY CIRCUMSTANCES. I ALSO AGREE TO COMPLY WITH ALL M.O.S.H.A. REQUIREMENTS IN TESTING THIS LOT. DONALD R. REWICK JR.
(SIGNATURE OF APPLICANT)

APPROVED BY _____ FOR _____ DATE _____

DISAPPROVED BY _____ FOR _____ DATE _____

HOLD PENDING FURTHER TESTS _____

REASONS FOR REJECTION OR HOLDING _____

PERCOLATION TEST PLAT/PRELIMINARY PLAT - TITLE OR I.D. # _____ DATE _____

SITE DEVELOPMENT PLAN/FINAL PLAT - TITLE OR I.D. # _____ DATE _____


THIS IS NOT A PERMIT

A 510157



LONG CORNER ROAD

COUNTY #



SOIL PROFILE

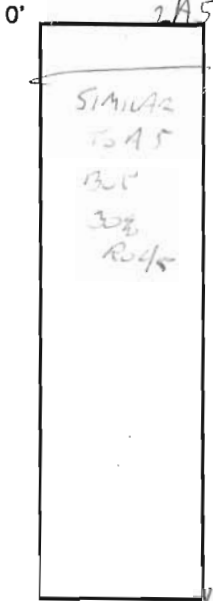

SOIL PROFILE

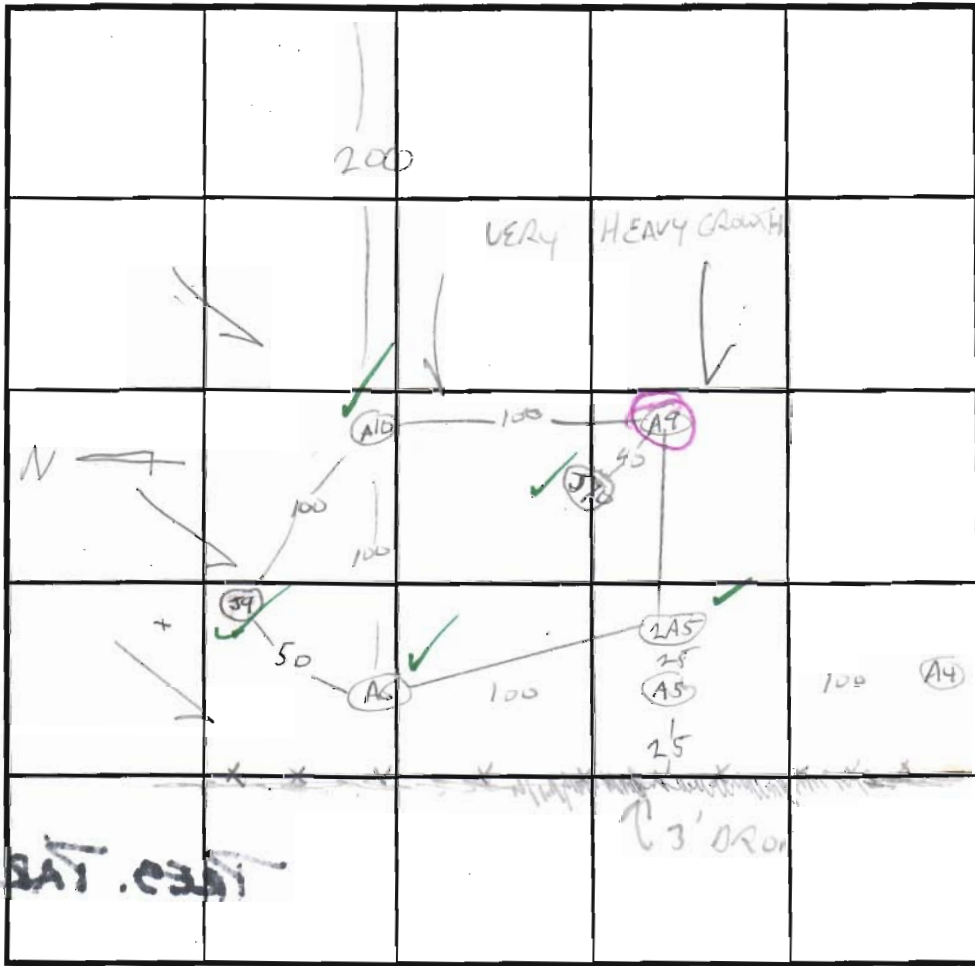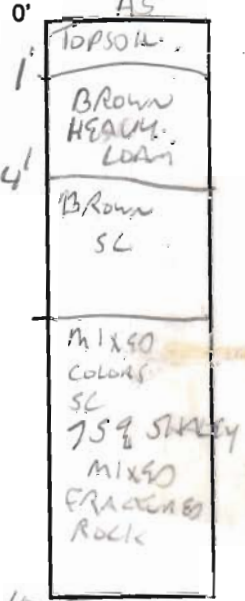

INDICATE NORTH - NAME ADJOINING ROADWAY AS BASE LINE.

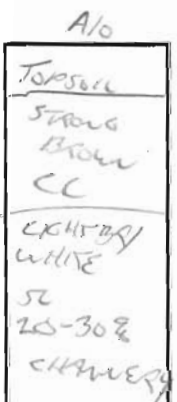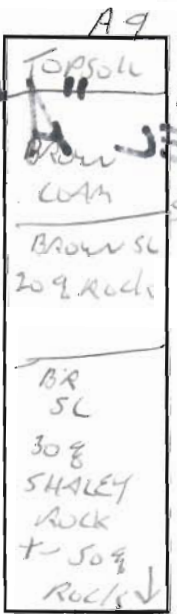

DATE	TEST NO.	DEPTH	PRE-WET		TEST - 1" DROP		TIME
			START	STOP	START	STOP	
6.17.98	A5	10.5	not	TESTED	ROCK		FAIL
	✓ 2A5	7.5	5:15.23	5:19	→	5:25	6 MW
	✓ A6	4.5 / 10	12:15	2:22	→	2:34	12 MW
	✓	OK AT 4.5'					
	✓ A10	4 / 8	3:29	3:34	→	3:45	11 MW
	✓ J10	UNPROFILED					
	FAIL-ROCK	A9	3.5 / 10	3:47	→	4:14	24 MW
	FAST	7	3:59.50	3:55.07	→	3:55.50	143.5 SEC
	✓ J9	4 / 11.5	2:42	2:43	→	2:45	2 MW

REMARKS: 1' SQUARE TEST HOLE, NEW LOT 3 - PRES PARCEL A

TYPE OF SOIL: SHEET 1 OF 2, TOP SEAM TANK

TESTED BY: G. SALVAGE ALSO PRESENT: MIKE JOHNSON, SAM

TRENCH DESIGN DATA: AVERAGE PERCOLATION TIME: 7 MW TRENCH WIDTH: 3


INLET DEPTH: 2 MAXIMUM BOTTOM DEPTH: 4 SQ. FT./BEDROOM: 180

HARD

Signed Original
Perc Cert
Plat 7-16-98
S.R.M.

PRESERVATION PARCEL C
NON-BUILDABLE
1,180,909 SQ. FT.
OR
27.11 ACRES

A510157

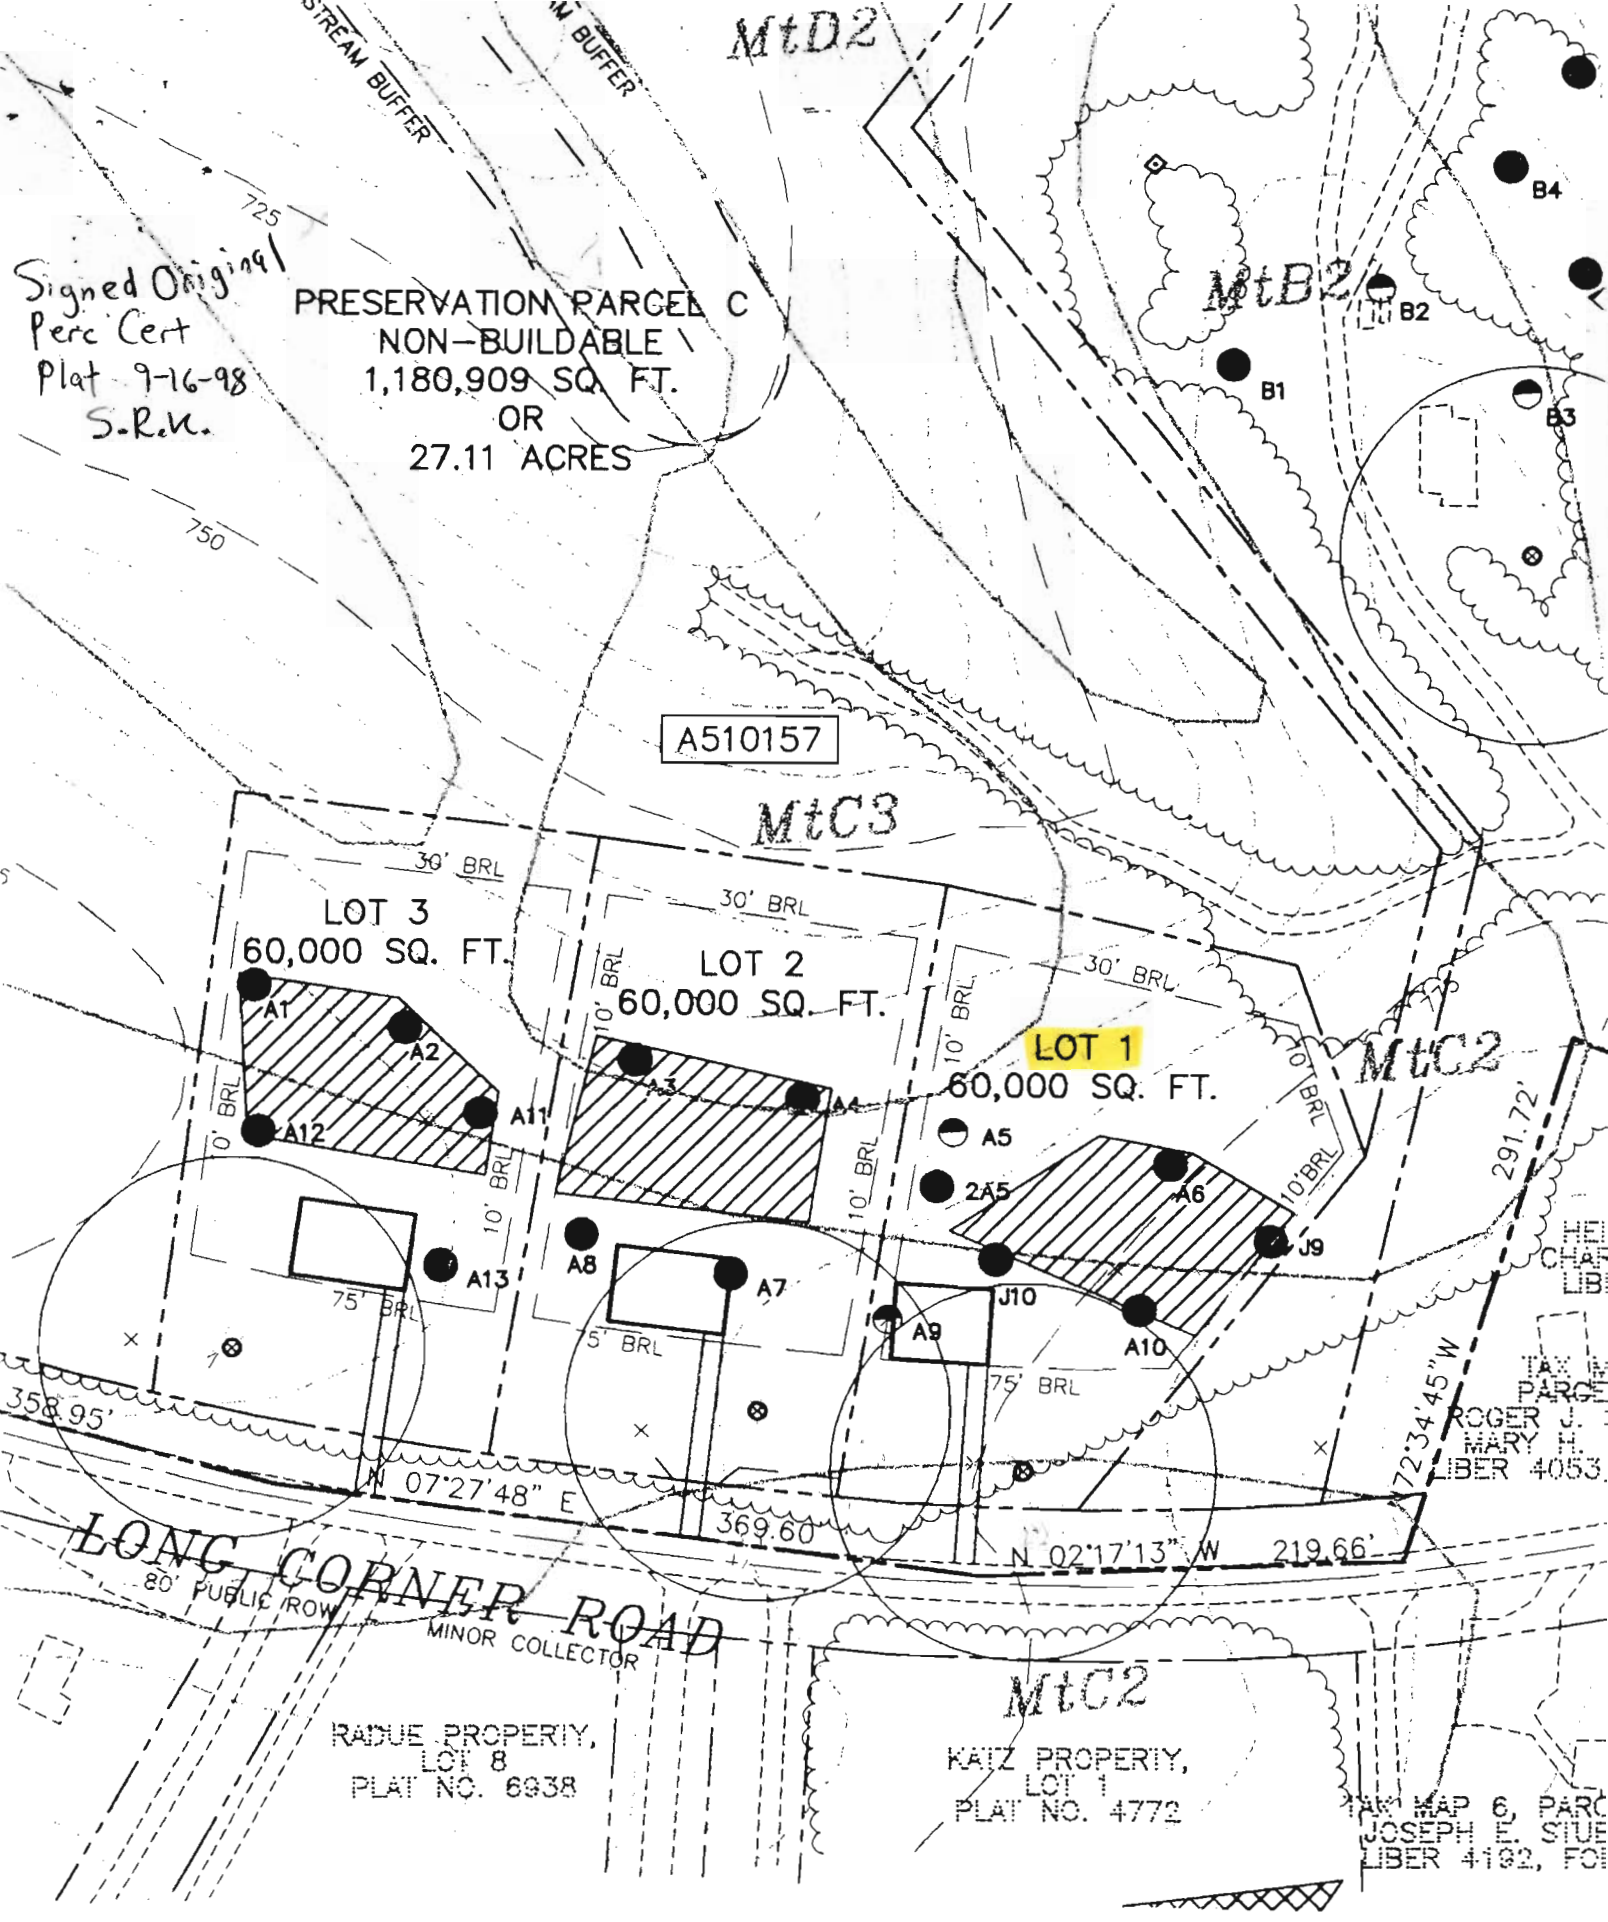

LONG CORNER ROAD
80' PUBLIC ROW
MINOR COLLECTOR

RAJUE PROPERTY,
LOT 8
PLAT NO. 6938

KATZ PROPERTY,
LOT 1
PLAT NO. 4772

MAP 6, PARC
JOSEPH E. SIEU
LIBER 4192, FOI

matter, please contact me at the address below or by calling (410) 313-2640. Thank you in advance for your time and cooperation

004

SCRIVENER INC

05/04/99 TUE 15:09 FAX 14109842820

NON-BUILDABLE
1,180,909 SQ. FT.
OR
27.11 ACRES

PRESERVATION PARCEL A
1,133,655 SQ. FT.
OR
26.03 ACRES

A510157

LOT 3
60,000 SQ. FT.

LOT 2
60,000 SQ. FT.

LOT 1
60,000 SQ. FT.

MTC2

MTC2

MTC2

LONG CORNER ROAD
80' PUBLIC ROW
MINOR COLLECTOR

NEW CUTT ROAD

RADUE PROPERTY,
LOT 8
PLAT NO. 6938

KATZ PROPERTY,
LOT 1
PLAT NO. 4772

TAX MAP 6, PARCEL 136
JOSEPH E. STUBBINS
LIBER 4192, FOLIO 72

TAX MAP 6, PARCEL 74
HEIDI FOREST MYERS
CHARLES RANDALL BARNES
LIBER 3198, FOLIO 663

TAX MAP 6, PARCEL 143
ROGER J. STEVENS &
MARY H. DUKEHART
LIBER 4053, FOLIO 414

JACK S. BROCKMAN SUB.
PLAT NO. 5682
LOT 3

WELL ASSUMED TO BE
LOCATED IN THIS AREA

CENTERLINE

S68°42'41"W
290.77'

N63°28'54"E
191.40'

N16°01'08"W
7.72'

No WSI Stake Found
Perc Sites Look O.K.
6/22/99 BB

WSI stake found.
Site looks O.K.
7/9/99 BB