

# APPLICATION

PERCOLATION TESTING

A 510151

P \_\_\_\_\_

HOWARD COUNTY HEALTH DEPARTMENT  
BUREAU OF ENVIRONMENTAL HEALTH  
3525-H ELLICOTT MILLS DRIVE/ELLICOTT CITY, MARYLAND 21043  
TELEPHONE: 313-2640

DISTRICT \_\_\_\_\_

DATE 5/20/98

TO: THE COUNTY HEALTH OFFICER  
ELLICOTT CITY, MARYLAND

I HEREBY APPLY FOR THE NECESSARY TEST PRIOR TO APPLICATION FOR PERMIT TO CONSTRUCT (OR RECONSTRUCT) A SEWAGE DISPOSAL SYSTEM.

PROPERTY OWNER BRS DEVELOPERS

ADDRESS 70 10805 HICKORY RIDGE ROAD PHONE 410-740-2100  
COLUMBIA MD 21044

AGENT OR PROSPECTIVE BUYER DONALD R REOWER @ LAND DESIGN & DEV. INC

ADDRESS 10805 HICKORY RIDGE ROAD PHONE 410 740 3244

PROPERTY LOCATION: COLUMBIA, MARYLAND 21044

SUBDIVISION WILGETS PROPERTY LOT NO. 2 3

ROAD AND DESCRIPTION LEFT SIDE LONG CORNER ROAD OPPOSITE

NEW CUT ROAD, SITE BACKS TO PATUXENT RIVER STATE PARK

TAX MAP 6 PARCEL # 55 GRID 21

SIZE OF LOT \_\_\_\_\_ TYPE BLDG. SINGLE FAMILY DWELLING  
(SINGLE FAMILY DWELLING OR COMMERCIAL)

THE SYSTEM INSTALLED UNDER THIS APPLICATION IS ACCEPTABLE ONLY UNTIL PUBLIC FACILITIES BECOME AVAILABLE. I FULLY UNDERSTAND THE FEE CONNECTED WITH THE FILING OF THIS PERC TEST APPLICATION IS NON-REFUNDABLE UNDER ANY CIRCUMSTANCES. I ALSO AGREE TO COMPLY WITH ALL M.O.S.H.A. REQUIREMENTS IN TESTING THIS LOT. DONALD R REOWER JR.  
(SIGNATURE OF APPLICANT)

APPROVED BY \_\_\_\_\_ FOR \_\_\_\_\_ DATE \_\_\_\_\_

DISAPPROVED BY \_\_\_\_\_ FOR \_\_\_\_\_ DATE \_\_\_\_\_

HOLD PENDING FURTHER TESTS \_\_\_\_\_

REASONS FOR REJECTION OR HOLDING \_\_\_\_\_

PERCOLATION TEST PLAT/PRELIMINARY PLAT - TITLE OR I.D. # \_\_\_\_\_ DATE \_\_\_\_\_

SITE DEVELOPMENT PLAN/FINAL PLAT - TITLE OR I.D. # \_\_\_\_\_ DATE \_\_\_\_\_



# THIS IS NOT A PERMIT

A510157



LONG CORNER ROAD

COUNTY #

SOIL PROFILE

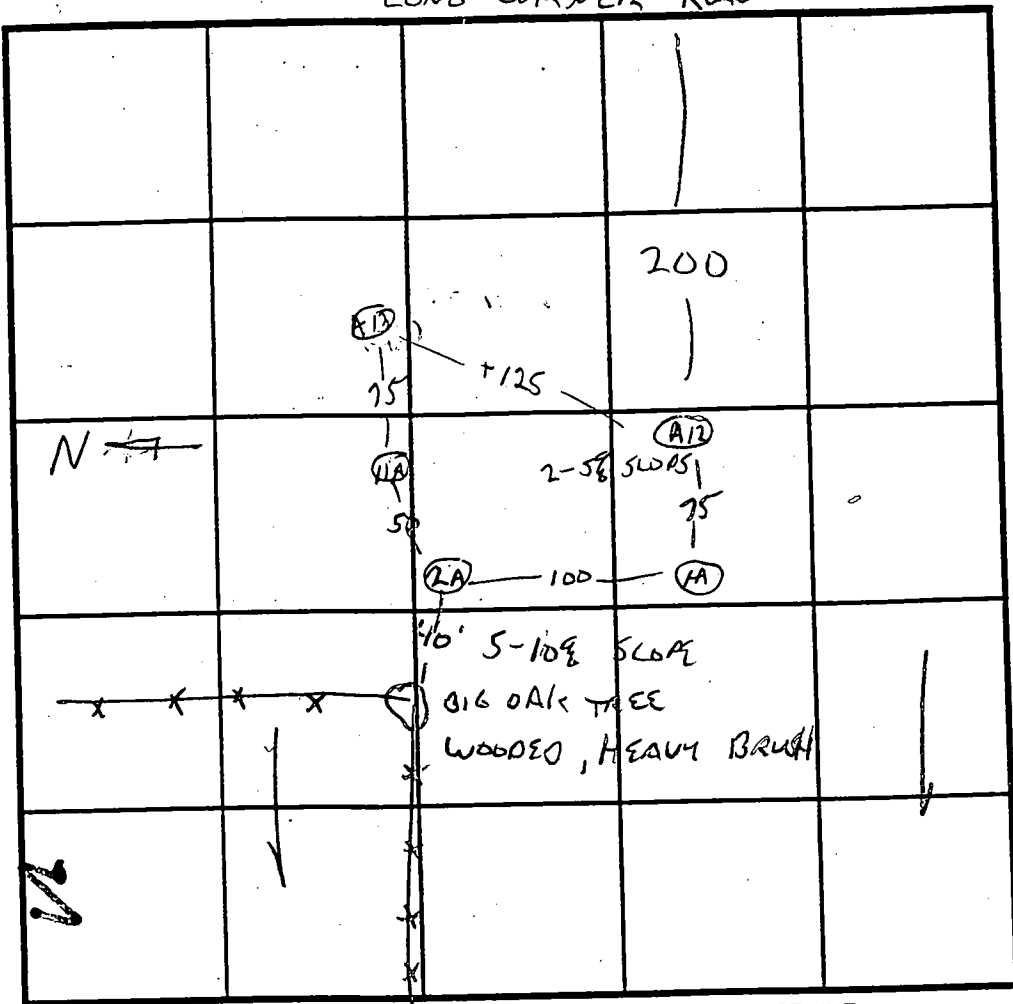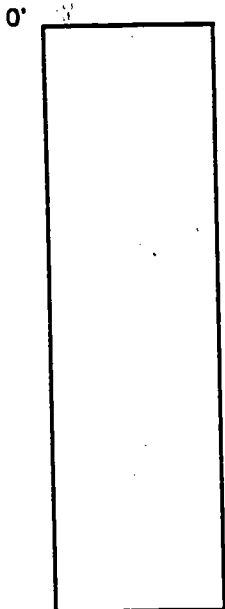

SOIL PROFILE  
A1 A2

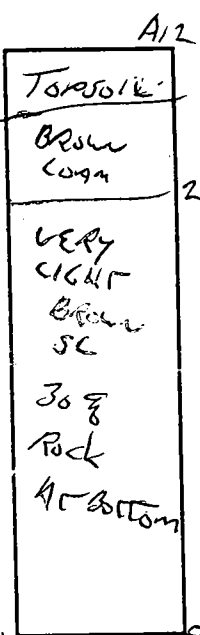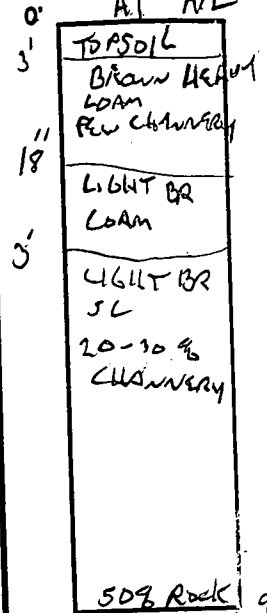

INDICATE NORTH - NAME ADJOINING ROADWAY AS BASE LINE.

DATE	TEST NO.	DEPTH	PRE-WET		TEST - 1" DROP		TIME
			START	STOP	START	STOP	
6/17/98	A1	2/9	11:16	11:20	→	11:35	15 min
	A2	2.5/9	11:40	puiso @ 12:04		1/4 inch	
		5	12:42	12:57	→	12:58	29 min
	11A	3/10V	ok	Rock 50% @ 10'			ok
	A12	3.5/9.5	4:43	4:45	→	4:47	2 min
	A13	similar	to A12	NO ROCK	DUST @ 12'	NO ROCK	ok

REMARKS LOT 2

TYPE OF SOIL \_\_\_\_\_

TESTED BY G. SAVAGE ALSO PRESENT MIKE JOHNSON, SAN

TRENCH DESIGN DATA: AVERAGE PERCOLATION TIME \_\_\_\_\_ TRENCH WIDTH \_\_\_\_\_

INLET DEPTH \_\_\_\_\_ MAXIMUM BOTTOM DEPTH \_\_\_\_\_ SQ. FT./BEDROOM \_\_\_\_\_

004

SCRIVENER INC

05/04/99 TUE 15:09 FAX 14108642820

NON-BUILDABLE  
1,180,909 SQ. FT.  
OR  
27.11 ACRES

PRESERVATION PARCEL A  
1,133,655 SQ. FT.  
OR  
26.03 ACRES

A510157

LOT 3  
60,000 SQ. FT.

LOT 2  
60,000 SQ. FT.

LOT 1  
60,000 SQ. FT.

TAX MAP 6  
PARCEL 74  
HEIDI FOREST MYERS  
CHARLES RANDALL BARNES  
LIBER 3196, FOLIO 663

TAX MAP 6  
PARCEL 143  
ROGER J. STEVENS &  
MARY H. DUKE-HART  
LIBER 4053, FOLIO 414

TAX MAP 6, PARCEL 136  
JOSEPH E. STUBBINGS  
LIBER 4192, FOLIO 72

RADUE PROPERTY,  
LOT B  
PLAT NO. 6938

WATZ PROPERTY,  
LOT 1  
PLAT NO. 4772

LONG CORNER ROAD  
80' PUBLIC ROW  
MINOR COLLECTOR

NEW CUT  
ROAD

WELL ASSUMED TO BE  
LOCATED IN THIS AREA

CENTERLINE

S68°42'41"W  
290.77'

N63°28'54"E  
191.40'

N16°01'08"W  
7.72'

No WSI stake found.  
Perc site looks O.K.  
6/22/99 BB

WSI stake found  
Site looks O.K.  
7/9/99 BB

MtD2

PRESERVATION PARCEL C  
NON-BUILDABLE  
1,180,909 SQ. FT.  
OR  
27.11 ACRES

Signed  
Perc Cert Plat  
9-16-98  
S.R.K.

MtB2

A510157


MtC3

LOT 3  
60,000 SQ. FT.

LOT 2  
60,000 SQ. FT.

LOT 1  
60,000 SQ. FT.

MtC2

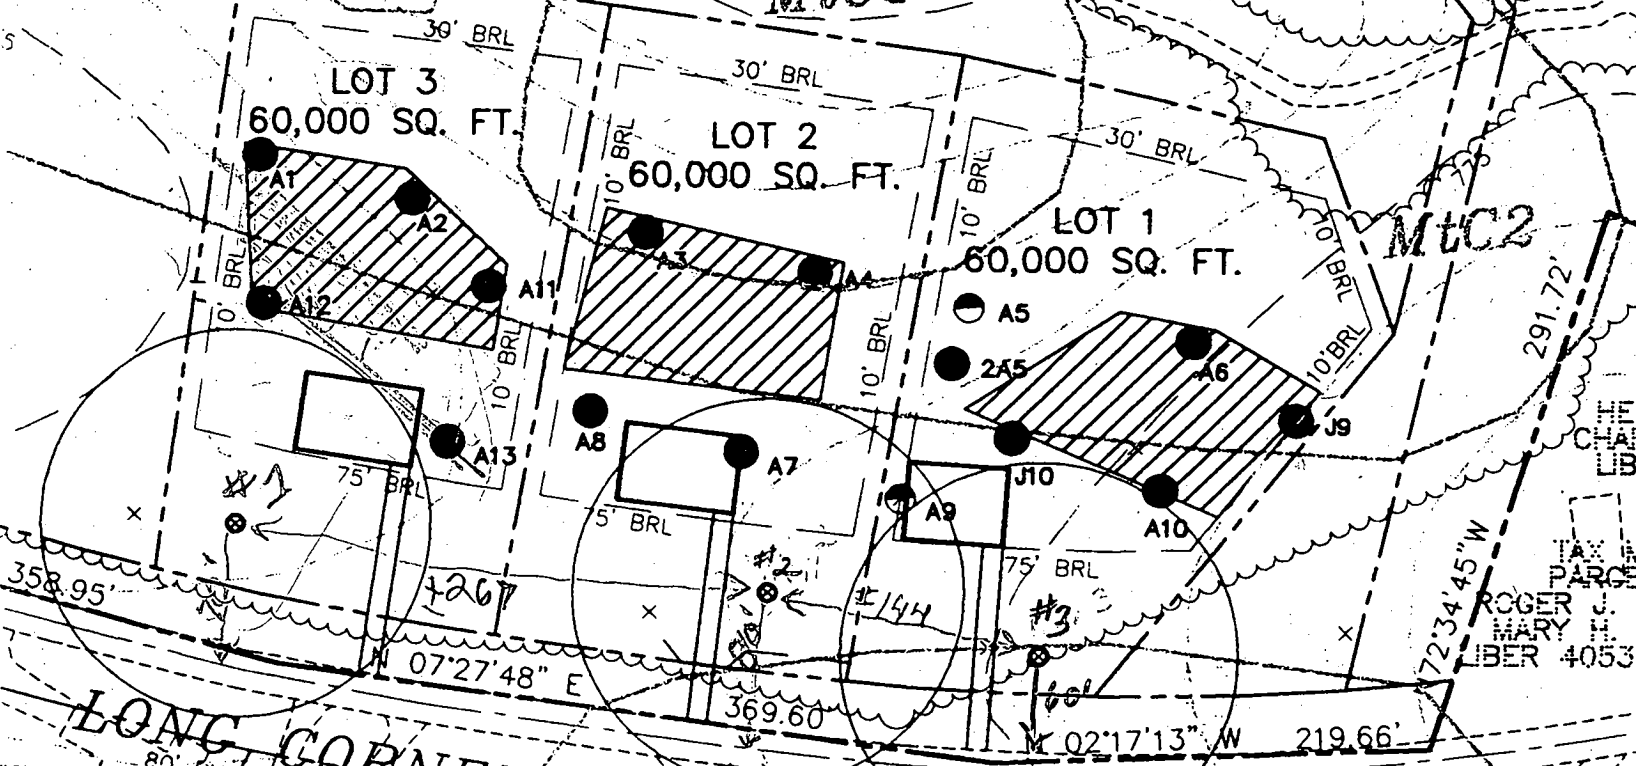

LONG CORNER ROAD  
MINOR COLLECTOR

RADUE PROPERTY,  
LOT 8  
PLAT NO. 6938

KATZ PROPERTY,  
LOT 1  
PLAT NO. 4772

TAX MAP 6, PARC  
JOSEPH E. STUB  
LIBER 4192, FOL

TAX PARCEL  
ROGER J.  
MARY H.  
LIBER 4053,

HE  
LA  
LB