

APPLICATION

PERCOLATION TESTING

A 38714

P _____

HOWARD COUNTY HEALTH DEPARTMENT
BUREAU OF ENVIRONMENTAL HEALTH
P.O. BOX 476 ELLICOTT CITY, MARYLAND 21043
TELEPHONE. 461-9933

DISTRICT 4

DATE 12/17/86

TO: THE COUNTY HEALTH OFFICER
ELLICOTT CITY, MARYLAND

I, HEREBY, APPLY FOR THE NECESSARY TEST IN ORDER TO CONSTRUCT (OR RECONSTRUCT) A SEWAGE DISPOSAL SYSTEM

PROPERTY OWNER Roy W. Cram + Wife

ADDRESS 791 Morgan Station Rd PHONE 489-4995

PROSPECTIVE BUYER Hemphill Partnership

ADDRESS 10176 Baltimore National Pike Suite 210 PHONE 465-5855

PROPERTY LOCATION: 815 Iron Rail Court lot 8 Prelim 10/21/8

SUBDIVISION Morgan Station (~~Cram Property~~) LOT NO. 8

ROAD AND DESCRIPTION E/S Morgan Station Rd north of Old Frederick Rd

TAX MAP 3 PARCEL # 9

SIZE OF LOT 3 acres TYPE BLDG SFD
(SINGLE FAMILY DWELLING OR COMMERCIAL)

THE SYSTEM INSTALLED UNDER THIS APPLICATION IS ACCEPTABLE ONLY UNTIL PUBLIC FACILITIES BECOME AVAILABLE. I FULLY UNDERSTAND THE FEE CONNECTED WITH THE FILING OF THIS PERC TEST APPLICATION IS NON-REFUNDABLE UNDER ANY CIRCUMSTANCES. I ALSO AGREE TO COMPLY WITH ALL M.O.S.H.A. REQUIREMENTS IN TESTING THIS LOT. Mark Kinn
(SIGNATURE OF APPLICANT)

APPROVED BY _____ FOR _____ DATE _____

REJECTED BY _____ FOR _____ DATE _____

HOLD PENDING FURTHER TESTS _____ DATE _____

REASONS FOR REJECTION OR HOLDING 4/24/87 PERC OK HOLD FOR

PLD


THIS IS NOT A PERMIT

1 2 3
SOIL PROFILE

0
CLAY TOPSOIL
3
BROWN SAND LOAM 5% SAPROLITE

4

3
BROWN CLAY
3
BROWN SANDY LOAM 15% SAPROLITE

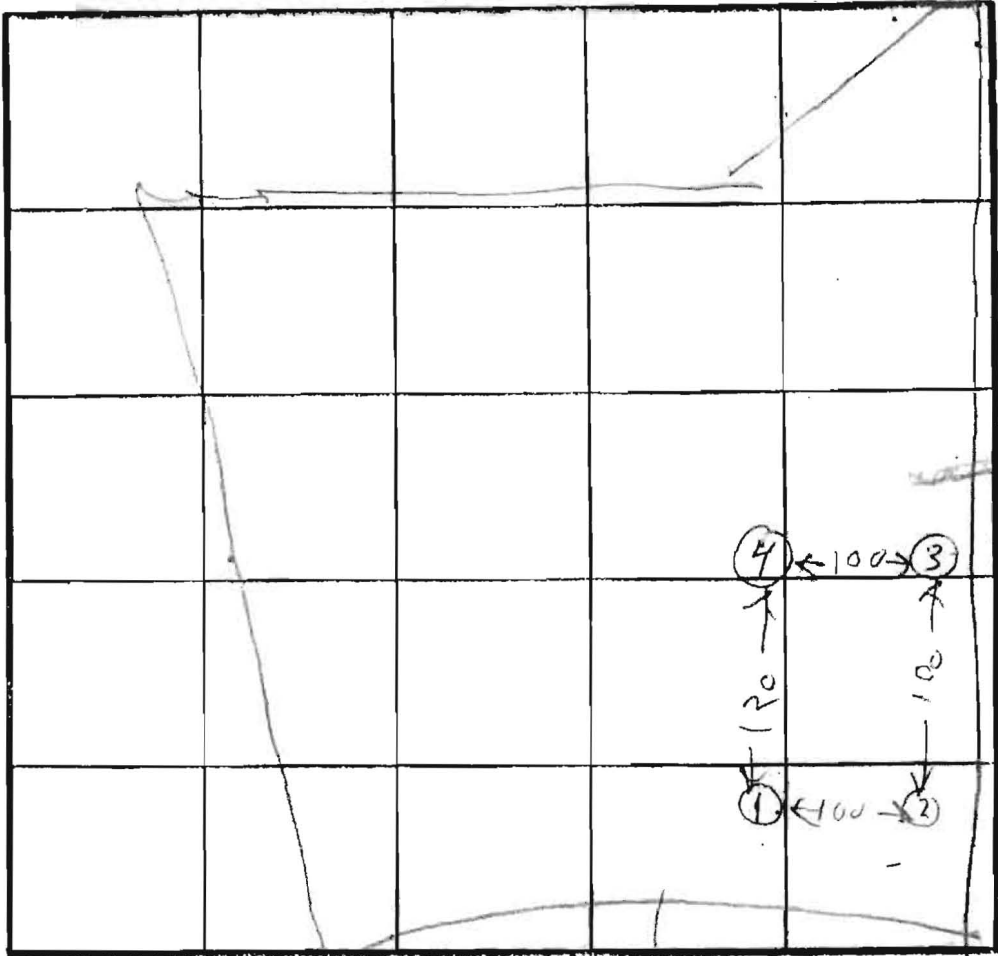

INDICATE NORTH - NAME ADJOINING ROADWAY AS BASE LINE.

UNNAMED RD

DATE	TEST NO.	DEPTH	PRE-WET		TEST - 1" DROP		TIME
			START	STOP	START	STOP	
4/24/67	1S	4.5	1037	1038	1038	1043	5
	1V	11	OK				
	2V	11	OK				
	3S	4	1044	1059	1039	1102	9
	3V	7	104	1055	1055	1104	9
	3V	11	OK				
	4S	3 1/2	1102	1109	1109	1123	14
	4V	11	OK				

av
Time
9 min

max
Depth
3 FT


Bottom
5'
190 #18

REMARKS: Hole 1 2 3 4 dug per Surveyor's Plat.

TYPE OF SOIL:

TESTED BY: Raymond Hodges

ALSO PRESENT: KETTERMAN & SON

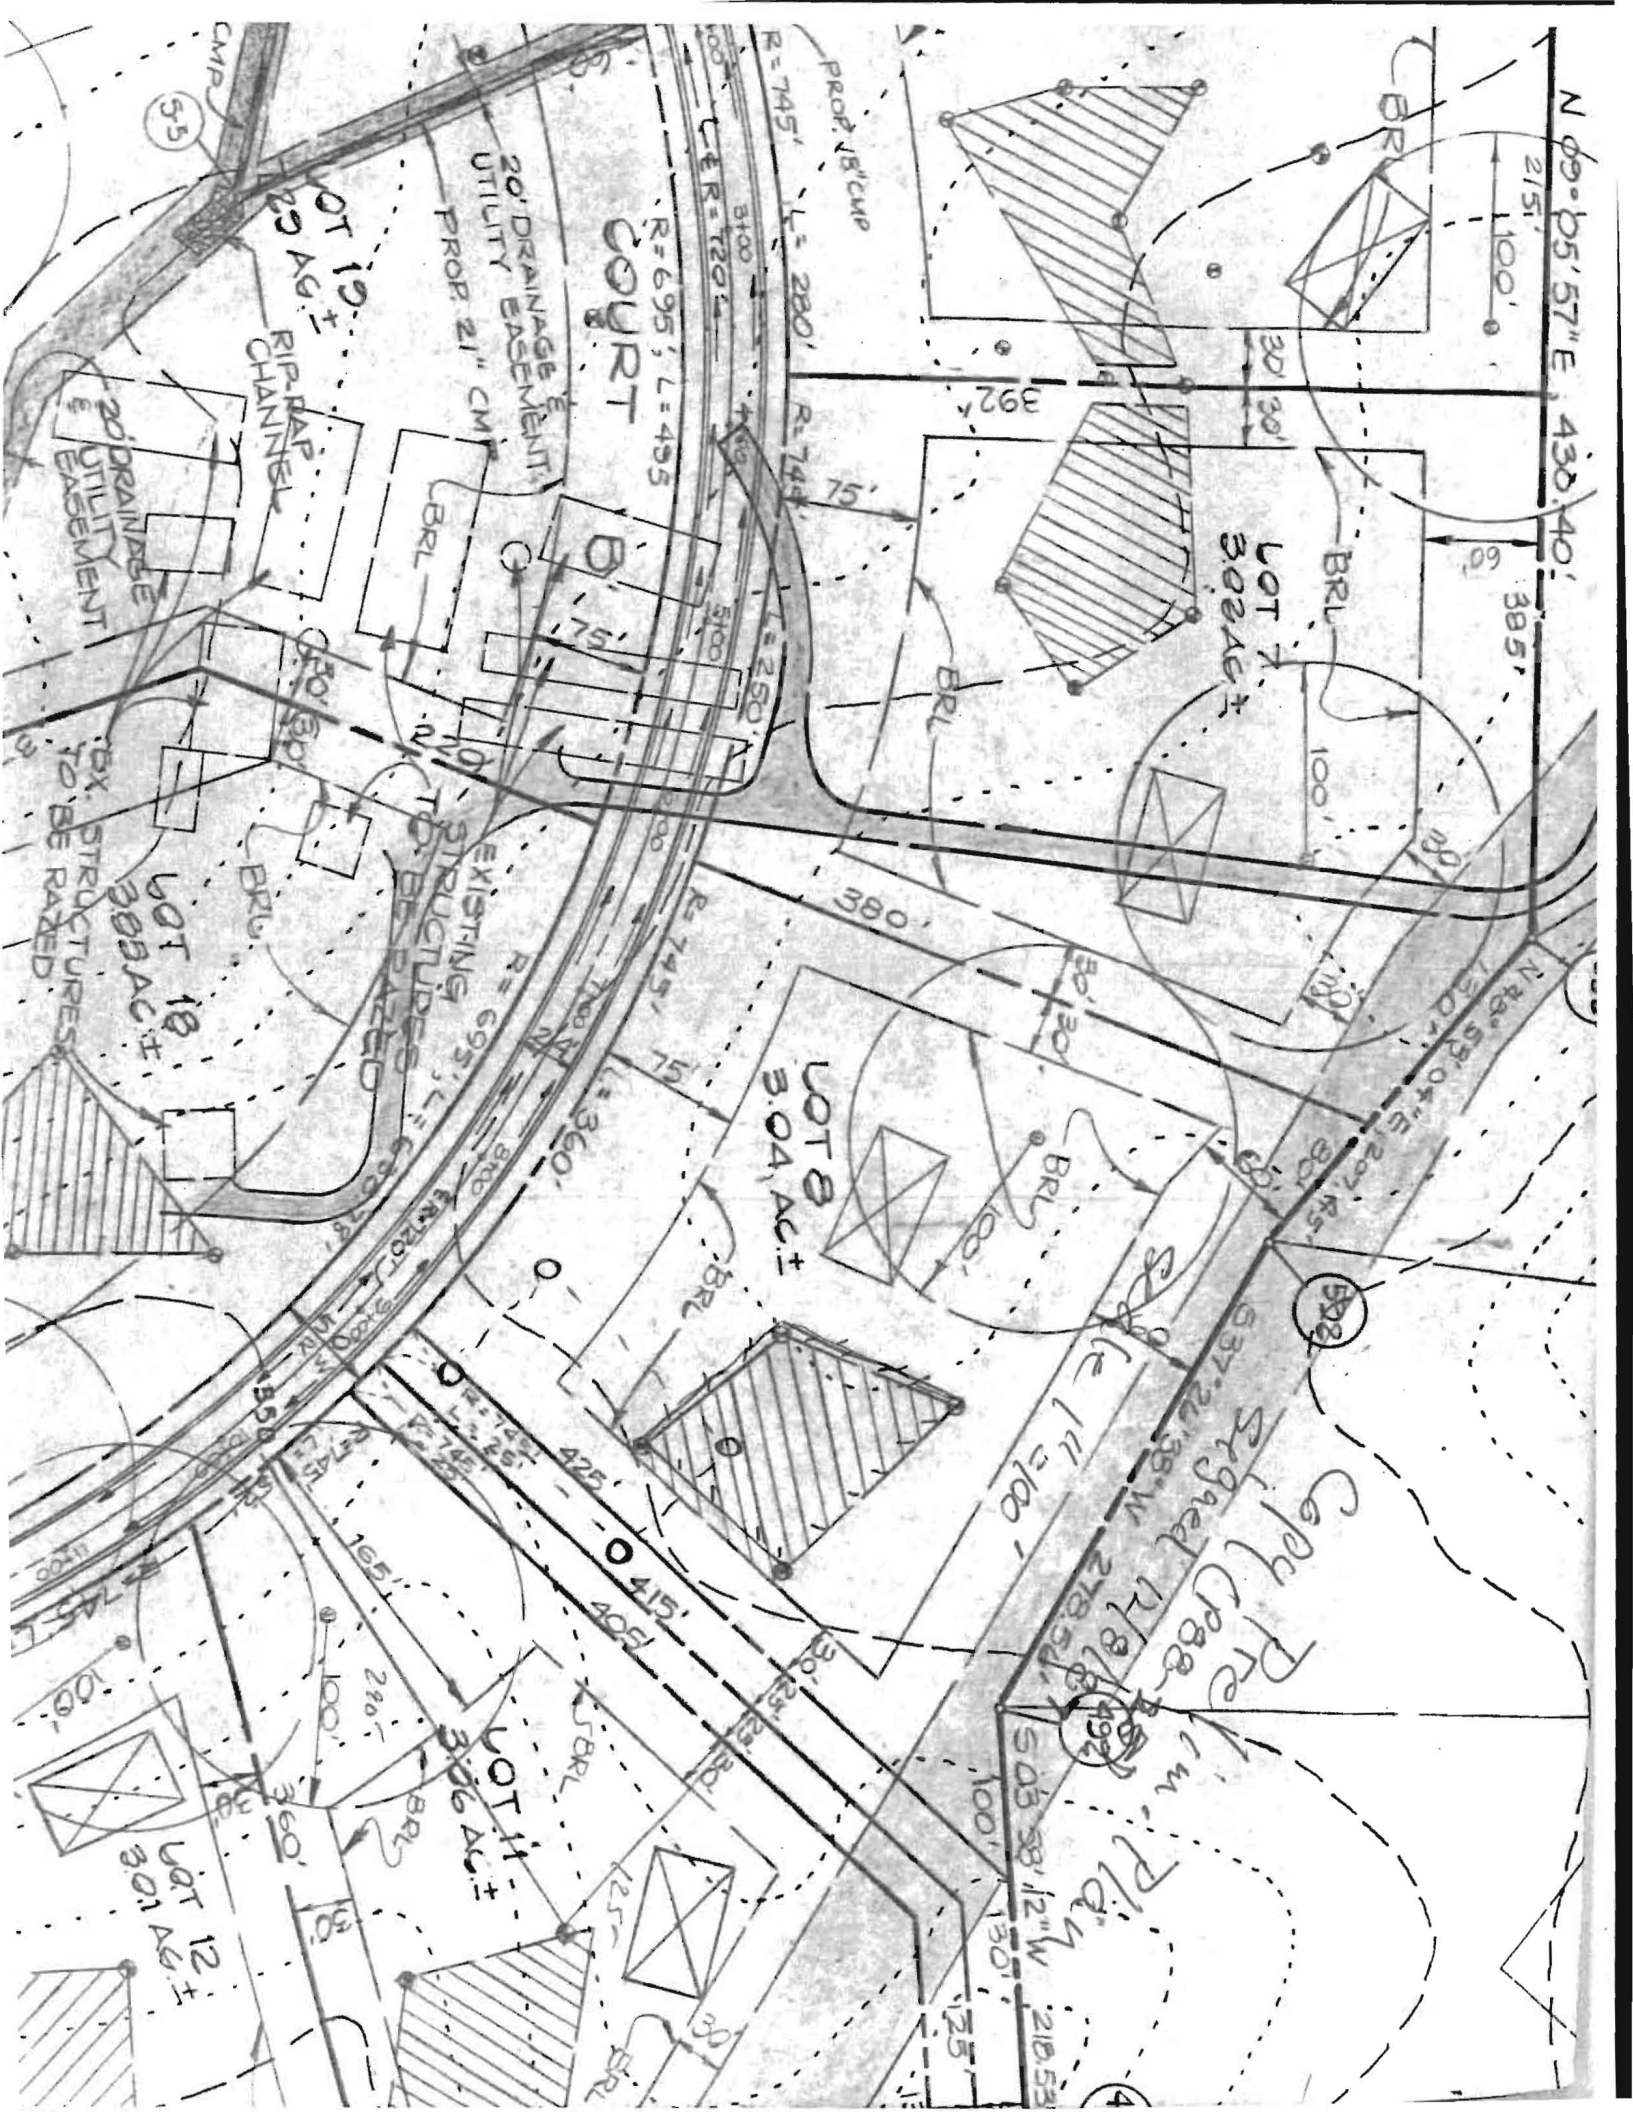

N 09° 05' 57" E 430' 40'

215' 100'

385' 61'

BR

30' 30'

LOT 7
302 AC ±

BRL

100'

100'

N 48° 59' 04" E 201' 45'

592

Copy Plan
Signed 12/8/88
1/11/88

Scale 1" = 300'

Plan

COURT

R = 695', L = 435'

PROP. 18" CM

R = 745', L = 280'

R = 745', L = 250'

R = 745', L = 360'

R = 695', L = 630'

R = 745', L = 425'

R = 745', L = 405'

R = 745', L = 360'

R = 745', L = 360'

R = 745', L = 360'

R = 745', L = 360'

LOT 12
301 AC ±

LOT 11
306 AC ±

LOT 10
308 AC ±

LOT 8
304 AC ±

LOT 9
306 AC ±

LOT 7
302 AC ±

LOT 6
302 AC ±

LOT 5
302 AC ±

20' DRAINAGE
UTILITY EASEMENT

20' DRAINAGE
UTILITY EASEMENT

EXISTING
STRUCTURES
TO BE RAZED

EXISTING
STRUCTURES
TO BE RAZED

CAMP

RIP-RAP
CHANNEL

UTILITY
DRAINAGE
EASEMENT

UTILITY
DRAINAGE
EASEMENT

