

APPLICATION

PERCOLATION TESTING

A _____

P _____

HOWARD COUNTY HEALTH DEPARTMENT
BUREAU OF ENVIRONMENTAL HEALTH
3525-H ELLICOTT MILLS DRIVE/ELLICOTT CITY, MARYLAND 21043
TELEPHONE: 313-2640

DISTRICT _____

DATE _____

TO: THE COUNTY HEALTH OFFICER
ELLICOTT CITY, MARYLAND

I HEREBY APPLY FOR THE NECESSARY TEST PRIOR TO APPLICATION FOR PERMIT TO CONSTRUCT (OR RECONSTRUCT) A SEWAGE DISPOSAL SYSTEM.

PROPERTY OWNER _____

ADDRESS _____ PHONE _____

AGENT OR PROSPECTIVE BUYER _____

ADDRESS _____ PHONE _____

PROPERTY LOCATION:

SUBDIVISION _____ LOT NO. 46 35

ROAD AND DESCRIPTION _____

TAX MAP _____ PARCEL # _____

SIZE OF LOT _____ TYPE BLDG. _____
(SINGLE FAMILY DWELLING OR COMMERCIAL)

THE SYSTEM INSTALLED UNDER THIS APPLICATION IS ACCEPTABLE ONLY UNTIL PUBLIC FACILITIES BECOME AVAILABLE. I FULLY UNDERSTAND THE FEE CONNECTED WITH THE FILING OF THIS PERC TEST APPLICATION IS NON-REFUNDABLE UNDER ANY CIRCUMSTANCES. I ALSO AGREE TO COMPLY WITH ALL M.O.S.H.A. REQUIREMENTS IN TESTING THIS LOT.

(SIGNATURE OF APPLICANT)

APPROVED BY _____ FOR _____ DATE _____

DISAPPROVED BY _____ FOR _____ DATE _____

HOLD PENDING FURTHER TESTS _____

REASONS FOR REJECTION OR HOLDING _____

PERCOLATION TEST PLAT/PRELIMINARY PLAT - TITLE OR I.D. # _____ DATE _____


SITE DEVELOPMENT PLAN/FINAL PLAT - TITLE OR I.D. # _____ DATE _____

THIS IS NOT A PERMIT

COUNTY #

SOIL PROFILE

0' 1291
 brn orge
 lt. brn
 hvy lm
 20-25% Rx
 6 1/2
 tan
 sa lm
 8 white weathers
 quartz
 10 tan salm
 10% frags
 13 1/2

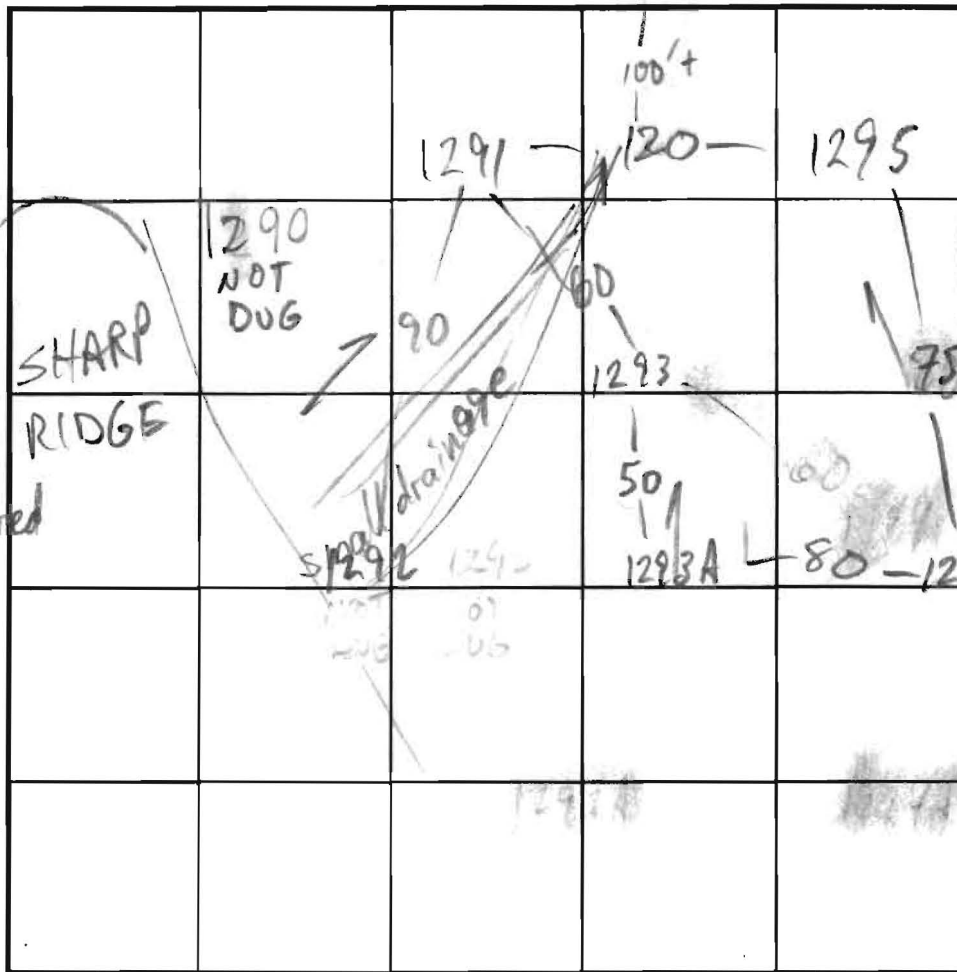

SOIL PROFILE

0' 1293A
 orge
 brn
 cl lm
 hvy lm
 20% Rx
 6
 tan
 lt brn
 sa lm
 10-15%
 frags
 13 1/2

INDICATE NORTH - NAME ADJOINING ROADWAY AS BASE LINE.

1295
 bright
 orge sa
 cl lm
 1 1/2
 3 1/2 pink
 4 lt. orge
 tan beige
 3
 Sa lm
 EAST
 pocket
 of
 25-30%
 Rx
 WEST
 12-129
 Rx

| DATE | TEST NO. | DEPTH | PRE-WET | | TEST - 1" DROP | | TIME | |
|--------|----------|----------------|----------------|------|----------------|------|------|---|
| | | | START | STOP | START | STOP | | |
| 9/9/03 | 1291 | 7 1/2" 13 1/2" | 2:49 | 2:51 | 2:51 | 2:54 | 3 | |
| | 1295 | 12 9" | | | | | | |
| | 1293 | 8 1/2 12" | 3:25 | 3:38 | 3:38 | 3:56 | 18 | |
| | 1292 | 10 9" | ALL ORGE CL LM | | | | | R |
| | 1294A | 12" | HARD BOT | | | | | |
| | 1293A | 6 9" 13 3" | 4:02 | 4:04 | 4:04 | 4:08 | 4 | |
| | | | | | | | | |
| | | | | | | | | |
| | | | | | | | | |
| | | | | | | | | |

REMARKS _____
 TYPE OF SOIL _____
 TESTED BY M. Riskin ALSO PRESENT _____
 TRENCH DESIGN DATA: AVERAGE PERCOLATION TIME _____ TRENCH WIDTH _____
 INLET DEPTH _____ MAXIMUM BOTTOM DEPTH _____ SQ. FT./BEDROOM _____

1293
 orge brn
 hvy lm
 2 pink orge
 sa silm
 4 tan salm
 10% frags
 6 cl
 7 25-30%
 frags
 8 ON
 WEST
 10 tan sa lm
 10% frags
 12

copy of
Per cert signed 7/30/2010

LOT 35
44,473 SQ.FT.

NOTE:
FIRST FLOOR
SEWER SERVICE ONLY
BASEMENT WILL NOT
SEWER BY GRAVITY.

2,000 GAL.
SEPTIC TANK
INV. IN 501.50
INV. OUT 501.20.293A

DIST. BOX
EX. GRD. 504.00
INV. IN 501.00

WYNTERHALL
(REV.)

MORN. ROOM
FF 512.00
B 502.16
GAR.
510.33

LOT 36
49,515 SQ.FT.

WYNTERHALL
FF 516.00
B 506.16
GAR.
514.33

772 SQ. FT.
NON-ROOFTOP
DRIVEWAY
DISCONNECT
2,000 GAL.
SEPTIC TANK
INV. IN 513.60
INV. OUT 513.30

CLIFTON PARK

FF 520.00
B 510.16
(REV.)
GAR.
518.33

504 SQ. FT.
NON-ROOFTOP
DRIVEWAY
DISCONNECT

10' X 17'
BIO-RETENTION
SYSTEM NO. 1

**NON-BUILDABLE
PRESERVATION
PARCEL 'I'**

1.00 AC.
OWNER: KENNARD WARFIELD, JR.
EASEMENT HOLDERS: HO. CO., MD. &
HOWARD COUNTY CONSERVANCY

EX. WELL
TO 5' SHAD
HO 95-0101

265.46'

10' PRIVATE ELECTRIC
& UTILITY EASEMENT

