

PRELIMINARY

APPLICATION

4 - 13 ft. holes on
10,000 sq. ft.

A 2433

P _____

SEWAGE DISPOSAL TESTING

STATE OF MARYLAND - DEPARTMENT OF HEALTH AND MENTAL HYGIENE

HOWARD COUNTY HEALTH DEPARTMENT
ENVIRONMENTAL HEALTH SERVICES
P. O. BOX 476, ELLICOTT CITY, MARYLAND 21043
TELEPHONE: 465-5000, EXT. 356

DISTRICT 5th

DATE 9/23/76

TO: THE COUNTY HEALTH OFFICER
ELLICOTT CITY, MARYLAND

I, HEREBY, APPLY FOR THE NECESSARY TEST IN ORDER TO CONSTRUCT (OR RECONSTRUCT) A SEWAGE DISPOSAL SYSTEM.

PROPERTY OWNER V. L. Vinella

ADDRESS 12631 Circle Drive, Glen Hills, Rockville, Md. PHONE (8) 762-3007

PROPERTY LOCATION: Green Hill Manor

SUBDIVISION Green Hill Manor LOT NO. 15 E Sect. 4

ROAD AND DESCRIPTION Villad'est Drive

Lot 16 on Final

SIZE OF LOT 46,700 sq. ft. TYPE BLDG. 3 or 4
NUMBER OF BEDROOMS

IF NOT SINGLE RESIDENCE DESCRIBE _____

THE SYSTEM INSTALLED UNDER THIS APPLICATION IS ACCEPTABLE ONLY UNTIL PUBLIC FACILITIES BECOME AVAILABLE.

SIGNATURE OF APPLICANT /s/ V. L. Vinella


APPROVED BY _____ FOR _____ DATE _____
(KIND OF SYSTEM)

REJECTED BY _____ FOR _____ DATE _____
(KIND OF SYSTEM)

HOLD PENDING FURTHER TESTS _____ DATE _____

REASONS FOR REJECTION OR HOLDING _____

THIS IS NOT A PERMIT

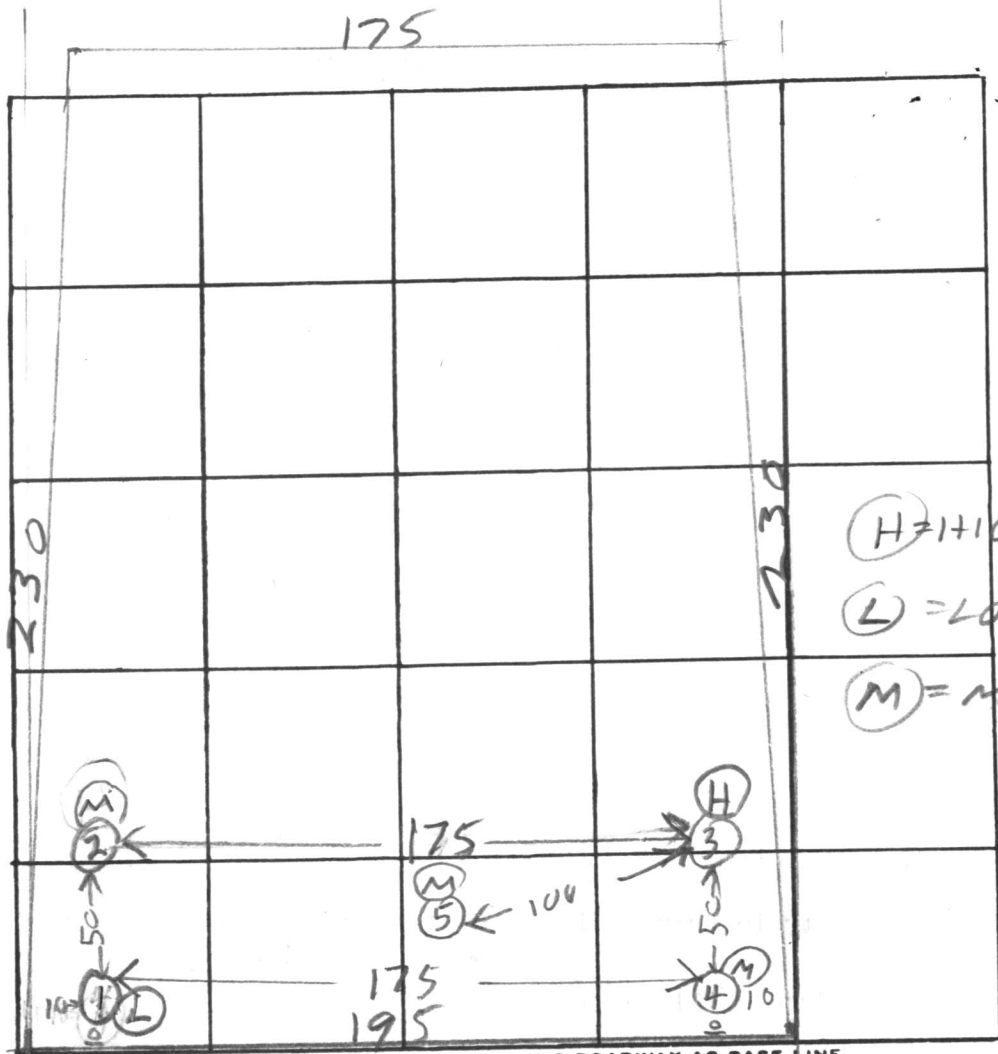

(H) = HIGHEST
 (L) = LOWEST
 (M) = MEDIUM LOW

INDICATE NORTH. - NAME ADJOINING ROADWAY AS BASE LINE.

LUSTER DR

DATE	TEST NO.	DEPTH	PRE-WET		TEST - 1" DROP		TIME
			START	STOP	START	STOP	
6/21/76	1S	5 1/2	1124	1125	1125	1127	2
	1D	12	1124	1127	1127	1134	7
	2S	5	1139	1140	1140	1143	2
	2D	12	1139	1140	1140	1145	5
	3S	5	1150	1152	1152	1157	5
	3D	13	1149	1151	1151	1154	3
	4V	12	TOP 4 FT CLAY		2 FT SANDY CLAY		DRY
6/22/76	5V	12 1/2	TOP 3 FT CLAY		9 FT SANDY CLAY		

USE FOR DW

REMARKS At time 5 min Max Depth 4 ft

TYPE OF SOIL _____

TESTED BY RH

ALSO PRESENT Lot 15 E

Wmwd Barrett Fryock