

APPLICATION

A 23898

SEWAGE DISPOSAL TESTING

P _____

STATE OF MARYLAND - DEPARTMENT OF HEALTH AND MENTAL HYGIENE

HOWARD COUNTY HEALTH DEPARTMENT
ENVIRONMENTAL HEALTH SERVICES
P. O. BOX 476, ELLICOTT CITY, MARYLAND 21043
TELEPHONE: 465-5000, EXT. 356

DISTRICT Third

DATE 9/9/76

TO: THE COUNTY HEALTH OFFICER
ELLICOTT CITY, MARYLAND

I, HEREBY, APPLY FOR THE NECESSARY TEST IN ORDER TO CONSTRUCT (OR RECONSTRUCT) A SEWAGE DISPOSAL SYSTEM.

PROPERTY OWNER S. Elwood Anderson
12,799 Triadelphia Road
ADDRESS Howard County, Maryland PHONE _____
Any questions call:
Boender - 465-7777

PROPERTY LOCATION:

SUBDIVISION Wayside Estates LOT NO. 8 Section 3

ROAD AND DESCRIPTION Scheel Ct.

SIZE OF LOT 1 acre m/l TYPE BLDG. 3 or 4 bedroom
NUMBER OF BEDROOMS

IF NOT SINGLE RESIDENCE DESCRIBE _____

THE SYSTEM INSTALLED UNDER THIS APPLICATION IS ACCEPTABLE ONLY UNTIL PUBLIC FACILITIES BECOME AVAILABLE.

SIGNATURE OF APPLICANT /s/ B. Albert Scheel, Jr.

APPROVED BY _____ FOR _____ DATE _____
(KIND OF SYSTEM)

REJECTED BY _____ FOR _____ DATE _____
(KIND OF SYSTEM)


HOLD PENDING FURTHER TESTS _____ DATE _____

REASONS FOR REJECTION OR HOLDING _____

THIS IS NOT A PERMIT

13
11
14
14
52

A23898

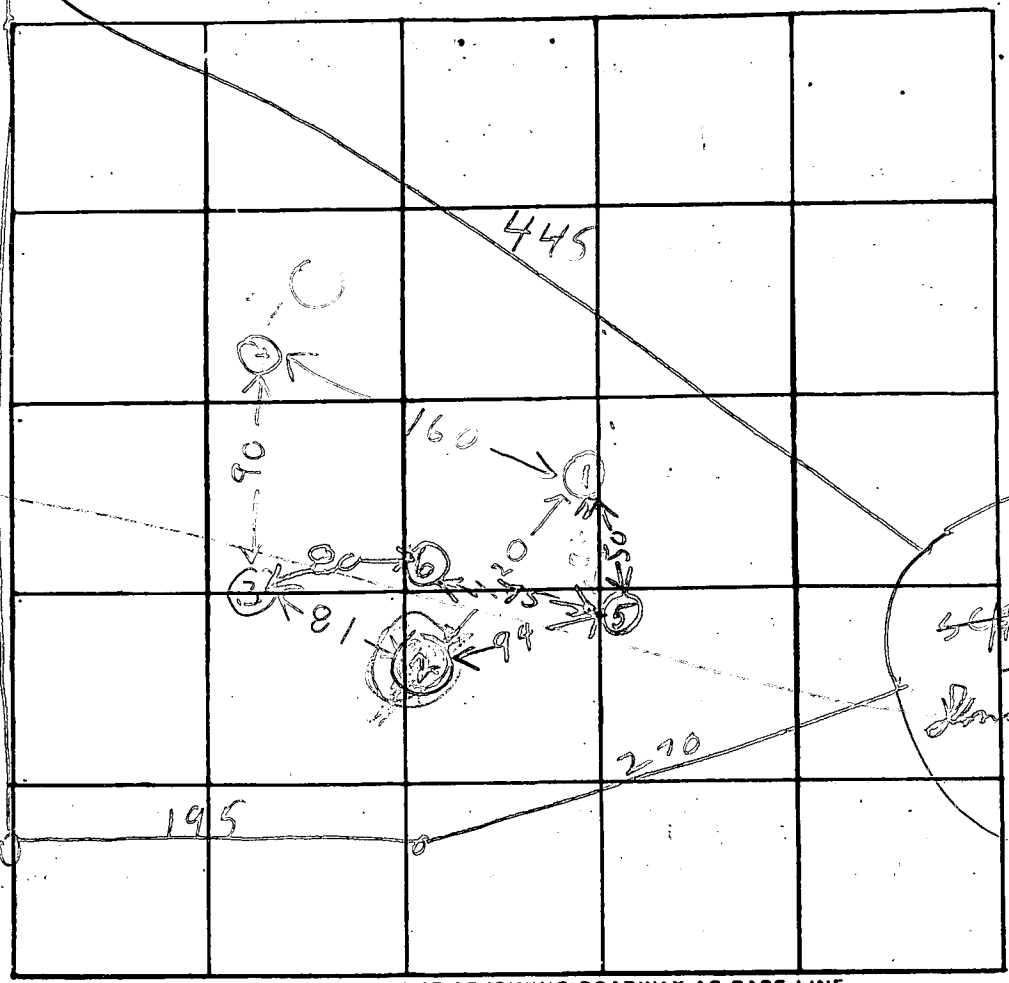

155
70
1950

INDICATE NORTH. - NAME ADJOINING ROADWAY AS BASE LINE.

DATE	TEST NO.	DEPTH	PRE-WET		TEST - 1" DROP		TIME
			START	STOP	START	STOP	
9/21/76	1 D	13	1135	1139	1139	1149	9
	1 S	4 1/2	1136	1137	1137	1138	1
	2 D	13	1151	1215	1215	1236	21
	2 S	4	1151	1215	little perc	FAILED	
	3 S	4	1203	1204	1204	1205	1
	3 D	13 1/2	1206	1214	1214	1221	7
	4 D	12 1/2	1219	1237	1237	105	28
9/21/76	4 S	4	1219	1220	1220	1221	1
	2 M	6	219	252	little perc	FAILED	
9/21/76	5 S	4 1/2	1210	1212	1212	1215	3
	5 D	13	1212	1221	1221	1231	10

HOLES
ELEVATION

LOWEST

NEXT
LOWEST

USING NW
HIGH

SAME
AS (4)

HIGH
SAME AS (3)

REMARKS 6V 12 TOP SET CLAY BOT LOG SAND dry

TYPE OF SOIL Max Depth 4 ft Carbon 9 min 9/21/76 - SAUTERSSWELL

TESTED BY R.H. 9/21/76 R.H. ALSO PRESENT: 9/21/76 Lot 9

D RUSH
ASCHEEL

52
7
364