

03-304701

SEPTIC SYSTEM TO BE INSTALLED
FIRST BEFORE BUILDING PERMIT
IS SIGNED.

PERMIT

P 30141

A 23898

SEWAGE DISPOSAL SYSTEM

MARYLAND STATE DEPARTMENT OF HEALTH

HOWARD COUNTY

ELLICOTT CITY

DISTRICT 3rd

DATE 9/4/79

INDEXED

~~9/21/79~~
~~9/24/79~~

Pat Lendrim

IS PERMITTED TO INSTALL ALTER

ADDRESS _____ PHONE _____

SUBDIVISION Wayside Estates ROAD 3619 Lynway Court LOT 8, Sec. 3

PROPERTY OWNER Tom Reigle Greg Peppers

ADDRESS 3368-C N. Chatham Road, Ellicott City, Md.

SPECIFICATIONS 3 bedrooms

BLDG. PERMIT SIGNED
AND RETURNED 7-29-79
Serial # 119611

SEPTIC TANK CAPACITY 1000 GALLONS
DRAIN FIELD _____ DEPTH _____ FEET, BOTTOM AREA _____ SQ. FT.
DEEP TRENCH _____ DEPTH _____ FEET, BOTTOM AREA _____ SQ. FT.
SEEPAGE PITS ABSORBENT SIDE-WALL AREA 120 SQ. FT. per bedroom, in system.
INLET PIPE 4 FT. BELOW ORIGINAL GRADE. MAXIMUM DEPTH 13 FT. BELOW ORIGINAL GRADE
EFFECTIVE DEPTH AT _____ FT. BELOW ORIGINAL GRADE.
LOCATE DISPOSAL AREA _____ FT. FROM _____ LOT LINE AND _____ FT. FROM _____ LOT LINE AS SEEN WHEN FACING LOT FROM

Place the dry well 250 ft. from the front lot line and 106 ft. from the left lot line as seen when facing the lot from Lynway Court.

B.P. Appl. # 41219 Serial # 10.3

PLANS APPROVED BY Raymond Hodges DATE 10/7/77

COVER NO WORK UNTIL INSPECTED AND APPROVED.
NEITHER THE HOWARD COUNTY COUNCIL NOR THE HEALTH DEPARTMENT IS RESPONSIBLE FOR THE SUCCESSFUL OPERATION OF ANY SYSTEM.
NOTE: IF TRENCH IS USED CALL FOR INSPECTION BEFORE PLACING GRAVEL IN TRENCH.
NOTE: NO DRY WELL SHALL EXCEED 15 FOOT IN DIAMETER.
NOTE: ALL PIPE FROM HOUSE TO DISPOSAL AREA MUST BE CAST IRON.
PERMIT VOID AFTER THREE YEARS.
NOTE: INSTALL STAND PIPE ON SEPTIC TANK AND DRY WELL. STAND PIPES MUST BE 6 INCHES IN DIAMETER. CAST IRON, CONCRETE OR TERRA COTTA ACCEPTED.

BLDG. PERMIT SIGNED
AND RETURNED 10-3-79

***INSTALLER IS RESPONSIBLE FOR OBTAINING FINAL APPROVAL ON THIS PERMIT.**


HD - 23

BLDG. PERMIT SIGNED
AND RETURNED 6-15-79
Serial # B70118545
Bedroom extension

BLDG. PERMIT SIGNED
AND RETURNED 2/2/80
Serial # 31112 - 1st fl

A 23898

A23898

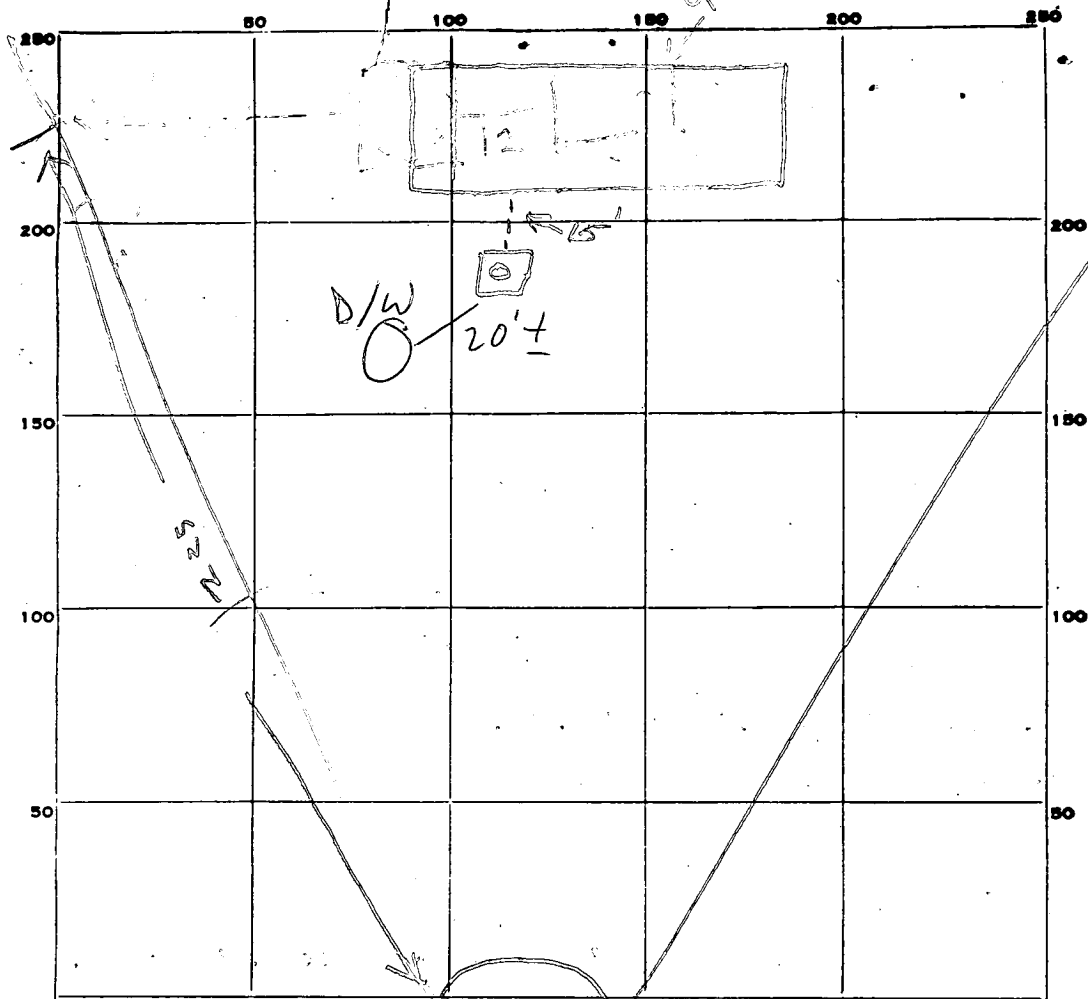

PERMIT CARD _____

ST / DW

SEPTIC TANK, LEVEL OK 1000

CLEANOUTS MANHOLE / OK

DISTRIBUTION BOX, LEVEL TOP 3 FT BELOW GRADE

TILE FIELD, DEPTH _____ FT. TRENCH WIDTH _____ FT.

GRAVEL DEPTH _____ IN. TOTAL LENGTH _____ FT.

NUMBER OF TRENCHES _____ TOTAL BOTTOM AREA _____

SEEPAGE PITS, INSIDE DIAMETER PERIMETER 52 FT. DEPTH BELOW INLET 7 FT.

ABSORBENT AREA 364 SQ. FT.

REMARKS 9/24/79 - DW INLET 4 FT BELOW GRADE. WELL SITE OK
CONNECT TANK TO HOUSE & CALL RH

5/12/81 - water test, house connection, O.K. J

DATE SYSTEM APPROV 5/12/81

INSPECTOR Stayer

