

MARYLAND DEPARTMENT OF THE ENVIRONMENT, WATER MANAGEMENT ADMINISTRATION  
1800 Washington Blvd., Baltimore, Maryland 21230 (410) 537-3784

WATER WELL ABANDONMENT-SEALING REPORT FORM

SUBMIT COPIES OF COMPLETED FORM TO:

- \* COUNTY ENVIRONMENTAL AGENCY (contact MDE, WMA if address needed)
- \* WELL OWNER
- \* MDE, WATER MANAGEMENT ADMINISTRATION, WELL PROGRAM

DATE WELL ABANDONED: 10-6-2015 (month/day/year)

\* PERMIT NUMBER OF ABANDONED WELL (if any)

Ho-81-2119

\* PERMIT NUMBER OF REPLACEMENT WELL:

Ho-14-008

\* PERSON ABANDONING WELL: Joseph L. Mayne WELL DRILLER'S LICENSE NUMBER MSD 024

CIRCLE: MWD / MSD / MGD

\* OWNER'S NAME: Wayne Greenfield


\* WELL LOCATION:

COUNTY: Howard  
 NEAREST TOWN: Highland  
 TAX MAP 34 BLOCK 14 PARCEL 391  
 SUBDIVISION: Green Hill Manor  
 SECTION: \_\_\_\_\_ LOT: \_\_\_\_\_  
 STREET ADDRESS: 6656 Luster Drive

LATITUDE 39.19247

LONGITUDE 76.98111

SITE LOCATION MAP

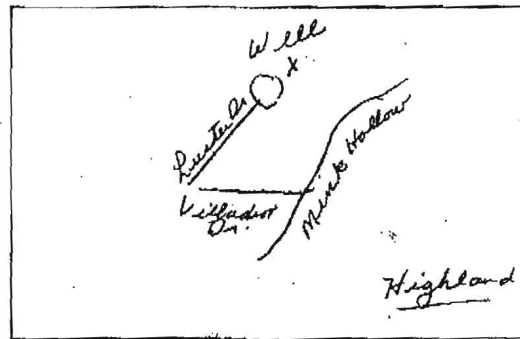

\* TYPE OF WELL BEING ABANDONED:

- DRILLED  JETTED
- BORED  HAND DUG
- OTHER (specify) \_\_\_\_\_

\* USE CODE:

- DOMESTIC  MUNICIPAL/PUBLIC
- IRRIGATION  INDUSTRIAL
- TEST/OBSERVATION  GEOTHERMAL

\* TYPE OF CASING:

- STEEL  PLASTIC
- CONCRETE  OTHER (specify) \_\_\_\_\_

SIZE OF CASING: 6 INCHES IN DIAMETER

DEPTH OF WELL: 140 FEET DEEP

WAS ANY CASING REMOVED?  YES  NO

If yes, length removed, in feet: 1

WAS CASING RIPPED OR PERFORATED?  YES  NO

LOG OF SEALING MATERIAL

MATERIAL	FEET	
	FROM	TO
<u>Cement &amp; gravel mixed</u>	<u>0</u>	<u>140</u>

VOLUME OF MATERIAL USED

SIGNATURE-MASTER WELL DRILLER OR SUPERVISING SANITARIAN Joseph L. Mayne LICENSE# MSD

CIRCLE ONE MWD / MSD / MGS

DATE 10-6-15