

BENSON SUBDIVISION - SECTION 1  
 PLAT BOOK 29 FOLIO 43

S 03° 01' 47" E

308.00'

LOT 6  
 58,223 S.F.

AREA added

RECORDED DISPOSAL  
 AREA

PTIC DATA (Lot 6)

10'x10'x9'DEEP = 360 S.F.  
 2'DEEP x 14'LONG = 126 S.F.  
 TOTAL 486 S.F. REQ 480  
 DESIGN

*APP. SAN*  
*3 27 78*

"HERS"

Existing well

APPROVED


WALK-THRU BUILDING PERMIT

BP# 200155692 PH 34/27

APP. SAN KTB DATE: 8/19/05

DESC. OF WORK 47.5 x 4' well

... well

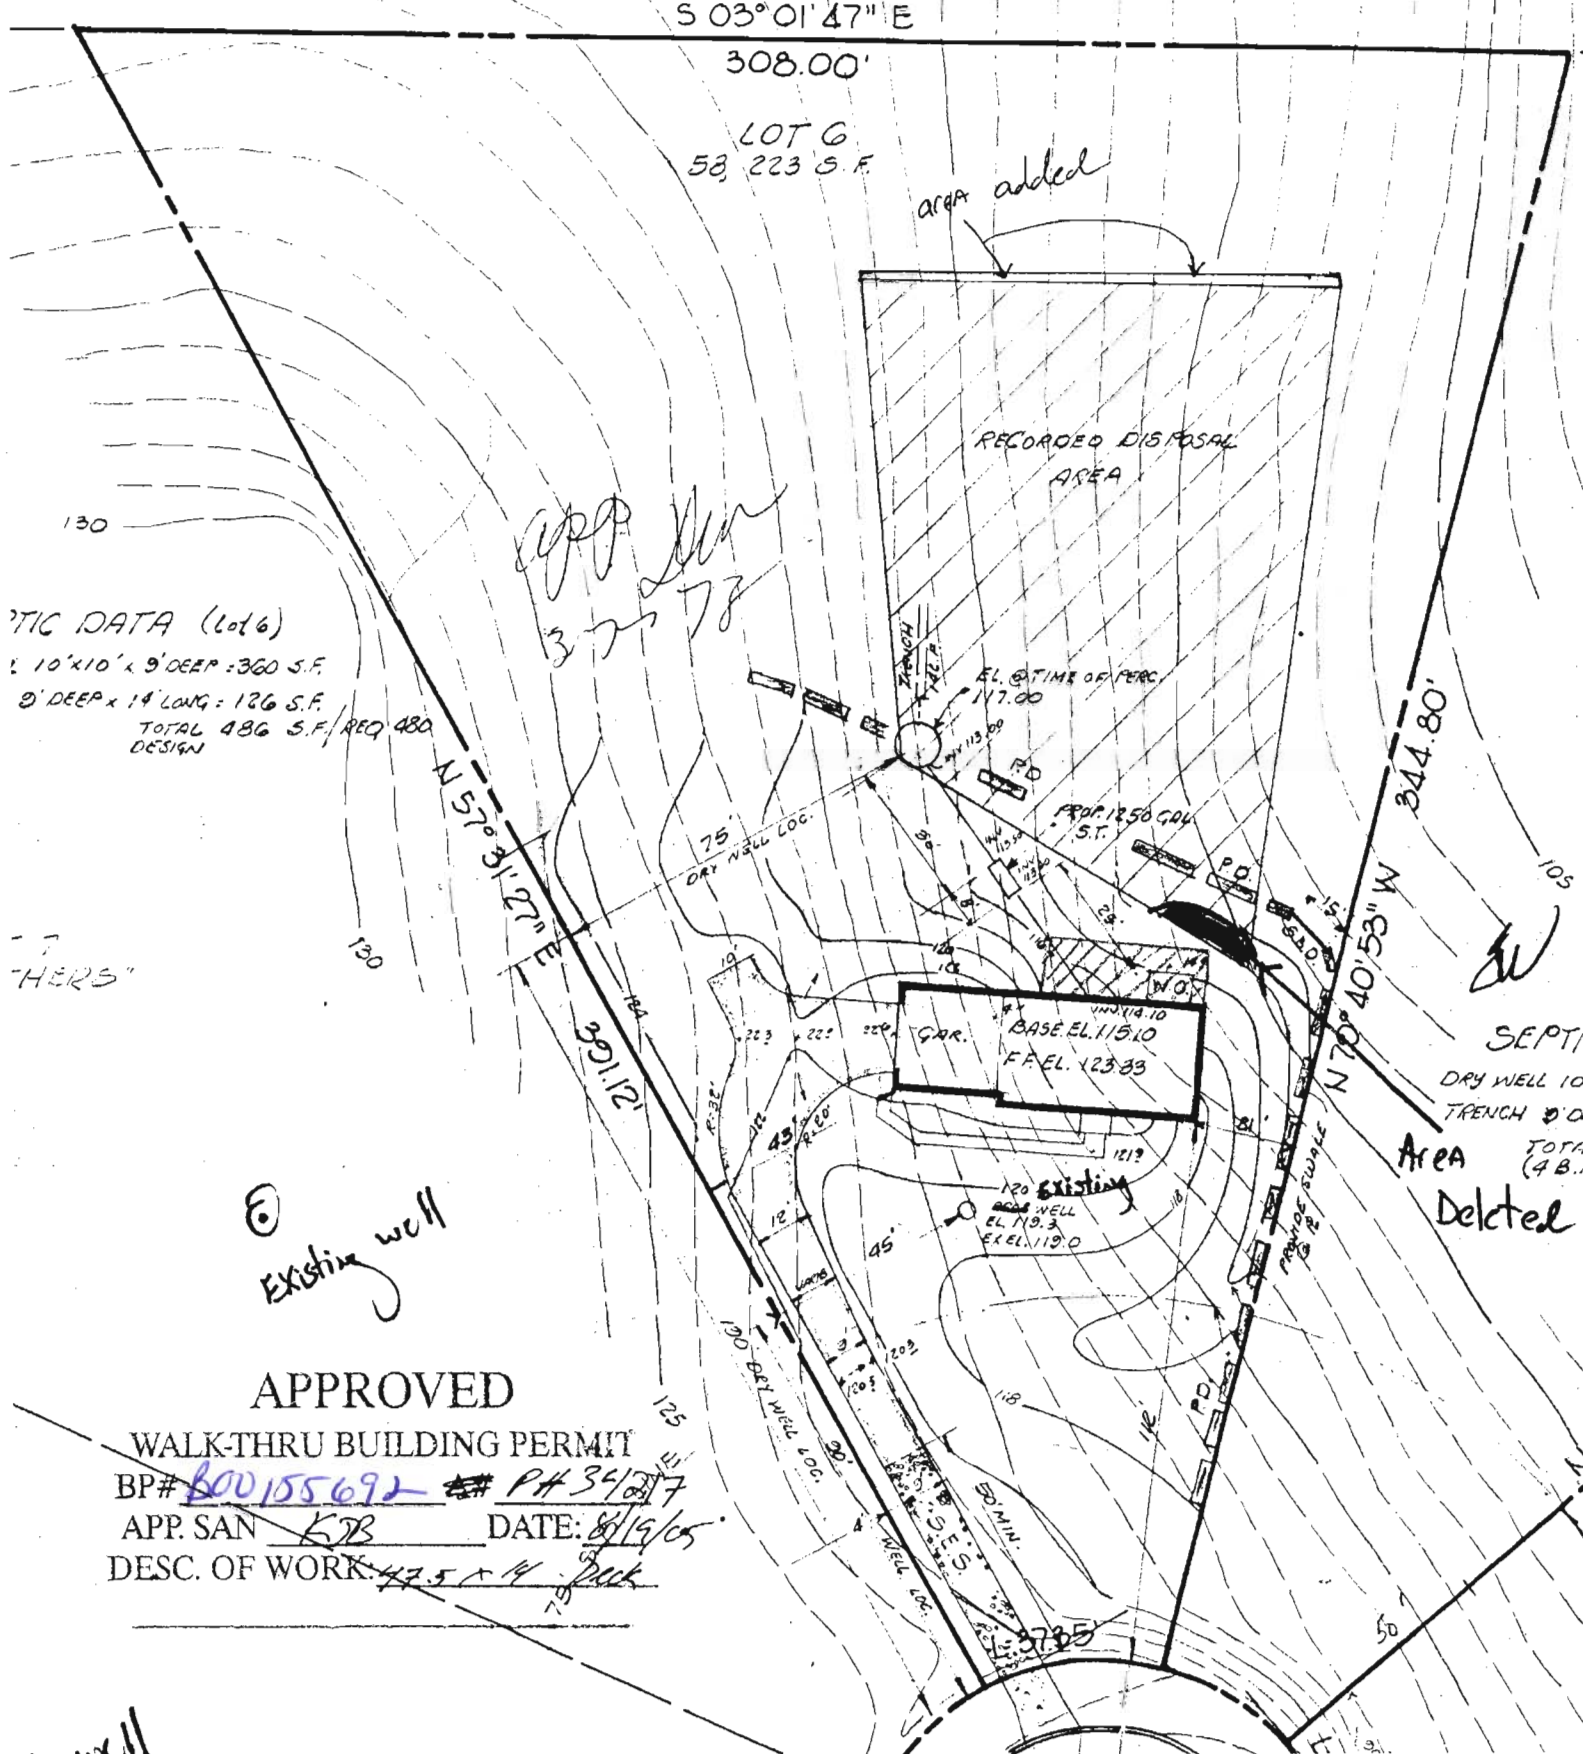

SEPTIC  
 DRY WELL 10  
 TRENCH 2' DIA  
 TOTAL  
 (4 B.A.)  
 Area Deleted

125  
 120  
 115  
 50