

APPLICATION

PERCOLATION TESTING

A _____

P _____

HOWARD COUNTY HEALTH DEPARTMENT
BUREAU OF ENVIRONMENTAL HEALTH
3525-H ELLICOTT MILLS DRIVE/ELLICOTT CITY, MARYLAND 21043
TELEPHONE: 313-2640

DISTRICT _____

DATE _____

TO: THE COUNTY HEALTH OFFICER
ELLICOTT CITY, MARYLAND

I HEREBY APPLY FOR THE NECESSARY TEST PRIOR TO APPLICATION FOR PERMIT TO CONSTRUCT (OR RECONSTRUCT) A SEWAGE DISPOSAL SYSTEM.

PROPERTY OWNER MARSHALL W. NICHOLS

ADDRESS 2937 JENNINGS CHAPEL ROAD
WOODBRINE, MD 21797 PHONE _____

AGENT OR PROSPECTIVE BUYER DAVID E. WILKINSON @ MACRO LTD. REAL ESTATE SERVICES

ADDRESS 5301 BUCKEYSTOWN PIKE, SUITE 300
FREDERICK, MD 21704 PHONE (301) 698-9696

PROPERTY LOCATION:

DIVISION NICHOLS' PROPERTY LOT NO. _____

ROAD AND DESCRIPTION JENNINGS CHAPEL ROAD, HOWARD COUNTY

TAX MAP 13 PARCEL # P/O 46

SIZE OF LOT 40,000 - 60,000 sq. ft. TYPE BLDG. SINGLE FAMILY DWELLING
(SINGLE FAMILY DWELLING OR COMMERCIAL)

THE SYSTEM INSTALLED UNDER THIS APPLICATION IS ACCEPTABLE ONLY UNTIL PUBLIC FACILITIES BECOME AVAILABLE. I FULLY UNDERSTAND THE FEE CONNECTED WITH THE FILING OF THIS PERC TEST APPLICATION IS NON-REFUNDABLE UNDER ANY CIRCUMSTANCES. I ALSO AGREE TO COMPLY WITH ALL M.O.S.H.A. REQUIREMENTS IN TESTING THIS LOT. [Signature]
(SIGNATURE OF APPLICANT)

APPROVED BY _____ FOR _____ DATE _____

DISAPPROVED BY _____ FOR _____ DATE _____

HOLD PENDING FURTHER TESTS _____


REASONS FOR REJECTION OR HOLDING _____

PERCOLATION TEST PLAT/PRELIMINARY PLAT - TITLE OR I.D. # _____ DATE _____


SITE DEVELOPMENT PLAN/FINAL PLAT - TITLE OR I.D. # _____ DATE _____

THIS IS NOT A PERMIT


SOIL PROFILE 15 D

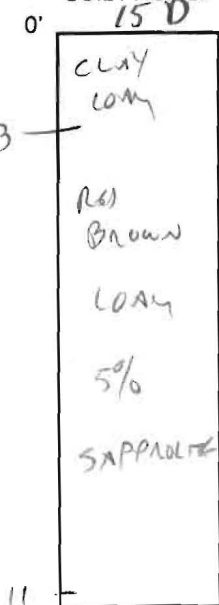


15A/14C

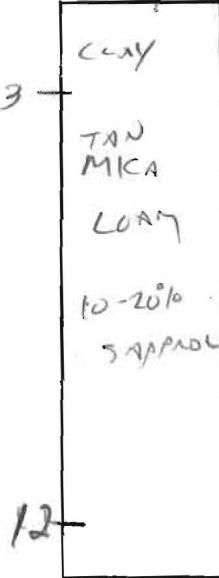



15B/16A

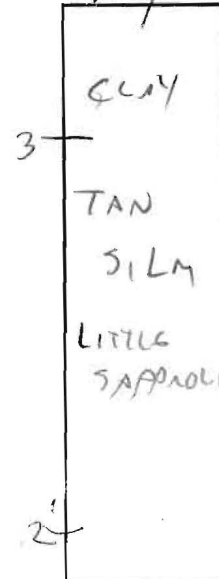

SOIL PROFILE 14 B

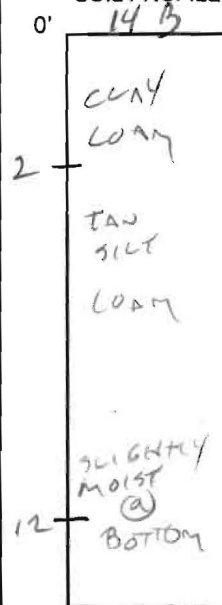

16 B

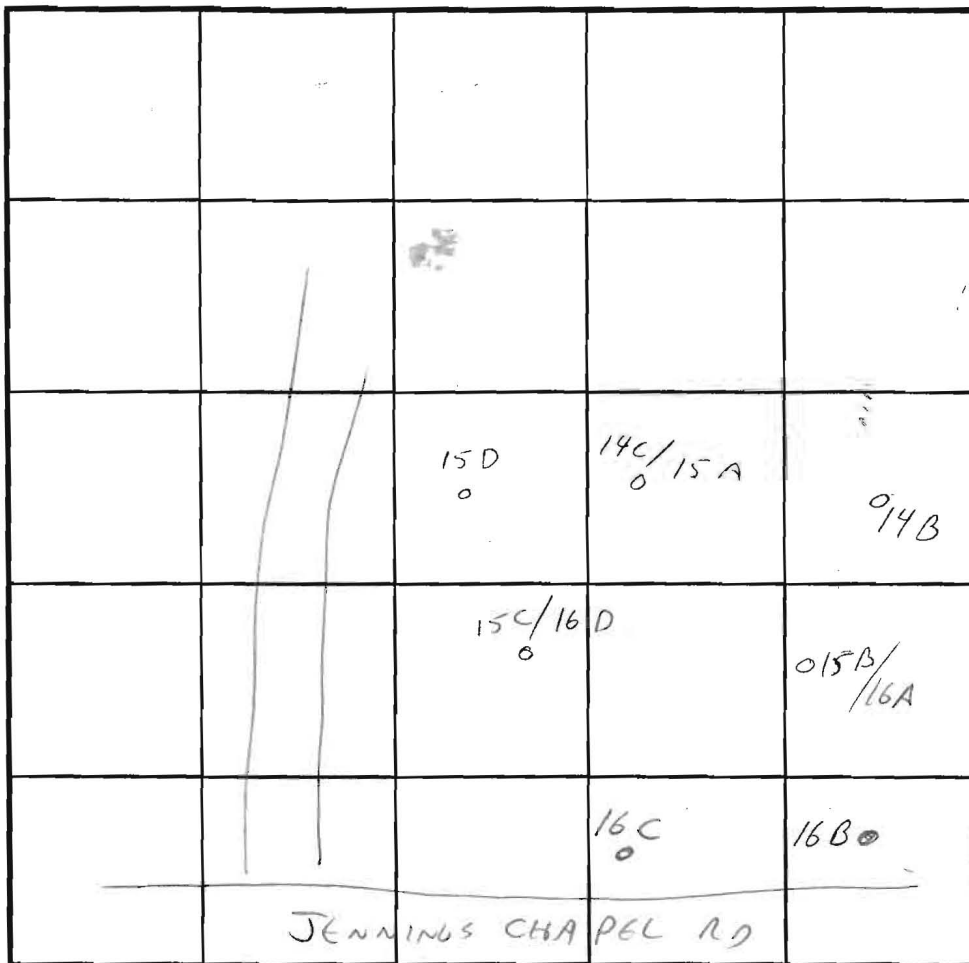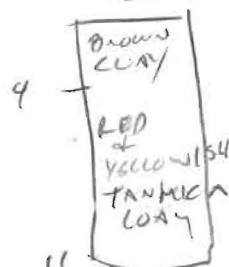

INDICATE NORTH - NAME ADJOINING ROADWAY AS BASE LINE.

DATE	TEST NO.	DEPTH	PRE-WET		TEST - 1" DROP		TIME
			START	STOP	START	STOP	
4/15/98	15D	3 1/2	12:36	12:39	12:39	12:45	6 MIN
	15A/14C	3 1/2	VIS OK	3 1/2 - 12'			EST 6 MIN
	15B/16A	3 1/2	12:48	1:03	1:03	1:35	
			SLOW @ 3 1/2 -	VIS OK -	EST 5 MIN	@ 4 1/2'	(5 MIN)
	14 B	3 1/2	12:48	12:58	12:58	1:11	13 MIN
	16 B	3 1/2	12:54	1:00	1:00	1:12	12 MIN

REMARKS _____


TYPE OF SOIL _____

TESTED BY C. Willia ALSO PRESENT SHARP

TRENCH DESIGN DATA: AVERAGE PERCOLATION TIME _____ TRENCH WIDTH _____

INLET DEPTH _____ MAXIMUM BOTTOM DEPTH _____ SQ. FT./BEDROOM _____

Approved
Perc Cert
11-10-98

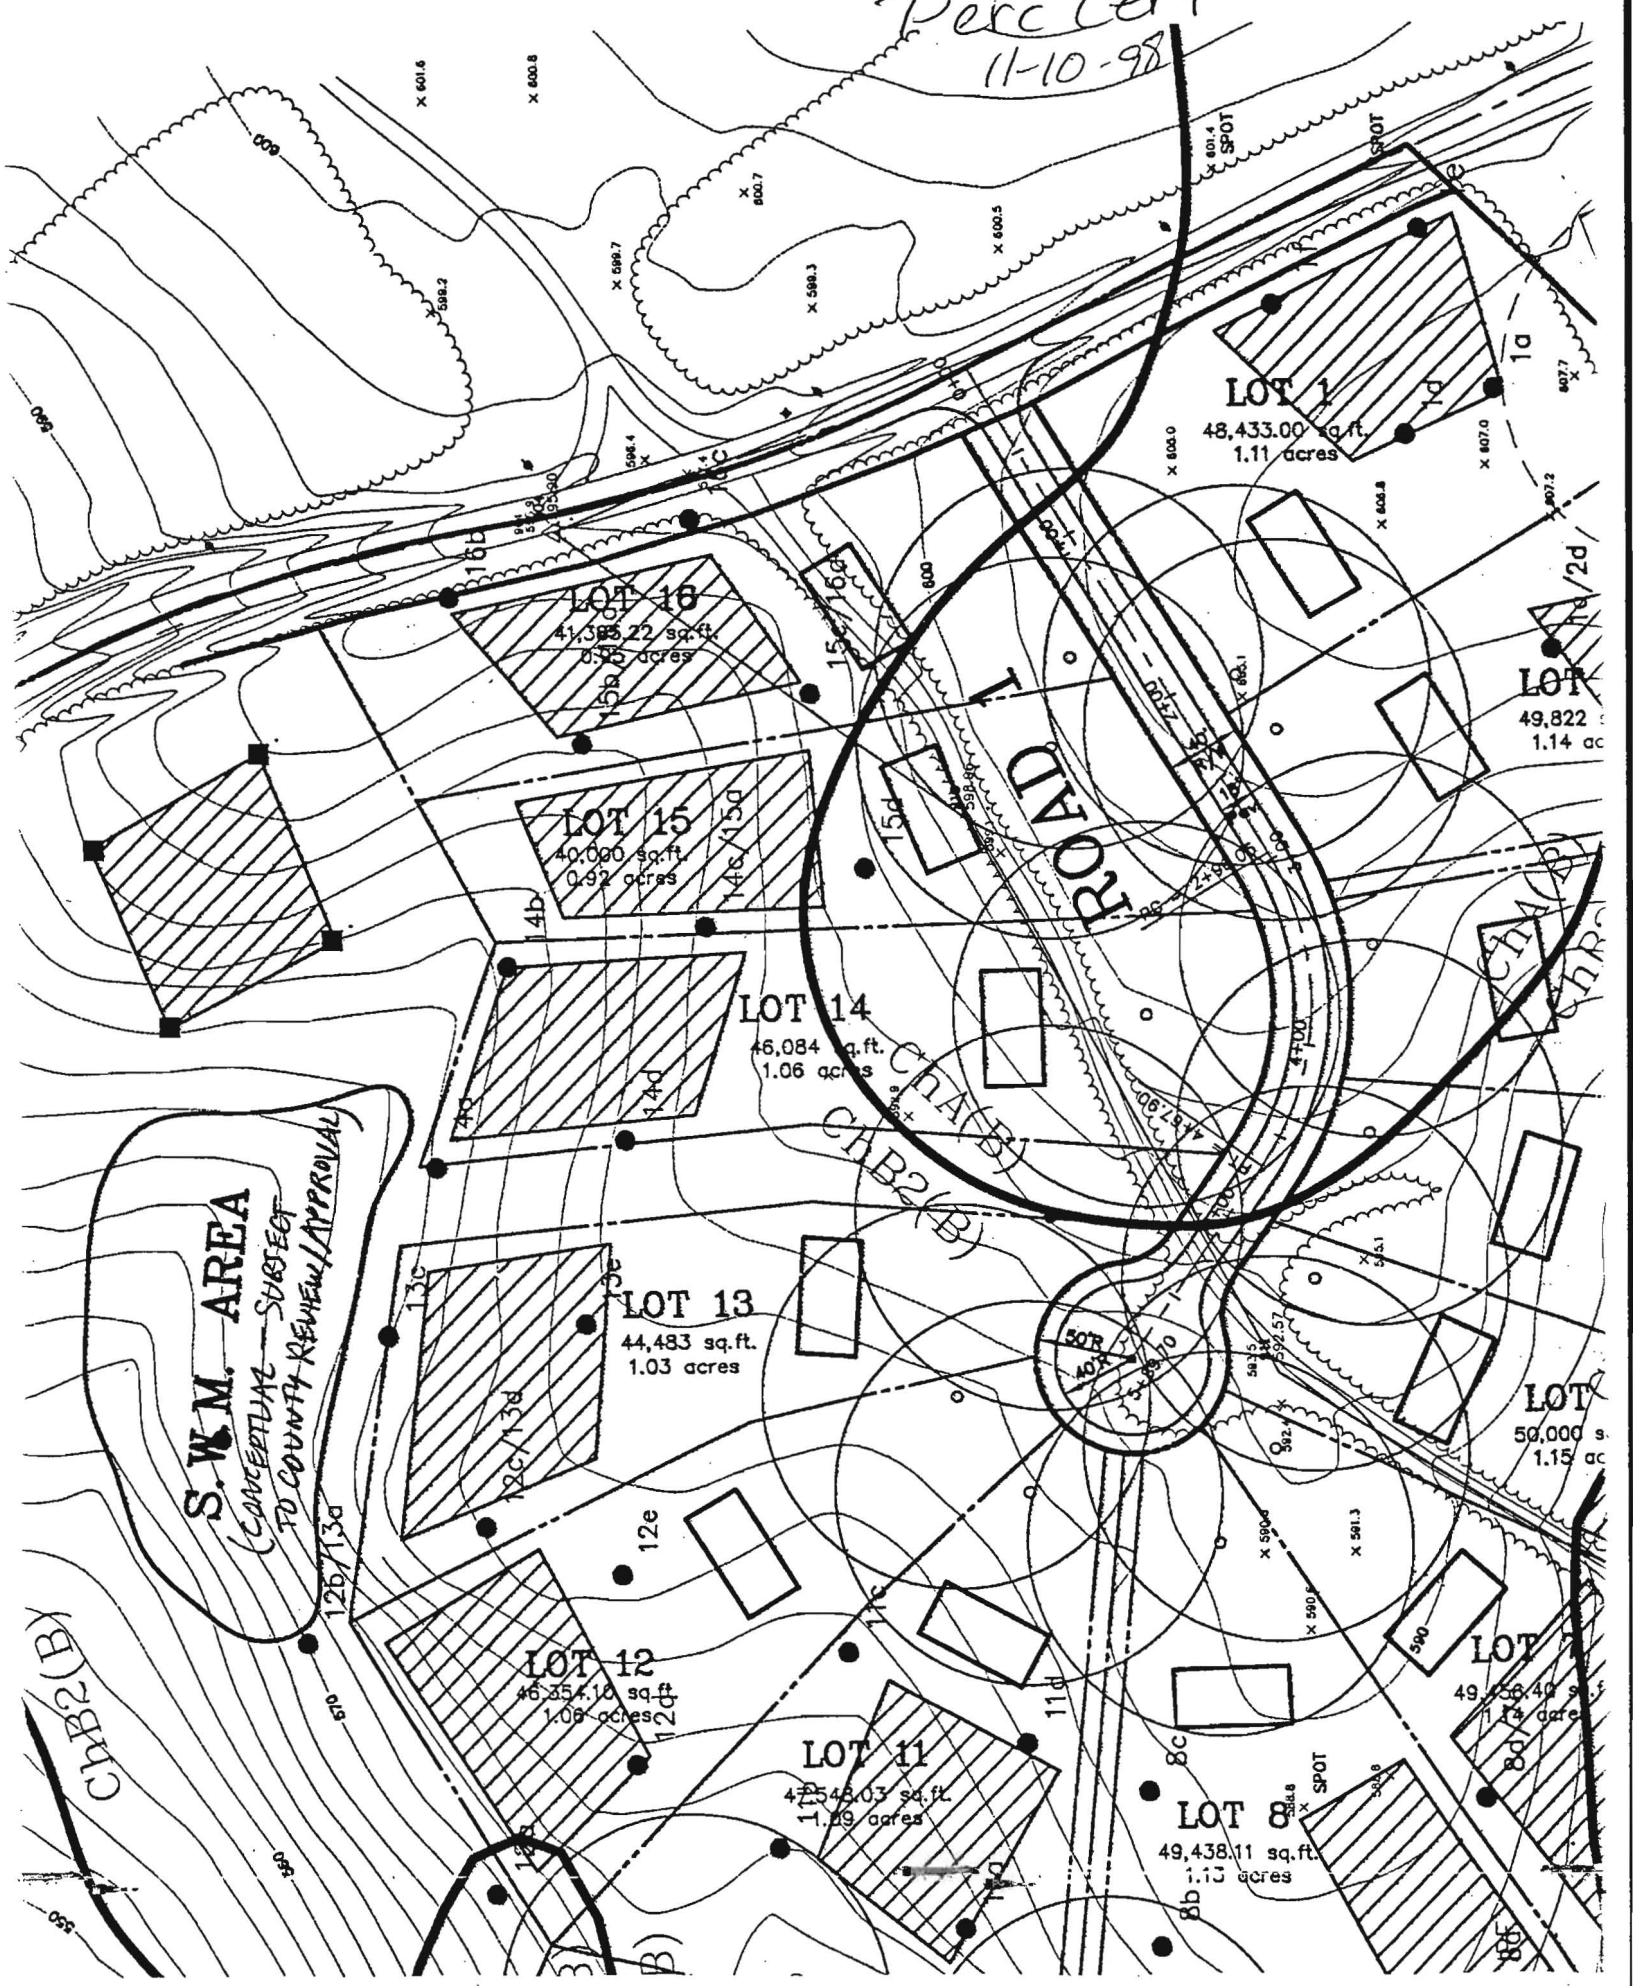

LOT 1
48,433.00 sq. ft.
1.11 acres

LOT 16
41,385.22 sq. ft.
0.95 acres

LOT 15
40,000 sq. ft.
0.92 acres

LOT 14
46,084 sq. ft.
1.06 acres

LOT 13
44,483 sq. ft.
1.03 acres

LOT 12
46,854.10 sq. ft.
1.08 acres

LOT 11
47,548.03 sq. ft.
1.09 acres

LOT 8
49,438.11 sq. ft.
1.13 acres

LOT
49,822
1.14 ac

LOT
50,000 s
1.15 ac

LOT
49,564.40 s
1.14 ac

S.W.M. AREA
(CONCEPTUAL - SUBJECT
TO COUNTY REVIEW/APPROVAL)

CHR2(B)

FRONT RD

