



On Hold  
Locations  
of  
well  
& septic tank  
Approved 10/28/15  
per Plot Plan Revision

DEPARTMENT OF INSPECTIONS, LICENSES & PERMITS

DECK ATTACHMENT AFFIDAVIT OF COMPLIANCE

Building Permit Serial Number: \_\_\_\_\_

To: The Building Official of Howard County, Maryland

I, Edward Pacylowski, the undersigned, am the owner, builder, deck contractor, or owner's agent of the dwelling located at: 3840 Ivory RD, Glenelg, MD, 21737

I understand and accept the responsibility for compliance with the Howard County Deck Attachment Guide procedure related to the construction and attachment of decks to existing dwellings.

FOR ALL NEW DECK CONSTRUCTION ONE OF THE FOLLOWING MUST BE CHECKED:

- YES  The dwelling has a conventional, solid sawn 2x\_\_ lumber floor framing system (including rim joist). The new or replacement deck will be attached directly to this conventional 2x\_\_ lumber rim joist. By checking this response, I understand that the deck may be attached using any of the deck attachment methods indicated on the Howard County Deck Attachment Guide) and agree to use one of these methods.
- NO \_\_\_\_\_ The dwelling does not have a conventional, solid sawn 2x\_\_ lumber floor framing system (including rim joist). By checking this response, I understand that only deck attachment method #2 (ledger supported by additional structural support, lagged into house foundation wall) or #3 (independent beam & column system) may be used, as indicated on the Howard County Deck Attachment Guide, and I agree to use one of these two methods.
- NO \_\_\_\_\_ I do not know whether the dwelling has a conventional, solid sawn 2x\_\_ lumber floor framing system (including rim joist). By checking this response, I understand that only deck attachment method #2 (ledger supported by additional structural support, lagged into house foundation wall) or #3 (independent beam & column system) may be used, as indicated on the Howard County Deck Attachment Guide, and I agree to use one of these two methods.

I solemnly affirm under the penalties of perjury and upon personal knowledge that the contents of the foregoing paper are true.

Signature: [Signature]  
(Owner, Owner's Agent, Builder, Deck Contractor)

Date: September 10, 2015

Print Name: Edward Pacylowski

Address: 13330 Clarksville Pike,  
Highland, MD 20777

White: Department      Yellow: Inspector      Pink: Owner

T:\Updated Forms\deck attachment affidavit of compliance.wpd - June 2008

Post-Net brand fax transmittal memo 7671 # of pages >

From: *Attu Deming*

To: *STEVE*

Company: *FINE FURNITURE*

Dept:

Phone: *301-497-0719*

Fax: *301-497-0700*

Phone: *301-593-5376*

Fax: *301-593-5376*

*B15003850 #3840 Ivory Road*

**APPROVED**



WALK-THRU BUILDING PERMIT

DATE: *10/21/94*

BP# *BP5-9743*

APP. SAN *Labels*

DESC. OF WORK *Deck*

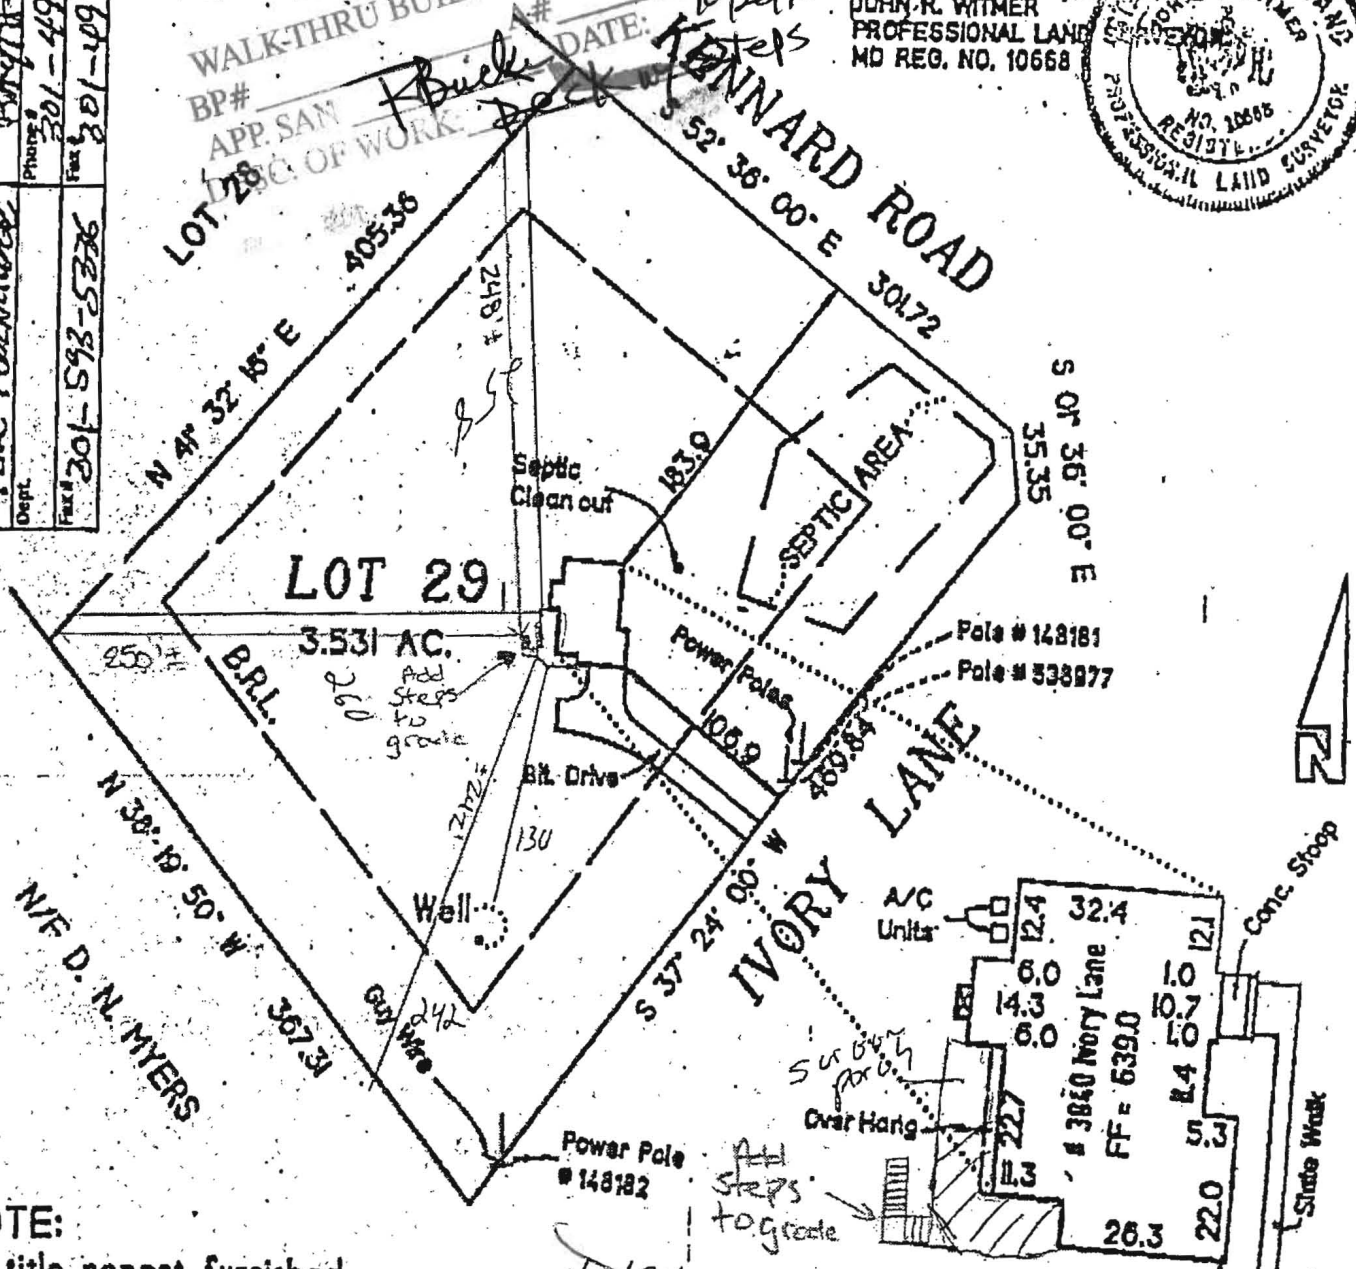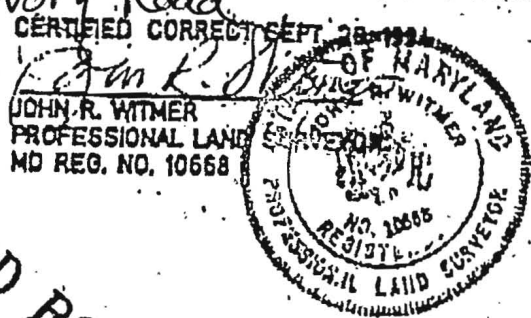

**NOTE:**  
No title report furnished.

**SURVEYOR'S CERTIFICATE**

I hereby certify that the property indicated hereon is shown in accordance with the Subdivision Plat recorded as Plat 8442; that the improvements have been located by acceptable field survey practices and that all visible improvements are shown. The existence of property corner markers is not guaranteed by this plat. This lot is not located in a 100 year flood hazard area.

July 23, 1993

*John R. Witmer*

*1/31/94*

*BP5-9743*

*- deck and screened porch*

*- Proposed addition location will have no impact to existing well and septic - OK to proceed - well, septic location show correctly on plan*

*Amy M. Mellan*

**HOUSE INSET**  
Scale 1"=30'

**HOUSE LOCATION PLAT**  
LOT 29

**CRYSTAL CLEAR**  
HOWARD COUNTY, MARYLAND  
SCALE 1"=40' JULY, 1993

**LANE/WITMER ASSOCIATES**