

APPLICATION

A 14817

SEWAGE DISPOSAL TESTING

P _____

MARYLAND STATE DEPARTMENT OF HEALTH

HOWARD COUNTY

ELLICOTT CITY

DISTRICT 4

DATE 9/17/69

TO: THE COUNTY HEALTH OFFICER
ELLICOTT CITY, MARYLAND

I, HEREBY, APPLY FOR THE NECESSARY TESTS IN ORDER TO CONSTRUCT (OR RECONSTRUCT) A SEWAGE DISPOSAL SYSTEM.

PROPERTY OWNER Maple Hill Farms Associates

ADDRESS 9300 Fontana Ave., Seabrook, Md. 20801 PHONE Any questions call:
Mr. Silbermann
243-2584

PROPERTY LOCATION:

SUBDIVISION 931 LOT NO. 46, Sec. 1

ROAD AND DESCRIPTION Corner of Shady Lane & Street B

OCCUPANT _____ PHONE _____

PERSON TO CONSTRUCT SYSTEM _____

ADDRESS _____ PHONE _____

SIZE OF LOT 160' x 268' x 150' x 270' TYPE BLDG. 3 or 4
NUMBER OF BEDROOMS

IF NOT SINGLE RESIDENCE DESCRIBE _____

SIGNATURE OF APPLICANT /s/ MacClintock & Huster

APPROVED BY _____ FOR _____ DATE _____
(KIND OF SYSTEM)

REJECTED BY _____ FOR _____ DATE _____
(KIND OF SYSTEM)


HOLD PENDING FURTHER TESTS DATE _____

REASONS FOR REJECTION OR HOLDING _____

THIS IS NOT A PERMIT

18
3/4
54

VEGET.

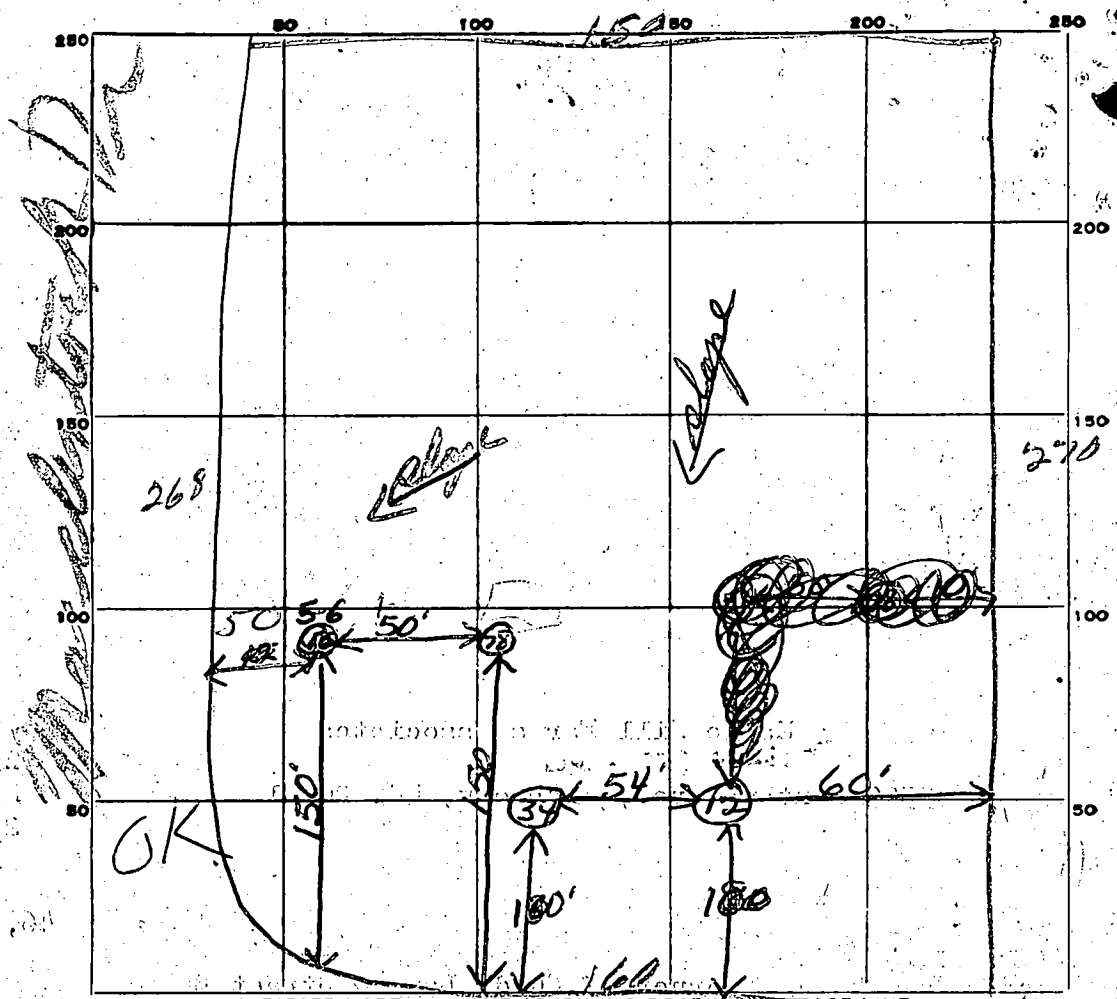

160
114
54

Shadey Lane

DATE	TEST NO.	DEPTH	PRE-WET		TEST - 1" DROP		TIME	
			START	STOP	START	STOP		
9/25/69	1	14'	150					
	2	7'	150					
	3		Slow Perc					
	4							
12/2/69	5	11 1/2'	322	329	329	331	2 min	
	6	6'	322	328	328	332	5 min	
	7	10'	324	335	335	339	4 min	
	8	5'	322	335	335	338	3 min	

47
46
12
14 min
4 min
4 min

SOIL AUGER FINDING

12/2/69
TESTED BY JTS

REMARKS: *need new hole system to be installed before house is built JTS*