

# PERMIT

SEWAGE DISPOSAL SYSTEM

MARYLAND STATE DEPARTMENT OF HEALTH

HOWARD COUNTY

ELLICOTT CITY

## INDEXED

DISTRICT 4th

DATE 1/3/73

*App - 2-14-73*  
*DRS*

17849

14817

*2/14/73*

*2/26/73 - Check progress.*

Thompson Plumbing and Heating

IS PERMITTED TO INSTALL  ALTER

ADDRESS Ellicott City, Maryland

PHONE 465-0881

A SEWAGE DISPOSAL SYSTEM LOCATED AT \_\_\_\_\_

SUBDIVISION Warfield Estates

ROAD Shady Lane & MacClintock

LOT 12A, Sec. 4

PROPERTY OWNER Halle Enterprises

ADDRESS 9332 Annapolis Road, Lanham, Md.

SPECIFICATIONS 4 bedrooms

DRAIN FIELD \_\_\_\_\_ DEPTH \_\_\_\_\_ FEET, BOTTOM AREA \_\_\_\_\_ SQ. FT.

SEEPAGE PITS \_\_\_\_\_ ABSORBENT SIDE-WALL AREA \_\_\_\_\_ SQ. FT.

SEPTIC TANK CAPACITY 1250 GALLONS

FOR GARBAGE GRINDER, INCREASE DISPOSAL AREA 22% & TANK CAPACITY 50%.

OTHER DRY WELL # - 400 sq. ft. sidewall area below the inlet. Dry well inlet to be no deeper than 4 ft. and dry well bottom to be no deeper than 11 ft. Place the dry well ~~100~~ ft. from the lot line which runs along MacClintock Drive and 150 ft. from the lot line which runs along Shady Lane. System must be installed before house is built.

NOTE: ALL PIPE FROM HOUSE TO SEPTIC TANK MUST BE CAST IRON.

PERMIT VOID AFTER THREE YEARS.

NOTE: INSTALL STAND PIPE ON SEPTIC TANK AND DRY WELL.

PLANS APPROVED BY Raymond Hodges


DATE 10/7/71

FILL SEPTIC TANK AND DISTRIBUTION BOX WITH WATER BEFORE CALLING FOR AN INSPECTION. COVER NO WORK UNTIL INSPECTED AND APPROVED.

NEITHER THE HOWARD COUNTY COMMISSIONERS NOR THE HEALTH DEPARTMENT IS RESPONSIBLE FOR THE SUCCESSFUL OPERATION OF ANY SYSTEM.

*Handwritten calculations:*  
42.5  
31/125  
42.5  
25  
51/125  
10  
25  
42  
4  
176

*Vertical stamp:* A 14817

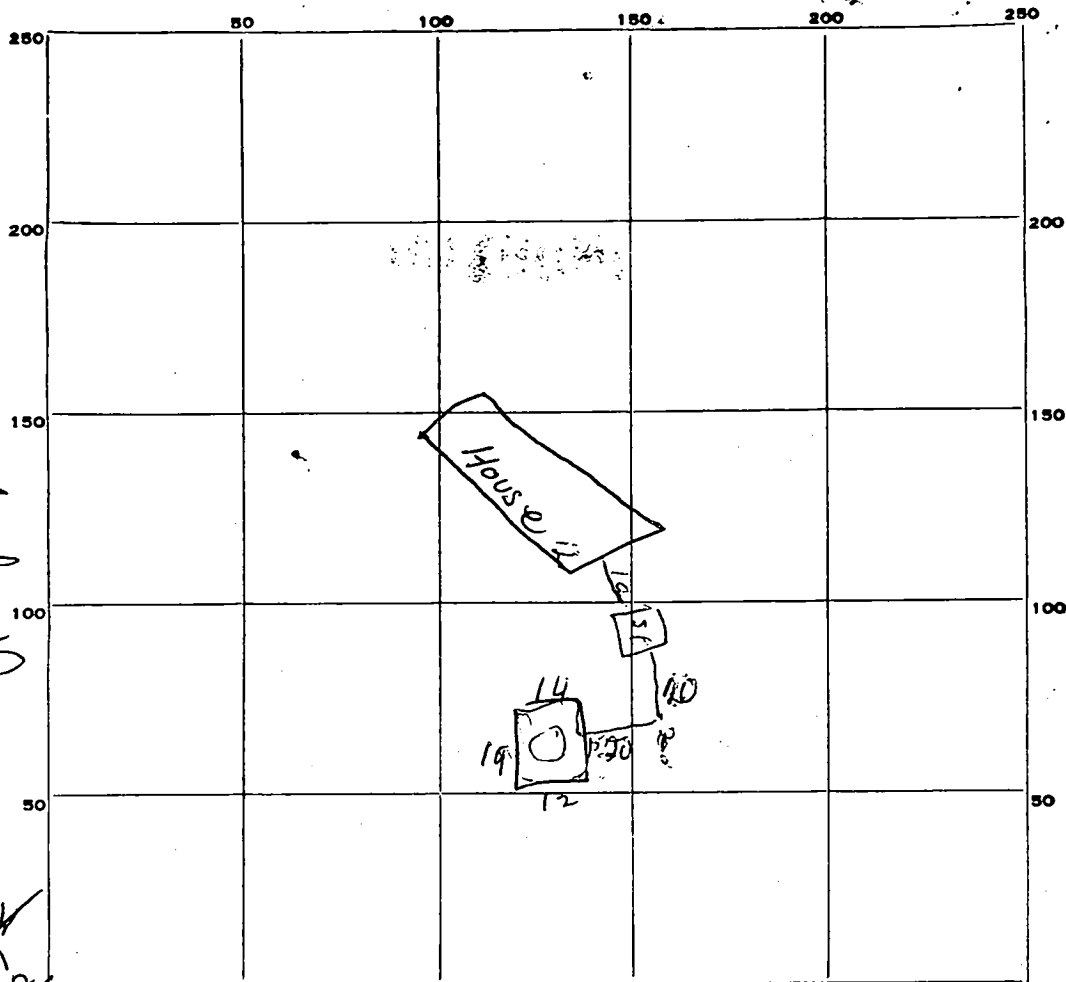

*McClinton Dr*

*32  
24  
22  
14  
12  
10  
8  
6  
4  
2  
1*

*Shady Lane*

PERMIT CARD OK

SEPTIC TANK, LEVEL OK CLEANOUTS OK

DISTRIBUTION BOX, LEVEL \_\_\_\_\_

TILE FIELD, DEPTH \_\_\_\_\_ FT. TRENCH WIDTH \_\_\_\_\_ FT.

GRAVEL DEPTH \_\_\_\_\_ IN. TOTAL LENGTH \_\_\_\_\_ FT.

NUMBER OF TRENCHES \_\_\_\_\_ TOTAL BOTTOM AREA \_\_\_\_\_

SEEPAGE PITS, INSIDE DIAMETER 62 1/2" FT. DEPTH BELOW INLET 6 1/2' FT.

ABSORBENT AREA 403 SQ. FT.

REMARKS *Dug area - 83' from McClinton*

*wrong location* *121' from Shady La* *install in area specified*

*Dug wall lid 4*

*1/26/73 - Dug well being relocated plumber will call next week R/H*

DATE SYSTEM APPROVED 2-14-73 INSPECTOR D.W. Manag lion