

10/29/96

# PERMIT

## SEWAGE DISPOSAL SYSTEM

### DEPARTMENT OF HEALTH AND MENTAL HYGIENE

HOWARD COUNTY HEALTH DEPARTMENT  
BUREAU OF ENVIRONMENTAL HEALTH  
~~XXXXXXXX~~ 313-2640

INDEXED

PAID BY CHECK # 1644  
ON 10/29/96

P 57371-B

A REPAIR

DISTRICT 4th

DATE 10-29-96

DATE SYSTEM APPROVED 10/29/96

INSPECTOR *[Signature]*

Hatfield Equipment & Dedication Service, Inc. IS PERMITTED TO INSTALL  ALTER  X

ADDRESS 13785 Burntwoods Road, Glenelg, Maryland 21737 PHONE 854-6172

SUBDIVISION Warfield Estates LOT 12A ROAD 14502 MacClintock Drive

PROPERTY OWNER Mrs. Dorothy Schultz

ADDRESS 14502 MacClintock Drive  
Glenwood, Maryland 21738

SEPTIC TANK CAPACITY 1250 GALLONS

NUMBER OF BEDROOMS 4

125 SQUARE FEET PER BEDROOM

LINEAR FEET OF TRENCH REQUIRED 100' (2x50')

**BUILDING PERMIT SIGNED  
AND RETURNED**

9-9-03 800143655 - BADELM

TRENCH LENGTH 65'

REPAIR - PURPOSE - Septic System Has Failed. - DRYWELL HAS COLLAPSED.  
Call for inspection when ground is opened so sanitarian can recommend repair.  
10/28/96

LOCATION - SEE DIST. BOX 20' off TANK, RUN TRENCHES TOWARDS MACCLINTOCK DRIVE

INLET 4', BOTTOM AT 9', 5' STONE BELOW DIST PIPE

PLANS APPROVED BY GS DATE 10/29/96

COVER NO WORK UNTIL INSPECTED AND APPROVED

NEITHER THE HOWARD COUNTY COUNCIL NOR THE HEALTH DEPARTMENT IS RESPONSIBLE FOR THE SUCCESSFUL OPERATION OF ANY SYSTEM

NOTE: CLEANOUT REQUIRED EVERY 70 FEET OF SEWER LINE AND/OR AT 90° SWEEPS IN LINES FROM HOUSE TO DRAIN FIELDS, 90° ELBOWS NOT ACCEPTABLE.

NOTE: ALL PARTS OF SEPTIC SYSTEMS (I.E. TANK, DISTRIBUTION BOX TRENCHES) TO BE 100 FEET FROM WELL (UNLESS OTHERWISE SPECIFICALLY AUTHORIZED)

NOTE: IF DEEP TRENCH(ES) ARE USED CALL FOR INSPECTION BEFORE AND AFTER PLACING GRAVEL IN TRENCH(ES)

NOTE: NO DRY WELL SHALL EXCEED 15 FOOT IN DIAMETER NO ABSORPTION TRENCH TO EXCEED 100 FEET IN LENGTH

NOTE: ALL PIPE FROM HOUSE TO SEPTIC TANK MUST BE CAST IRON OR SCHEDULE 35/40 PVC OR ABS


PERMIT VOID AFTER TWO YEARS

NOTE: INSTALL STAND PIPE ON SEPTIC TANK AND DRY WELL STAND PIPES MUST BE 6 INCHES IN DIAMETER CAST IRON. CONCRETE OR TERRA COTTA OR PVA OR ABS ACCEPTED. IF TOP OF SEPTIC TANK IS DEEPER THAN 3 FEET. MANHOLE TO GRADE REQUIRED.

NOTE: DISTRIBUTION BOXES MUST HAVE BAFFLES

**\*INSTALLER IS RESPONSIBLE FOR OBTAINING FINAL APPROVAL ON THIS PERMIT**

P 57371-B

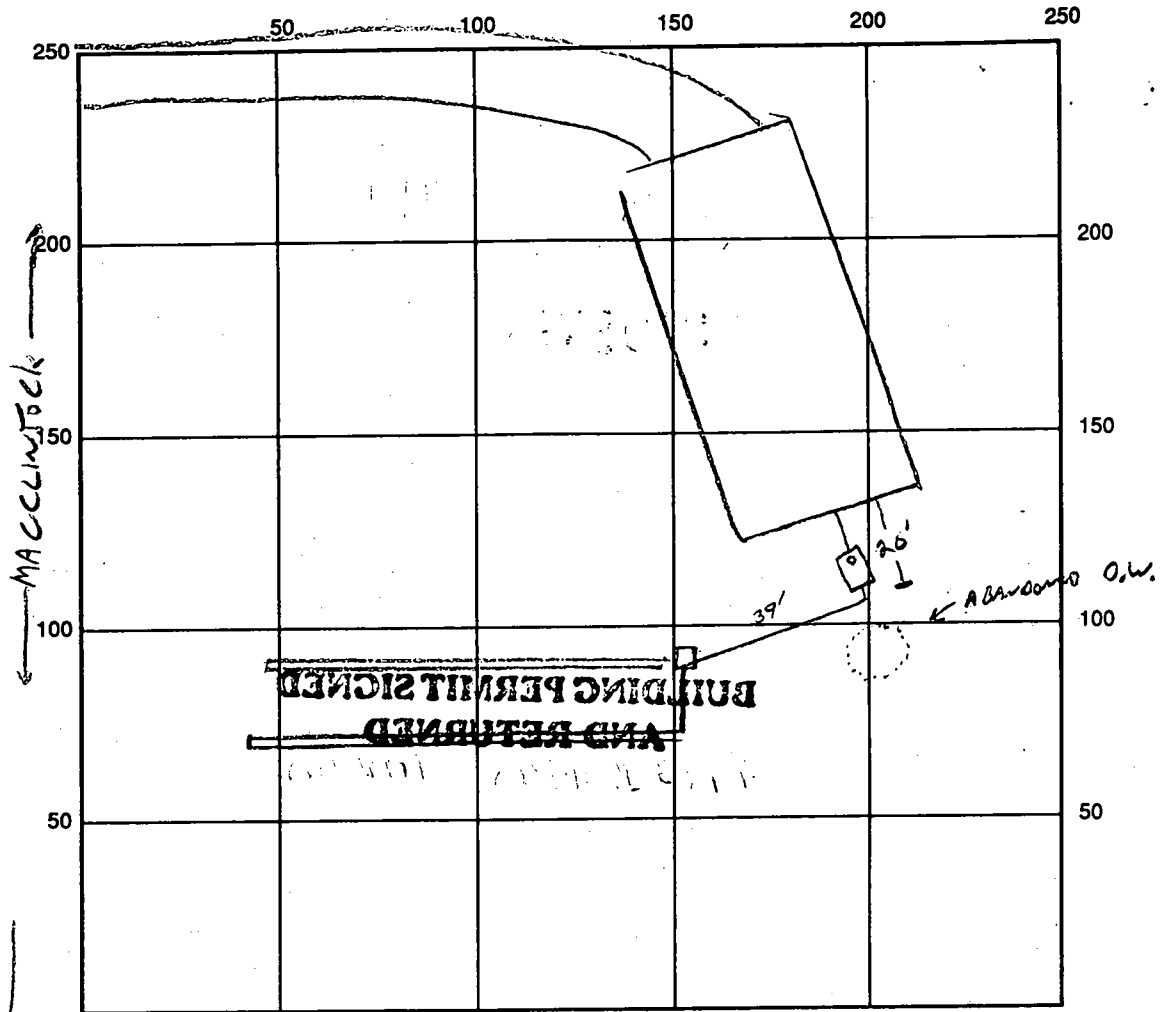

INDICATE NORTH - NAME ADJOINING ROADWAY AS BASE LINE

SHADY LANE

N →

SEPTIC TANK LEVEL NA CLEANOUTS on tank

DISTRIBUTION BOX LEVEL OK, BASELINE

DRAIN FIELD/TITLE DEPTH 9 FT. TRENCH WIDTH 2 FT. INLET DEPTH 3 FT.

EFFECTIVE GRAVEL DEPTH +5 FT. TOTAL LENGTH 1/2  
48/57 FT.

NUMBER OF TRENCHES 2 ONE SIDEWALL/BOTTOM AREA 525 SQ. FT.

DRYWALL INSIDE DIAMETER — FT. EFFECTIVE DEPTH BELOW INLET — FT.

ABSORBENT AREA — SQ. FT.

- ok to 13

REMARKS: 10/29/96 TEST HOLE DUG IN CENTER OF YARD @ MACCLINTOCK X  
SHADY LANE, EXISTING DRYWELL COLLAPSED WHEN PUMPED - ABANDONED - NEW DIRT  
BOX SET. 10/29 1ST TRENCH OK TO STONE, LEAVE ENDS OPEN  
2ND TRENCH OK, OK TO COVER. ALL WORK OK TO COVER

DATE SYSTEM APPROVED 10/29/96

INSPECTOR [Signature]