

01635 SEQUENCE NO. (DWR USE ONLY)

3 (SEQ. NO.) 6

(THIS NUMBER IS TO BE PUNCHED IN COLS. 3-6 ON ALL CARDS)

STATE OF MARYLAND
DEPARTMENT OF WATER RESOURCES
STATE OFFICE BLDG., ANNAPOLIS, MARYLAND 21401
WELL COMPLETION REPORT

THIS REPORT MUST BE SUBMITTED WITHIN 30 DAYS AFTER WELL COMPLETION

FILL IN THIS FORM COMPLETELY

COUNTY NUMBER

DATE RECEIVED (DWR USE ONLY) Feb 20 73

DEPTH OF WELL 150 (TO NEAREST FOOT)

PERMIT NO. FROM "PERMIT TO DRILL WELL" 40-1EP-0133

DATE WELL COMPLETED

DRILLERS IDENTIFICATION NO. 72

OWNER A. Wallis Enterprises

STREET OR RFD 9332 Annapoles Rd

POST OFFICE Rankom, Md.

WELL LOG

STATE THE KIND OF FORMATIONS PENETRATED, THEIR COLOR, DEPTH, THICKNESS AND IF WATER BEARING

DESCRIPTION (USE ADDITIONAL SHEETS IF NECESSARY)	FEET		CHECK IF WATER BEARING
	FROM	TO	
rock	0	24	
sandstone	24	50	
granite	50	150	

WELL DESCRIPTION

GROUTING RECORD

WELL HAS BEEN GROUTED (CIRCLE APPROPRIATE BOX) Y N

TYPE OF GROUTING MATERIAL (CIRCLE BOX)

CEMENT CM BENTONITE CLAY BC

NO. OF BAGS 6 NO. OF POUNDS 600

GALLONS OF WATER 36

DEPTH OF GROUT SEAL (TO NEAREST FOOT)

FROM 0 FT. TO 24 FT. (ENTER 0 IF FROM SURFACE)

CASING RECORD

INSERT APPROPRIATE CODE BELOW

STEEL ST CONCRETE CO

PLASTIC PL OTHER OT

MAIN CASING TYPE S +

NOMINAL DIAMETER TOP (MAIN) CASING (NEAREST INCH) 6

TOTAL DEPTH OF MAIN CASING (NEAREST FOOT) 30

OTHER CASING (IF USED)

DIAMETER (INCH) DEPTH (FEET) FROM TO

SCREEN RECORD

INSERT APPROPRIATE CODE BELOW

STEEL ST BRASS OR BRONZE BR OPEN HOLE HO

PLASTIC PL OTHER OT

SCREEN TYPE OR OPEN HOLE

DEPTH (NEAREST WHOLE FOOT)

FROM TO

1 2 3 (SEQ. NO.) 6

1 8 9 11 15 17 21

2 23 24 26 30 32 36

3 38 39 41 45 47 51

PUMPING TEST

HOURS PUMPED (TO NEAREST HOUR) 9

PUMPING RATE (GALLONS PER MINUTE TO NEAREST GALLON) 20

METHOD USED TO MEASURE PUMPING RATE bucket

WATER LEVEL: (DISTANCE FROM LAND SURFACE)

BEFORE PUMPING 30 (NEAREST FOOT)

WHEN PUMPING 150 (NEAREST FOOT)

TYPE OF PUMPED USED (CIRCLE APPROPRIATE BOX) (FOR PUMPING TEST)

AIR PISTON TURBINE

CENTRIFUGAL ROTARY OTHER (DESCRIBE BELOW)

JET SUBMERSIBLE

PUMP INSTALLED

TYPE OF PUMP (WRITE APPROPRIATE LETTER IN BOX - SEE ABOVE: A, C, J, P, R, S, T, O)

DRILLER WILL INSTALL PUMP (CIRCLE APPROPRIATE BOX) Y N

CAPACITY:

GALLONS PER MINUTE (TO NEAREST GALLON) 31 35

PUMP HORSE POWER 37 41

PUMP COLUMN LENGTH (NEAREST FOOT) 43 47


CASING HEIGHT (CIRCLE APPROPRIATE BOX AND ENTER CASING HEIGHT)

ABOVE } LAND SURFACE (NEAREST FOOT) 2

BELOW } 49 50 51

LOCATION OF WELL ON LOT

SHOW PERMANENT STRUCTURE SUCH AS BUILDINGS, SEPTIC TANKS, AND/OR OTHER LAND MARKS AND INDICATE NOT LESS THAN TWO DISTANCES (MEASUREMENTS TO WELL).

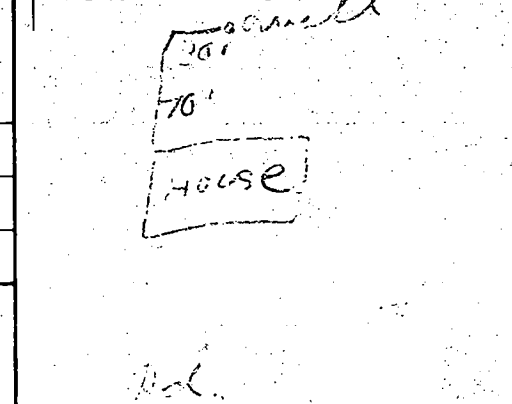

CIRCLE APPROPRIATE BOXES

A WELL WAS ABANDONED AND SEALED WHEN THIS WELL WAS COMPLETED

E ELECTRIC LOG OBTAINED

P TEST WELL CONVERTED TO PRODUCTION WELL

I HEREBY CERTIFY THAT I HAVE COMPLIED WITH ALL CONDITIONS STATED ON THE ABOVE-CAPTIONED "PERMIT TO DRILL WELL", AND THAT INFORMATION CONTAINED IN THIS REPORT IS TRUE, ACCURATE, AND COMPLETE TO THE BEST OF MY KNOWLEDGE, INFORMATION AND BELIEF.

DRILLERS NAME K. F. Eastwood

(PLEASE PRINT) K. F. Eastwood

SIGNATURE K. F. Eastwood

DIAMETER OF SCREEN 56 60 (NEAREST INCH)

GRAVEL PACK

IF WELL DRILLED WAS A FLOWING WELL CIRCLE BOX 68 F

DWR USE ONLY (NOT TO BE FILLED IN BY DRILLER)

TELESCOPE CASING T 70

LOG INDICATOR L 72

OTHER DATA AVAILABLE W 74 Q 75 76

WELL ABANDONMENT REPORT

Date: 12-6-91

PERMIT NUMBER OF ABANDONED WELL (if any)

H 0 - 7 3 - 0 1 2 3

DRILLER'S NAME

Easterday, Frankie Jr.
LAST FIRST

OWNER'S NAME

Shultz, Pattie
LAST FIRST

WELL LOCATION:

COUNTY: Howard

SUBDIVISION: Warfield Estates

SECTION: _____ LOT: 11/12

NEAREST TOWN: Glenwood

ADDRESS: 14502 MacClintock Dr.

MARYLAND GRID LOCATION:

E	<u>792</u>
N	<u>526</u>

	X 0/5	5/5
	0/0	5/0

SHOW WELL LOCATION BY (X) WITHIN BOX

TYPE OF WELL

- DRILLED
- JETTED
- BORED OR AUGERED
- OTHER, SPECIFY

DEPTH OF WELL _____ FT.

TYPE OF CASING

- STEEL
- PLASTIC
- CONCRETE
- OTHER, SPECIFY

SIZE OF CASING 6 IN.

WAS ANY CASING REMOVED YES NO

IF YES, AMOUNT REMOVED 3 FT.

WAS CASING RIPPED OR PERFORATED YES NO

LOG OF SEALING MATERIAL

MATERIAL	FEET	
	FROM	TO
Gravel	160	20
Cement	20	3
Dirt	3	0

DRILLER

Frankie Easterday Jr.
SIGNATURE

LICENSE#

269