

APPLICATION

A 12245

P _____

SEWAGE DISPOSAL TESTING

MARYLAND STATE DEPARTMENT OF HEALTH

HOWARD COUNTY

ELLICOTT CITY

*Building permit issued prior to purchase of 10/18/66
Capacity below slab and outside of Tank inside*
1500 gal. 16" dia. Tank must be cement DATE 10/14/66
parged, ~~in~~ properly installed and ~~made~~ properly installed

*Constant blocks. Construction specifications annexed at bottom of appl.
Two dry wells each 12 ft. in dia. by 11 ft. deep below the
inlets both located 38 ft. from south building wall to dry well
centers. One dry well center located in direct line of South
building wall and second dry well 36 ft. to right of first dry
well as measured along the edge of foundation
Type 3 to 4 ft below original grade.*

TO: THE COUNTY HEALTH OFFICER
ELLICOTT CITY, MARYLAND

I, HEREBY, APPLY FOR THE NECESSARY TESTS IN ORDER TO CONSTRUCT (OR RECONSTRUCT) A SEWAGE DISPOSAL SYSTEM.

PROPERTY OWNER Chesapeake Conference of Seventh Day Adventists

ADDRESS 5110 Frederick Rd., Balto. 29, Md. PHONE 644-7620

PROPERTY LOCATION:

SUBDIVISION _____ LOT NO. _____

ROAD AND DESCRIPTION Route # 29, Simpsonville

OCCUPANT _____ PHONE _____

PERSON TO CONSTRUCT SYSTEM _____

ADDRESS _____ PHONE _____

SIZE OF LOT 6 acres TYPE BLDG. 18 rooms Commercial
NUMBER OF BEDROOMS _____

IF NOT SINGLE RESIDENCE DESCRIBE _____

SIGNATURE OF APPLICANT *Frank H. Jones*


APPROVED BY *J. J. Hennigan* FOR Dry Well DATE 10-18-66
(KIND OF SYSTEM)

REJECTED BY _____ FOR _____ DATE _____
(KIND OF SYSTEM)

HOLD PENDING FURTHER TESTS _____ DATE _____

REASONS FOR REJECTION OR HOLDING _____

THIS IS NOT A PERMIT

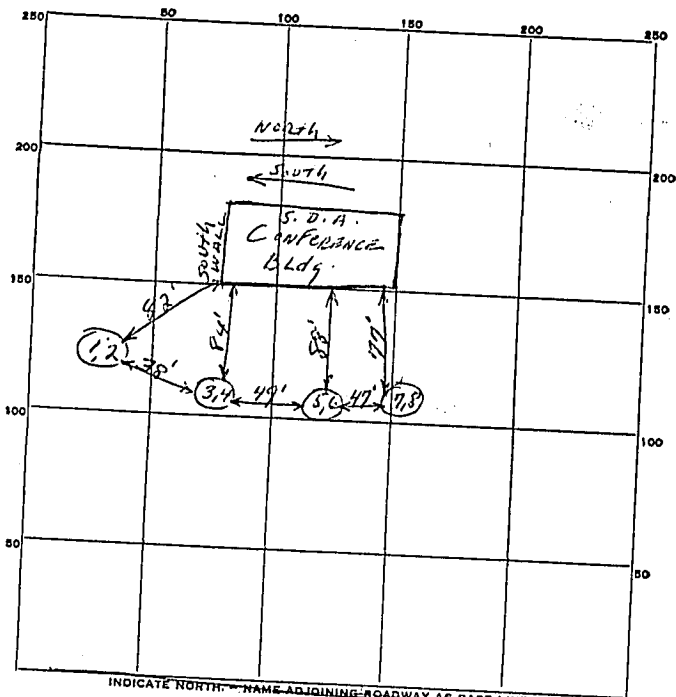

INDICATE NORTH - NAME ADJOINING ROADWAY AS BASE LINE.

RT. 29

137
36

DATE	TEST NO.	DEPTH	PRE-WET		TEST - 1" DROP		TIME
			START	STOP	START	STOP	
10-18-66	1) Same	10	10:42	overtime	10:50	10:52	
	2) Pit	5	10:49	10:50	10:50	10:52	2 min
	3) Same	11'	10:58	11:01	11:01	11:05	4 1/2 min
	4) Pit	4 1/2'	11:05	11:08	11:08	11:13	5 min
	5) Same	12'	11:15	11:24	11:24	11:40	16 min
	6) Pit	4	11:18	11:21	11:21	11:25	4 min
	7) Same	4 1/2'	11:45	11:48	11:48	11:54	6 min
	8) Pit	11'	11:46	11:48	11:48	11:50	2 min

3 FT of fill on top

10-18-66
Frank [Signature]

SOIL AUGER FINDING

Sheet at 3 to 4 FT below original grade
Use pits (3,4) and (5,6)

TESTED BY JH

REMARKS