

*Attn: Kevin*

12107 Mayapple Trail  
Marriottsville, MD 21104  
Phone (410) 442-0000  
Fax (410) 442-5765  
MHIC No. 16414

WAYNE COSENTINO  
President



August 16, 2005

Howard County Department of Finance  
Attn: Avis  
6430 Courthouse Drive  
Ellicott City, MD 21043

Dear Avis:

SUBJECT: PERMIT #B00155201  
Residence of Novak and Verboski  
12100 Mayapple Trail  
Marriottsville, MD 21104

Please note that the 1<sup>st</sup> level addition calling out new bedroom needs to be changed to an office.

Thank you for your cooperation.


Sincerely,

Wayne Cosentino

2005 AUG 16 AM 11:12  
LICENSES AND  
PERMITS DIVISION

8/10/05 + ~~53'~~ 53' of trench

~~Tank size needs to be updated prior to BP release~~

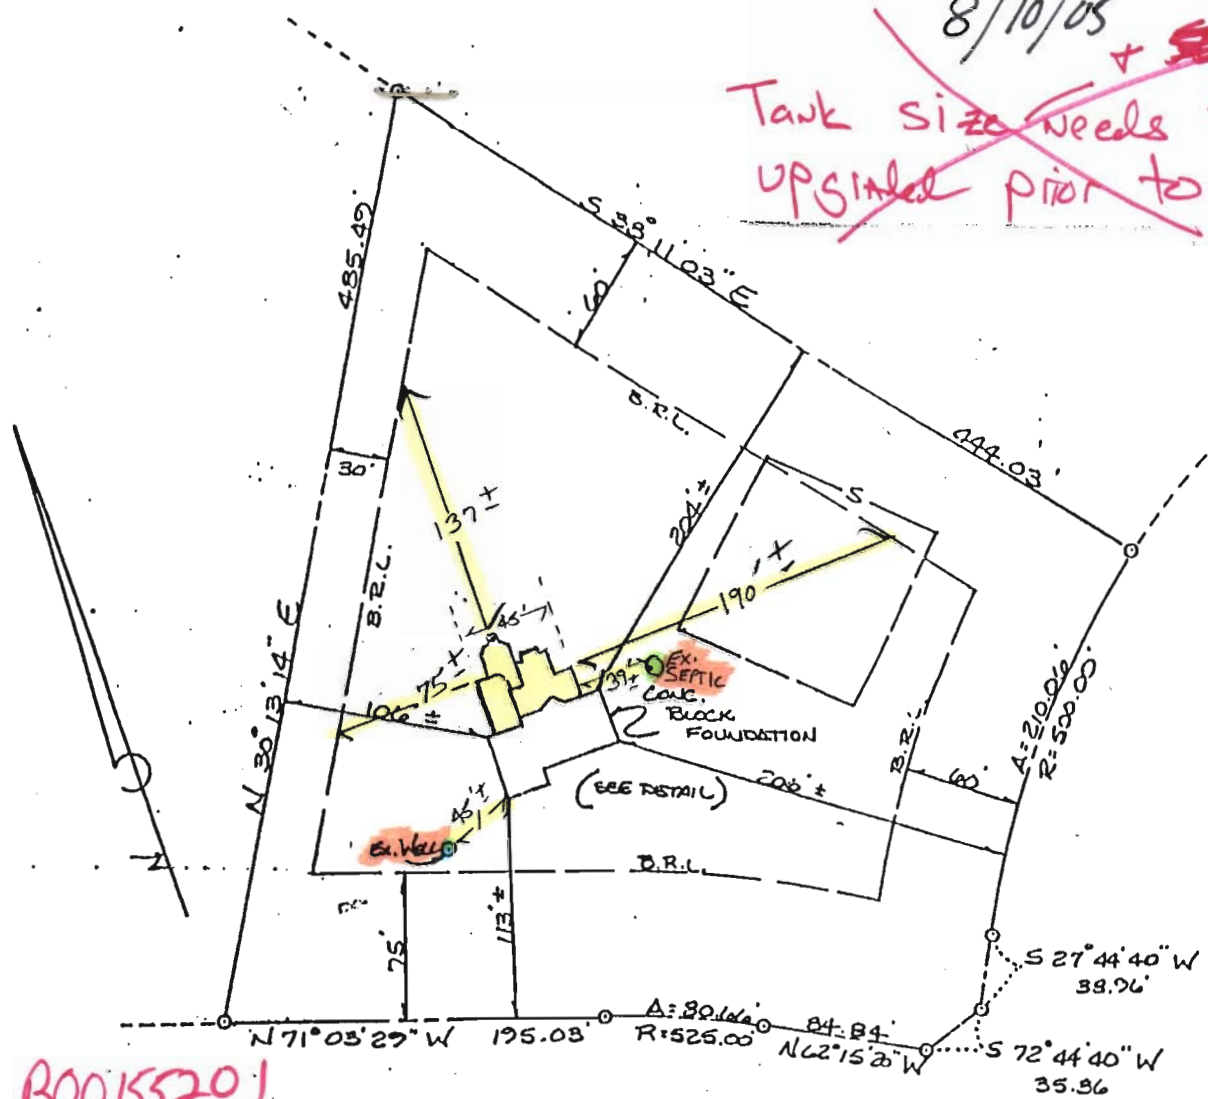

B00155201

8/19/05

add ok  
no new beds. 7303

WALL CHECK SURVEY  
 LOT 15, SECTION ONE  
 MEADOWOOD  
 SITUATED ON MAYAPPLE TRAIL  
 ELECTION DISTRICT N# 3  
 HOWARD COUNTY, MARYLAND  
 SCALE: 1"=100' OCT. 1992



10/6/92

NOTE: FOOTINGS & FOUNDATION ARE IN PLACE.

I CERTIFY THIS PLAT TO BE CORRECT; IT IS THE RESULT OF AN ACTUAL FIELD SURVEY, BASED ON DATA FOUND AMONG THE LAND RECORDS OF HOWARD COUNTY, MARYLAND, AS REFERENCED HEREON.

REFERENCE	JOB NO.
PLAT # 7809	92-50

LIBERTY SURVEY, INC.  
 4140 RIDGE ROAD  
 TAYLORSVILLE, MARYLAND

410-875-0722

21157

K7725

03-312305

P.M. P.C.O.  
Date 10/22 C.B.S.

# PERMIT

*File*

## SEWAGE DISPOSAL SYSTEM

P 48535

A 38123

### DEPARTMENT OF HEALTH AND MENTAL HYGIENE

DISTRICT 1st

DATE 9/24/92

**HOWARD COUNTY HEALTH DEPARTMENT**  
BUREAU OF ENVIRONMENTAL HEALTH  
461-9933

*INDEX - TIME EXPIRED FOR  
F.C.O.P. COMPLIANCE*

DATE SYSTEM APPROVED 10/23/92

**INDEXED**

INSPECTOR C.B.S.

Dave Hopkins

IS PERMITTED TO INSTALL  ALTER

ADDRESS 17550 Old Frederick Road, Mt. Airy, Maryland 21771 PHONE 831-7257

SUBDIVISION Meadowood LOT 15 ROAD 12100 Mayapple Trail

PROPERTY OWNER Mohammond & Sharen Mirzgi

### BUILDING PERMIT SIGNED

ADDRESS \_\_\_\_\_

### AND RETURNED

SEPTIC TANK CAPACITY 1250 GALLONS *8-19-05 B00155201-2 STORY GARAGE*

NUMBER OF BEDROOMS 4

180 SQUARE FEET PER BEDROOM

LINEAR FEET OF TRENCH REQUIRED 144

TRENCHES - Trench to be 2 feet wide. Inlet 3 feet below original grade. Bottom maximum depth 8 feet below original grade. Effective area begins at 3 feet below original grade. 5 feet of stone below distribution pipe.

LOCATION - Place the distribution box 200 feet from the front lot line and 200 feet from right lot line as seen when facing the property from Mayapple Drive. Run trenches along contour toward right side of property. Right side of property is along Meadowood Road.

NOTES - No trench to exceed 100 feet in length. Provide 6" - 8" diameter cleanout and cap to grade or above on septic tank. *dicted*

PLANS APPROVED BY C. Williams/Raymond Hodges REVISED \_\_\_\_\_ DATE 9/11/92

COVER NO WORK UNTIL INSPECTED AND APPROVED

NEITHER THE HOWARD COUNTY COUNCIL NOR THE HEALTH DEPARTMENT IS RESPONSIBLE FOR THE SUCCESSFUL OPERATION OF ANY SYSTEM

NOTE: CLEANOUT REQUIRED EVERY 70 FEET OF SEWER LINE AND/OR AT 90° SWEEPS IN LINES FROM HOUSE TO DRAIN FIELDS, 90° ELBOWS NOT ACCEPTABLE.

NOTE: ALL PARTS OF SEPTIC SYSTEMS (I.E. TANK, DISTRIBUTION BOX TRENCHES) TO BE 100 FEET FROM WELL (UNLESS OTHERWISE SPECIFICALLY AUTHORIZED)

NOTE: IF DEEP TRENCH(ES) ARE USED CALL FOR INSPECTION BEFORE AND AFTER PLACING GRAVEL IN TRENCH(ES)

NOTE: NO DRY WELL SHALL EXCEED 15 FOOT IN DIAMETER NO ABSORPTION TRENCH TO EXCEED 100 FEET IN LENGTH

NOTE: ALL PIPE FROM HOUSE TO SEPTIC TANK MUST BE CAST IRON OR SCHEDULE 35/40 PVC OR ABS

PERMIT VOID AFTER TWO YEARS

NOTE: INSTALL STAND PIPE ON SEPTIC TANK AND DRY WELL STAND PIPES MUST BE 6 INCHES IN DIAMETER CAST IRON, CONCRETE OR TERRA COTTA OR PVA OR ABS ACCEPTED. IF TOP OF SEPTIC TANK IS DEEPER THAN 3 FEET. MANHOLE TO GRADE REQUIRED.

NOTE: DISTRIBUTION BOXES MUST HAVE BAFFLES

**\*INSTALLER IS RESPONSIBLE FOR OBTAINING FINAL APPROVAL ON THIS PERMIT**


A  
38123

(A) PROP. 4 BED. HOUSE  
 FF. ELEV. = 558.6  
 BSMT. ELEV. = 550.1  
 INV. ELEV. = 548.9

(B) PROP. SEPTIC TANK  
 EX. ELEV. = 551.9  
 INV. IN = 548.6  
 INV. OUT = 548.3

(C) PROP. DIET BOX  
 EX. ELEV. = 550.7  
 INV. ELEV. = 548.0

(D) PROP. TRENCHES  
 INV. ELEV. = 547.7  
 2' STONE, 8' BOT. MAX.  
 LENGTH TO BE DETERMINED  
 AT TIME OF SEPTIC PERMIT  
 ISSUANCE.

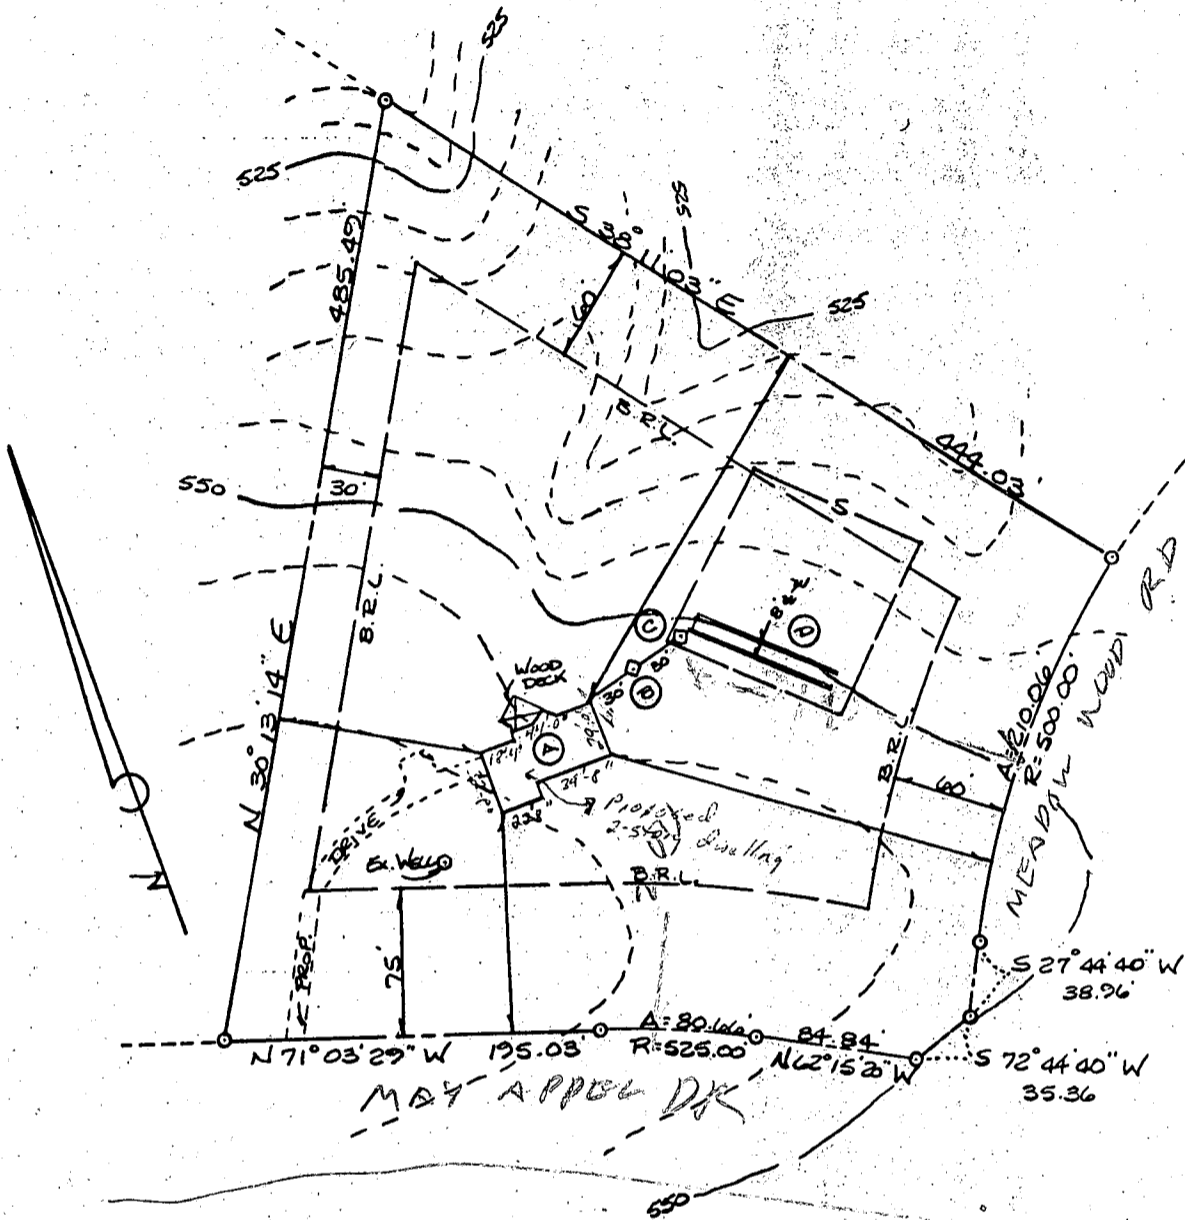

9/11/92  
 PLANS OK

PLAT PLAN BP 45364  
 LOT 15, SECTION ONE  
 MEADOWOOD  
 SITUATED ON MAYAPPLE TRAIL R/Hodger  
 ELECTION DISTRICT No 3  
 HOWARD COUNTY, MARYLAND  
 SCALE: 1" = 100' SEPT. 1992



I CERTIFY THIS PLAT TO BE CORRECT; IT IS THE RESULT OF AN ACTUAL FIELD SURVEY; BASED ON DATA FOUND AMONG THE LAND RECORDS OF HOWARD COUNTY, MARYLAND, AS REFERENCED HEREON.

REFERENCE	JOB NO.
PLAT # 7809	92-50

**LIBERTY SURVEY, INC.**  
 4140 RIDGE ROAD  
 TAYLORSVILLE, MARYLAND  
 410-875-0722 21157

W7725