

APPLICATION

PERCOLATION TESTING

A 35192
P 48441

HOWARD COUNTY HEALTH DEPARTMENT
BUREAU OF ENVIRONMENTAL HEALTH
P.O. BOX 476 ELLICOTT CITY, MARYLAND 21043
TELEPHONE: 461-9933

DISTRICT _____
DATE _____

TO: THE COUNTY HEALTH OFFICER
ELLICOTT CITY, MARYLAND

I, HEREBY, APPLY FOR THE NECESSARY TEST IN ORDER TO CONSTRUCT (OR RECONSTRUCT) A SEWAGE DISPOSAL SYSTEM.

PROPERTY OWNER Arthur L. Titus

ADDRESS 11207 McGee Way PHONE _____

PROSPECTIVE BUYER _____

ADDRESS _____ PHONE _____

PROPERTY LOCATION:

SUBDIVISION Homewood LOT NO. 2 Repair

ROAD AND DESCRIPTION 11207 McGee Way

TAX MAP _____ PARCEL # _____

SIZE OF LOT _____ TYPE BLDG _____
(SINGLE FAMILY DWELLING OR COMMERCIAL)

THE SYSTEM INSTALLED UNDER THIS APPLICATION IS ACCEPTABLE ONLY UNTIL PUBLIC FACILITIES BECOME AVAILABLE. I FULLY UNDERSTAND THE FEE CONNECTED WITH THE FILING OF THIS PERC TEST APPLICATION IS NON-REFUNDABLE UNDER ANY CIRCUMSTANCES. I ALSO AGREE TO COMPLY WITH ALL M.O.S.H.A. REQUIREMENTS IN TESTING THIS LOT.

(SIGNATURE OF APPLICANT)

APPROVED BY _____ FOR _____ DATE _____

REJECTED BY _____ FOR _____ DATE _____

HOLD PENDING FURTHER TESTS _____ DATE _____

REASONS FOR REJECTION OR HOLDING _____

HD-216

THIS IS NOT A PERMIT

(A)
SOIL PROFILE


0-1.5 Dk br si c lm
topsoil - full also

1.5-5.0 Yellow br
si c lm

5.0-7.0 Grey-tan
gravelly
si c lm,
may have
perched
water mottles

7.0-14.0 Brown si
lm, 30%
saprolite
water at
13.0 ft

14.0 Bottom

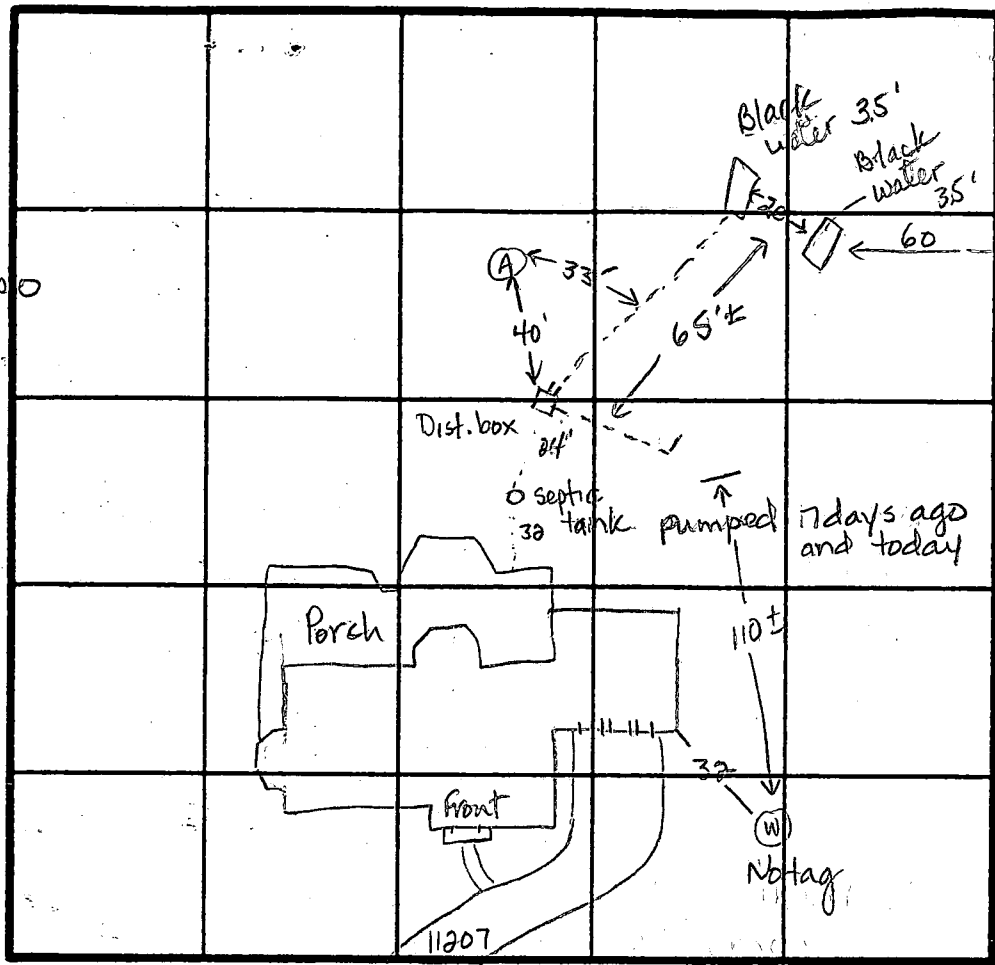

INDICATE NORTH - NAME ADJOINING ROADWAY AS BASE LINE.

McGee Way

DATE	TEST NO.	DEPTH	PRE-WET		TEST - 1" DROP		TIME
			START	STOP	START	STOP	
8-25-92	A	6.5 M	11:26	12:00	34 min	no movement	slow
↓		14.0 D	water at				13.0 ft after 0.5 hr

REMARKS Mail owner copy of existing septic & new repair

TYPE OF SOIL _____

TESTED BY Jane E. Nadeau

ALSO PRESENT C. Williams, P. Schuster
A. Titus - owner