

8/25/92 AM  
8/28/92 AM 2 PM  
8/28/92 11:00

# PERMIT

## SEWAGE DISPOSAL SYSTEM

DEPARTMENT OF HEALTH AND MENTAL HYGIENE

03-310558

HOWARD COUNTY HEALTH DEPARTMENT

BUREAU OF ENVIRONMENTAL HEALTH

461-9933

INDEXED

P 48441  
A35192  
A REPAIR

DISTRICT 3rd

DATE 8/28/92

DATE SYSTEM APPROVED 8/28/92

INSPECTOR CW

Paul Schissler/South Carroll Backhoe, Inc. IS PERMITTED TO INSTALL  ALTER

ADDRESS 4410 Salem Bottom Road, Westminster, Maryland PHONE 875-4197

SUBDIVISION Homewood LOT 2 ROAD 11207 McGee Way

PROPERTY OWNER Art Titus

ADDRESS \_\_\_\_\_

SEPTIC TANK CAPACITY 1250 GALLONS

NUMBER OF BEDROOMS 4

\_\_\_\_\_ SQUARE FEET PER BEDROOM

LINEAR FEET OF TRENCH REQUIRED \_\_\_\_\_

REPAIR - PURPOSE - SEPTIC SYSTEM HAS FAILED.

Call for inspection when ground is opened so sanitarian can recommend repair. 8/27/92

8-25-92 C. Williams / J. Naderu. Keep trenches about 10 feet apart edge to edge. Bottom maximum 5.5 ft, Inlet 2.0 ft if possible, 13-ft wide, approximately 300 linear feet of trench.

PLANS APPROVED BY \_\_\_\_\_ DATE \_\_\_\_\_

COVER NO WORK UNTIL INSPECTED AND APPROVED

NEITHER THE HOWARD COUNTY COUNCIL NOR THE HEALTH DEPARTMENT IS RESPONSIBLE FOR THE SUCCESSFUL OPERATION OF ANY SYSTEM

NOTE: CLEANOUT REQUIRED EVERY 70 FEET OF SEWER LINE AND/OR AT 90° SWEEPS IN LINES FROM HOUSE TO DRAIN FIELDS, 90° ELBOWS NOT ACCEPTABLE.

NOTE: ALL PARTS OF SEPTIC SYSTEMS (I.E. TANK, DISTRIBUTION BOX TRENCHES) TO BE 100 FEET FROM WELL (UNLESS OTHERWISE SPECIFICALLY AUTHORIZED)

NOTE: IF DEEP TRENCH(ES) ARE USED CALL FOR INSPECTION BEFORE AND AFTER PLACING GRAVEL IN TRENCH(ES)

NOTE: NO DRY WELL SHALL EXCEED 15 FOOT IN DIAMETER NO ABSORPTION TRENCH TO EXCEED 100 FEET IN LENGTH

NOTE: ALL PIPE FROM HOUSE TO SEPTIC TANK MUST BE CAST IRON OR SCHEDULE 35/40 PVC OR ABS


PERMIT VOID AFTER TWO YEARS

NOTE: INSTALL STAND PIPE ON SEPTIC TANK AND DRY WELL STAND PIPES MUST BE 6 INCHES IN DIAMETER CAST IRON. CONCRETE OR TERRA COTTA OR PVA OR ABS ACCEPTED. IF TOP OF SEPTIC TANK IS DEEPER THAN 3 FEET. MANHOLE TO GRADE REQUIRED.

NOTE: DISTRIBUTION BOXES MUST HAVE BAFFLES

**\*INSTALLER IS RESPONSIBLE FOR OBTAINING FINAL APPROVAL ON THIS PERMIT**

48441

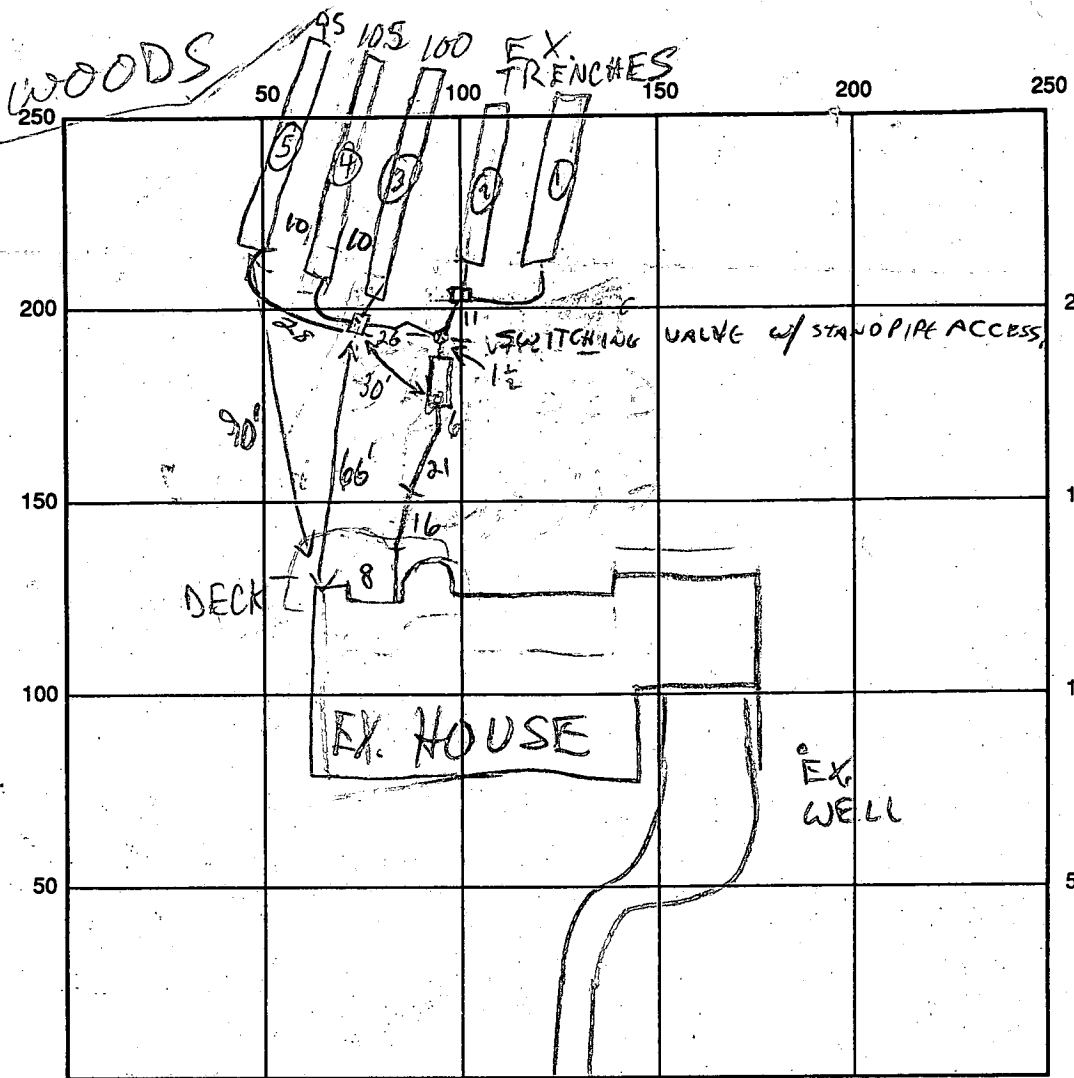

McGEE CT

SEPTIC TANK LEVEL EX OK CLEANOUTS EX OK

DISTRIBUTION BOX LEVEL 2ND D.B.

DRAIN FIELD/TITLE DEPTH  $\frac{3}{5.5} \frac{4}{5.5} \frac{5}{5.5}$  SFT. TRENCH WIDTH 3 FT. INLET DEPTH  $\frac{3}{4} \frac{4}{3} \frac{5}{3}$  FT.

EFFECTIVE GRAVEL DEPTH  $\frac{3}{1.5} \frac{4}{2} \frac{5}{2.5}$  FT. TOTAL LENGTH 3 FT. 100 105 95

NUMBER OF TRENCHES 3 ONE SIDEWALL/BOTTOM AREA 300 315 285 SQ. FT.

DRYWALL INSIDE DIAMETER      FT. EFFECTIVE DEPTH BELOW INLET      FT.

ABSORBENT AREA 900± SQ. FT.

REMARKS: 8/26/92 OK TO CONTINUE MR 8/27/92 MET INSTALLER,  
GAVE OK TO CONTINUE, NO ADD'L WORK MR  
8/27/92 OK TO COVER HOUSE TO S.T.; STILL NEED STANDPIPE  
ON VALVE AND SOME COVER FOR HOUSE SEWER, WHICH IS  
1' ABOVE GRADE FOR 6-8' MR 8/28/92 #1 CONTINUE MR  
SYSTEM COMPLETE - OK TO COVER 8/28/92 CW

DATE SYSTEM APPROVED 8/28/92 INSPECTOR CW