

7-19-85
ASAP + LATER
PM

WPI
7-22-85

7-19-85
Approved
Steel

PERMIT

P 3570P
A 31738

SEWAGE DISPOSAL SYSTEM

MARYLAND STATE DEPARTMENT OF HEALTH*

HOWARD COUNTY
BUREAU OF ENVIRONMENTAL HEALTH
992-2330

05-393078

ELLICOTT CITY
DISTRICT 5th

INDEXED

DATE 6/21/85

C. C. Cissel IS PERMITTED TO INSTALL X ALTER

ADDRESS 14079 Brighton Dam Road, Clarksville, MD 21029 PHONE 854-2006

SUBDIVISION Dunfretten Estates ROAD 13601 Meadow Glen Rd LOT 25

PROPERTY OWNER Robert Harris

ADDRESS _____

IF GARBAGE GRINDER IS USED INCREASE SEPTIC TANK CAPACITY BY 50% AND ABSORPTION AREA BY 22%.

GARBAGE GRINDER? YES _____ NO X

BLDG. PERMIT SIGNED
AND RETURNED 6/21/85
Serial # 14065
Stop Sheet

SEPTIC TANK CAPACITY 1000 GALLONS NUMBER OF BEDROOMS 3

TRENCHES - 158 sq. ft. per bedroom. Trench to be 2 feet wide. Inlet 3 feet below original grade. Bottom maximum depth 7 feet below original grade. Effective area begins at 3 feet below original grade. 4 feet of stone below distribution pipe. LOCATION: Start the trench at point 1 which is located 120 feet from the front lot line and 300 feet from the left side of the lot as seen when facing the lot from Meadow Glen. Run the trench toward the right side of the lot as seen when facing the lot from Meadow Glen. NOTE: No Trench to exceed 100 feet in length. If more than one trench used, a distribution box is required. Trenches to be installed on level ground. Call for inspection of trench(s) before and after gravel is installed. Provide 6" - 8" diameter cleanout and cap to grade or above on septic tank.

WPI 7-22-85
BUILDING PERMIT SIGNED WELL LINE 4.5'-5' below GRADE
AND RETURNED

8/22/85 BD 155017 - GARAGE
12/15/84 - B06008913 - Finish permit

BLDG PERMIT SIGNED
AND RETURNED 7-22-85
Serial # B17 2467
6/28/85

PLANS APPROVED BY Raymond Hodges DATE _____

COVER NO WORK UNTIL INSPECTED AND APPROVED.

NEITHER THE HOWARD COUNTY COUNCIL NOR THE HEALTH DEPARTMENT IS RESPONSIBLE FOR THE SUCCESSFUL OPERATION OF ANY SYSTEM.

NOTE: IF TRENCH IS USED CALL FOR INSPECTION BEFORE AND AFTER PLACING GRAVEL IN TRENCH.

NOTE: NO DRY WELL SHALL EXCEED 15 FOOT IN DIAMETER. NO ABSORPTION TRENCH TO EXCEED 100 FEET IN LENGTH.

NOTE: ALL PIPE FROM HOUSE TO SEPTIC TANK MUST BE CAST IRON OR SCHEDULE 40 PVC OR ABS.

PERMIT VOID AFTER THREE YEARS.

NOTE: INSTALL STAND PIPE ON SEPTIC TANK AND DRY WELL. STAND PIPES MUST BE 6 INCHES IN DIAMETER CAST IRON, CONCRETE OR TERRA COTTA, OR PVC OR ABS ACCEPTED. IF TOP OF SEPTIC TANK IS DEEPER THAN 3 FEET MANHOLE TO GRADE REQUIRED.

FOR DEPOSIT ONLY
HOWARD COUNTY HEALTH DEPARTMENT
10-103316-02


***INSTALLER IS RESPONSIBLE FOR OBTAINING FINAL APPROVAL ON THIS PERMIT**

*CALL 992-2330 FOR INSPECTION OF SEPTIC SYSTEMS.

EH - 2-1082

$$\frac{4 \times 180}{2} \times .36 = 130'$$

A 31738

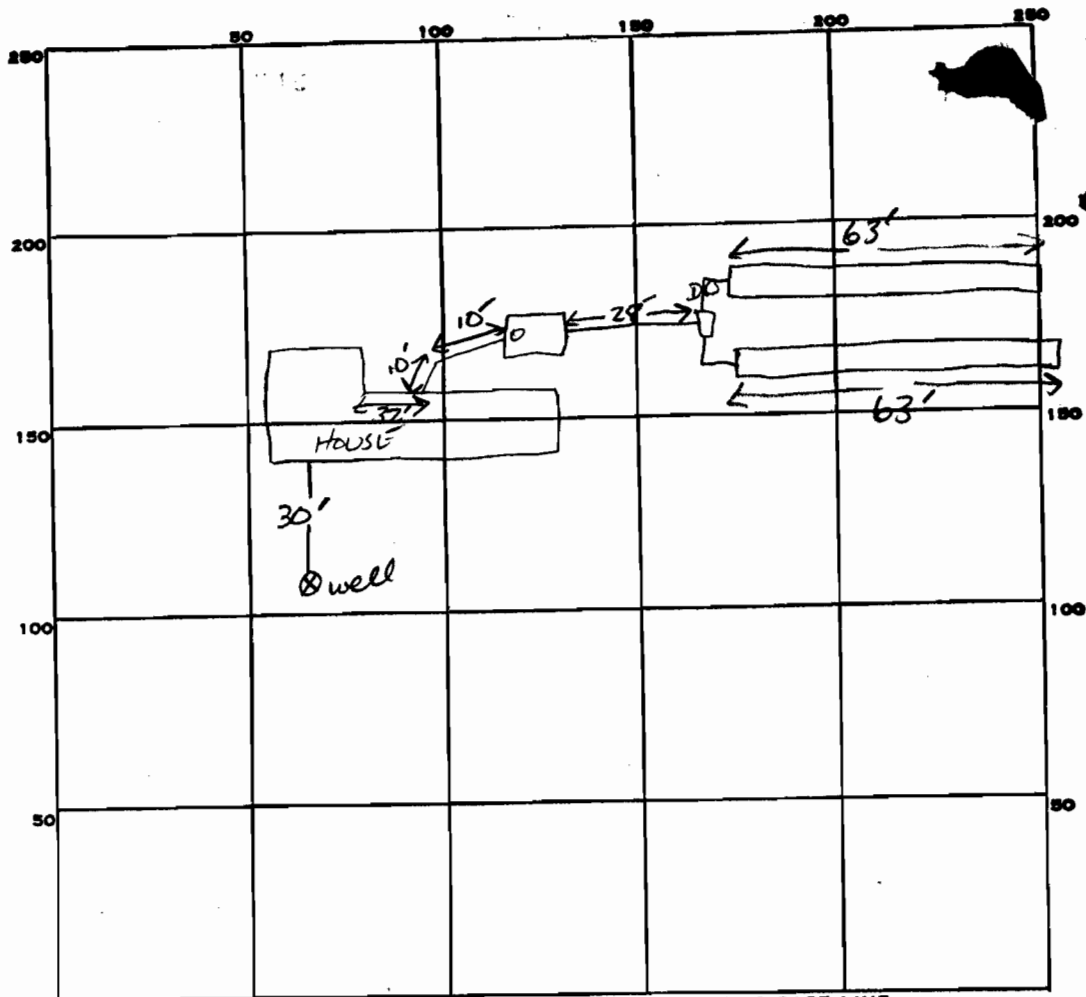

INDICATE NORTH. - NAME ADJOINING ROADWAY AS BASE LINE.
MEADOW GLENN

PERMIT CARD

SEPTIC TANK, LEVEL 1000 GAL

CLEANOUTS

DISTRIBUTION BOX, LEVEL

TILE FIELD, DEPTH 8 FT. TRENCH WIDTH 2 FT.

INLET 3.5"

GRAVEL DEPTH 4.5 FE IN. TOTAL LENGTH 63 63 FT.

① ② TOTAL 126 FT.

NUMBER OF TRENCHES 2 TOTAL BOTTOM AREA 567 SQ. FT.

126
4.5
636
504
567

SEEPAGE PITS, INSIDE DIAMETER _____ FT. DEPTH BELOW INLET _____ FT.

ABSORBENT AREA 567 SQ. FT.

REMARKS 7-19-85 OK TO ADD STONE TO BOTH TRENCHES, NEED HOUSE CONNECTION SA
7-19-85 OK TO COVER ALL WORK

DATE SYSTEM APPROVED 7-19-85

INSPECTOR S. Allen