

\*\*\*\*\*  
 WATER WELL ABANDONMENT-SEALING REPORT FORM  
 \*\*\*\*\*

SUBMIT COPIES OF COMPLETED FORM TO:

- \* COUNTY ENVIRONMENT AGENCY (contact MDE, WMA if address needed)
- \* WELL OWNER
- \* MDE, WATER MANAGEMENT ADMINISTRATION, WELL PROGRAM

OK  
 8/1/16 SC

DATE WELL ABANDONED: March 17 2011 (month/day/year)

\* PERMIT NUMBER OF ABANDONED WELL (if any)

HO - 73 - 2455  
 - -

\* PERMIT NUMBER OF REPLACEMENT WELL

\* PERSON ABANDONING WELL: Ralph E Mayne


WELL DRILLERS LICENSE NUMBER: 117

\* OWNER'S NAME: Land Design Development

CIRCLE: MWD (MSD) (MGD)

SITE LOCATION MAP

\* WELL LOCATION: Howard  
 COUNTY: Howard  
 NEAREST TOWN: Ellicott City  
 TAX MAP \_\_\_\_\_ BLOCK \_\_\_\_\_ PARCEL \_\_\_\_\_  
 SUBDIVISION: N/A  
 SECTION: \_\_\_\_\_ LOT: \_\_\_\_\_  
 NEAREST ROAD: 5301 Landing Rd  
Ellicott City MD

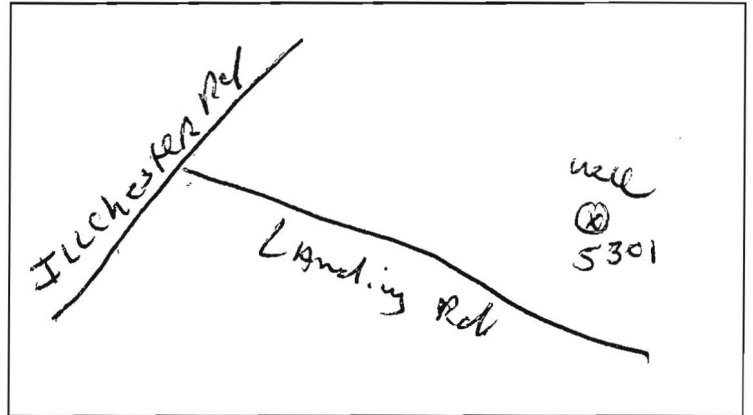

\* TYPE OF WELL BEING ABANDONED:

- DRILLED  JETTED
- BORED/AUGERED  HAND DUG
- OTHER (specify) \_\_\_\_\_

OK

\* USE CODE:

- DOMESTIC  MUNICIPAL/PUBLIC
- IRRIGATION  INDUSTRIAL
- TEST/OBSERVATION  GEOTHERMAL

\* TYPE OF CASING:

- STEEL  PLASTIC
- CONCRETE  OTHER (specify) \_\_\_\_\_

\* SIZE OF CASING: 6" INCHES IN DIAMETER

\* DEPTH OF WELL: 225 FEET DEEP

\* WAS ANY CASING REMOVED?  YES  NO  
 if yes, length removed, in feet: \_\_\_\_\_

\* WAS CASING RIPPED OR PERFORATED?  YES  NO

Ralph E Mayne

LOG OF SEALING MATERIAL

MATERIAL	FEET	
	FROM	TO
<u>Cement</u> <u>OK</u>	<u>225</u>	<u>0</u>
VOLUME OF MATERIAL USED		
<u>60 BAGS</u>		

SIGNATURE-MASTER WELL DRILLER OR SUPERVISING SANITARIAN

LICENSE # 117

CIRCLE ONE MWD (MSD) (MGD) March 17 2011 DATE

