

B 1 2043

SEQUENCE NO. (DP USE ONLY)

STATE OF MARYLAND PERMIT TO DRILL WELL

STATE PERMIT NUMBER

HO-88-1078

please print or type

fill in this form completely

Date Received (APA)

OWNER INFORMATION

CVS-BULLIERS, PO BOX 1710, ELLICOTT CITY MD 21114

B 3

LOCATION OF WELL


HOWARD COUNTY, WELLINGTON SUBDIVISION, SECTION 44, LOT 46, GLENWOOD NEAREST TOWN, 1/2 MILES FROM TOWN

DRILLER INFORMATION

Joseph H. Mayne, 238 License No. 89, 5512 Ridge Rd, Mt. Airy, Md. 21771, 10/11/89

B 4

DIRECTION OF WELL FROM TOWN (CIRCLE BOX)

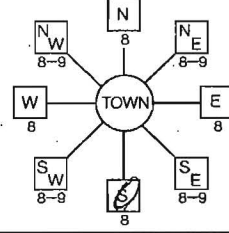

Longfield Road NEAR WHAT ROAD

ON WHICH SIDE OF ROAD (CIRCLE APPROPRIATE BOX)



100 DISTANCE FROM ROAD

ENTER FT or MI

B 2

WELL INFORMATION

APPROX. PUMPING RATE (GAL. PER MIN.) 5, AVERAGE DAILY QUANTITY NEEDED (GAL. PER DAY) 500

USE FOR WATER (CIRCLE APPROPRIATE BOX)

- Home (single or double household unit only), Farming, Industrial, Commercial, State and Federal Gov. Other, Public or private water company, Test, observation, monitoring.

NOT TO BE FILLED IN BY DRILLER HEALTH DEPARTMENT APPROVAL

Howard COUNTY NAME, 41145 COUNTY NO., DATE ISSUED 10/18/89, CO SIGNATURE Craig Wilbur, EXP. DATE 4/18/90, NORTH GRID 529000, EAST GRID 0791000

APPROXIMATE DEPTH OF WELL 260 FEET

APPROXIMATE DIAMETER OF WELL 6 INCH NEAREST


METHOD OF DRILLING (circle one)

BORED (or Augered), JETTED, Jetted & DRIVEN, AIR-ROTARY, AIR-PERCussion, ROTARY (Hydraulic Rotary), CABLE, REVerse-ROTary, Drive-POINT


SHOW MAJOR FEATURES OF BOX & LOCATE WELL WITH AN X

SOURCES OF DRILLING WATER

- 1. WELL, 2., 3. WRITE THE BOX NUMBER FROM THE MAP HERE

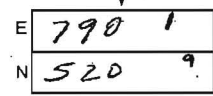

DRAW A SKETCH BELOW SHOWING LOCATION OF WELL IN RELATION TO NEARBY TOWNS AND ROADS AND GIVE DISTANCE FROM WELL TO NEAREST ROAD JUNCTION

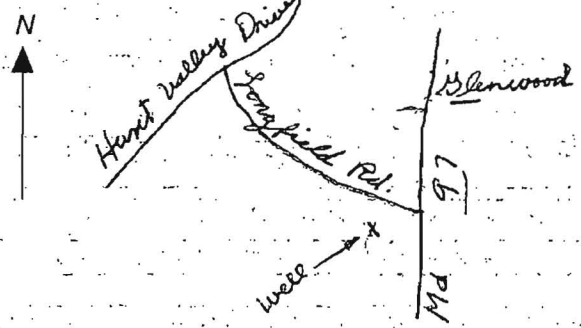

Handwritten notes: 10/26/89 9:30, already grouted, 36' casing, 31" open grout, 8 bags of cement, 3' casing above grout, OK/well built, (Tag on site) etc.

REPLACEMENT OR DEEPEMED WELLS (CIRCLE APPROPRIATE BOX)

- THIS WELL WILL NOT REPLACE AN EXISTING WELL, THIS WELL WILL REPLACE A WELL THAT WILL BE ABANDONED AND SEALED, THIS WELL WILL REPLACE A WELL THAT WILL BE USED AS A STANDBY, THIS WELL WILL DEEPEMED AN EXISTING WELL

Not to be filled in by driller (OEP USE ONLY)

APPROX. PERMIT NUMBER GAP

FORCE CW, PERMIT No. HO-88-1078

SPECIAL CONDITIONS

3/27/91 4:16 PM

Final
OK
C.B.S.

HOWARD COUNTY HEALTH DEPARTMENT
Bureau of Environmental Health
3525-H Ellicott Mills Drive
Ellicott City, MD 21043
461-9933

APPLICATION FOR PITLESS ADAPTER, WELL PUMP AND PRESSURE TANK INSTALLATION

New Installation Replacement

Receipt # 46169
Date 1-24-91

Name of Installer John M. GASKE III

Telephone 247-6963

License Number #3189

Certified Well Pump Installer Well Driller Registered Plumber

Name of Property Owner PATUXENT Building Corp. Telephone 750-0900

Subdivision Wellington Lot # 46 Well Tag # HO-88-1078

Site Address 3101 Long Field Road

Pump

- 1. Type
 - a. Deep well jet
 - b. Shallow well jet
 - c. Submersible

Motor

- 1. Horsepower 3/4
- 2. RPM
- 3. Voltage
 - a. 110
 - b. 220

Pitless Adapter

- 1. Make
- 2. Model #
- 3. Depth

- 2. Make Gould
- 3. Model #
- 4. Capacity 8 GPM

- 5. Pump exceeds well capacity Yes No
- 6. If Yes, is low pressure cutoff switch installed? Yes No
- 7. What methods are used to protect the pump and electrical wiring from vibrations? Torque arrestors Cable guards Other TAPE

Tank

- 1. Capacity WX250
- 2. Pressure relief valve? RV 50

Piping

- 1. Type Big Blue
- 2. Size 1"
- 3. NSF and/or BOCA Code approved
- 4. Depth of supply line 150"

Well data

- 1. Depth 165 ft.
- 2. Yield 15 GPM
- 3. Static water level ft.
- 4. Will water supply be disinfected by installer? NO

I understand that it is my responsibility to notify the Howard County Health Department when the installation is ready for inspection (otherwise this permit is null and void).

All information given above is true to the best of my knowledge.

Signature of Applicant: John Gaske

Date: 1-23-91


Note: A sticker indicating approval/status of the installation will be placed on the well casing at the time of the inspection.



WIGFIELD

Tim Lowan
Rowan Landscape Co.
7-9-93 Pool proposal

LOT 45
WELLINGTON
SECTION 1, AREA 1

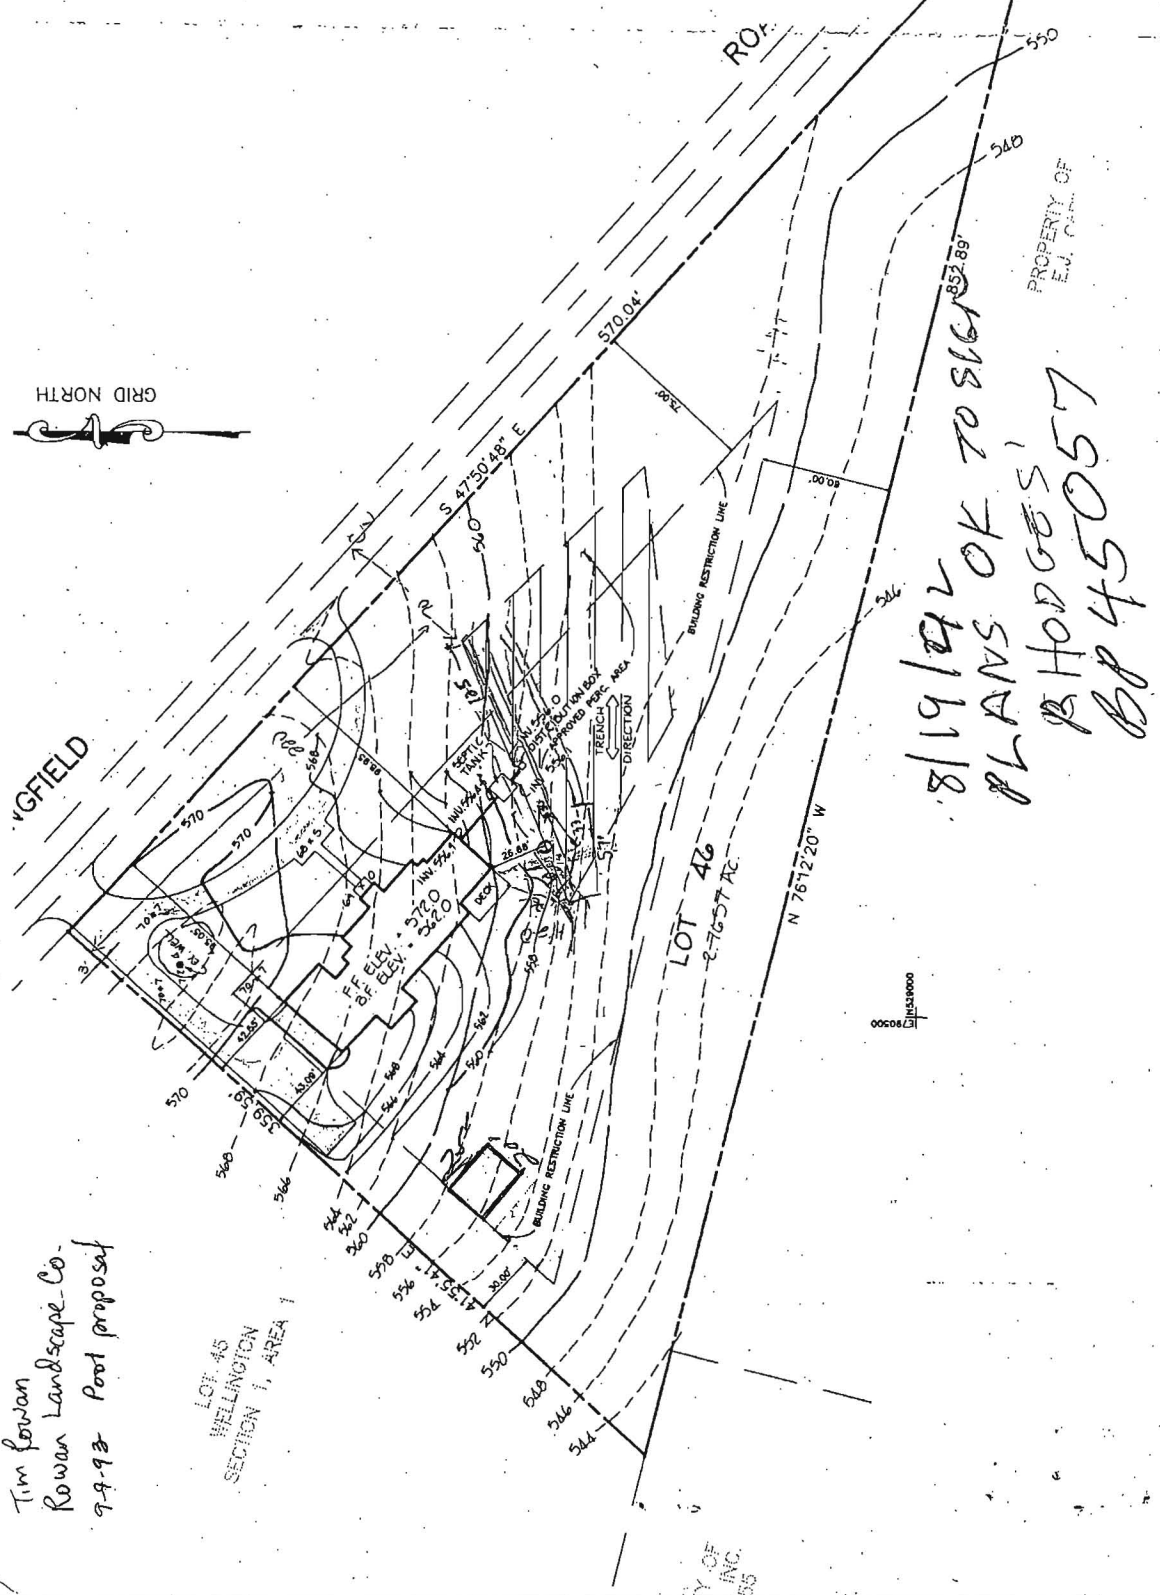

8/19/92
PLANS OK TO SIGN
B HODGES
BP 45057

PROPERTY OF
E.J. ...

1:10000

Y OF
INC.
55